



A09 Snitt

1:100

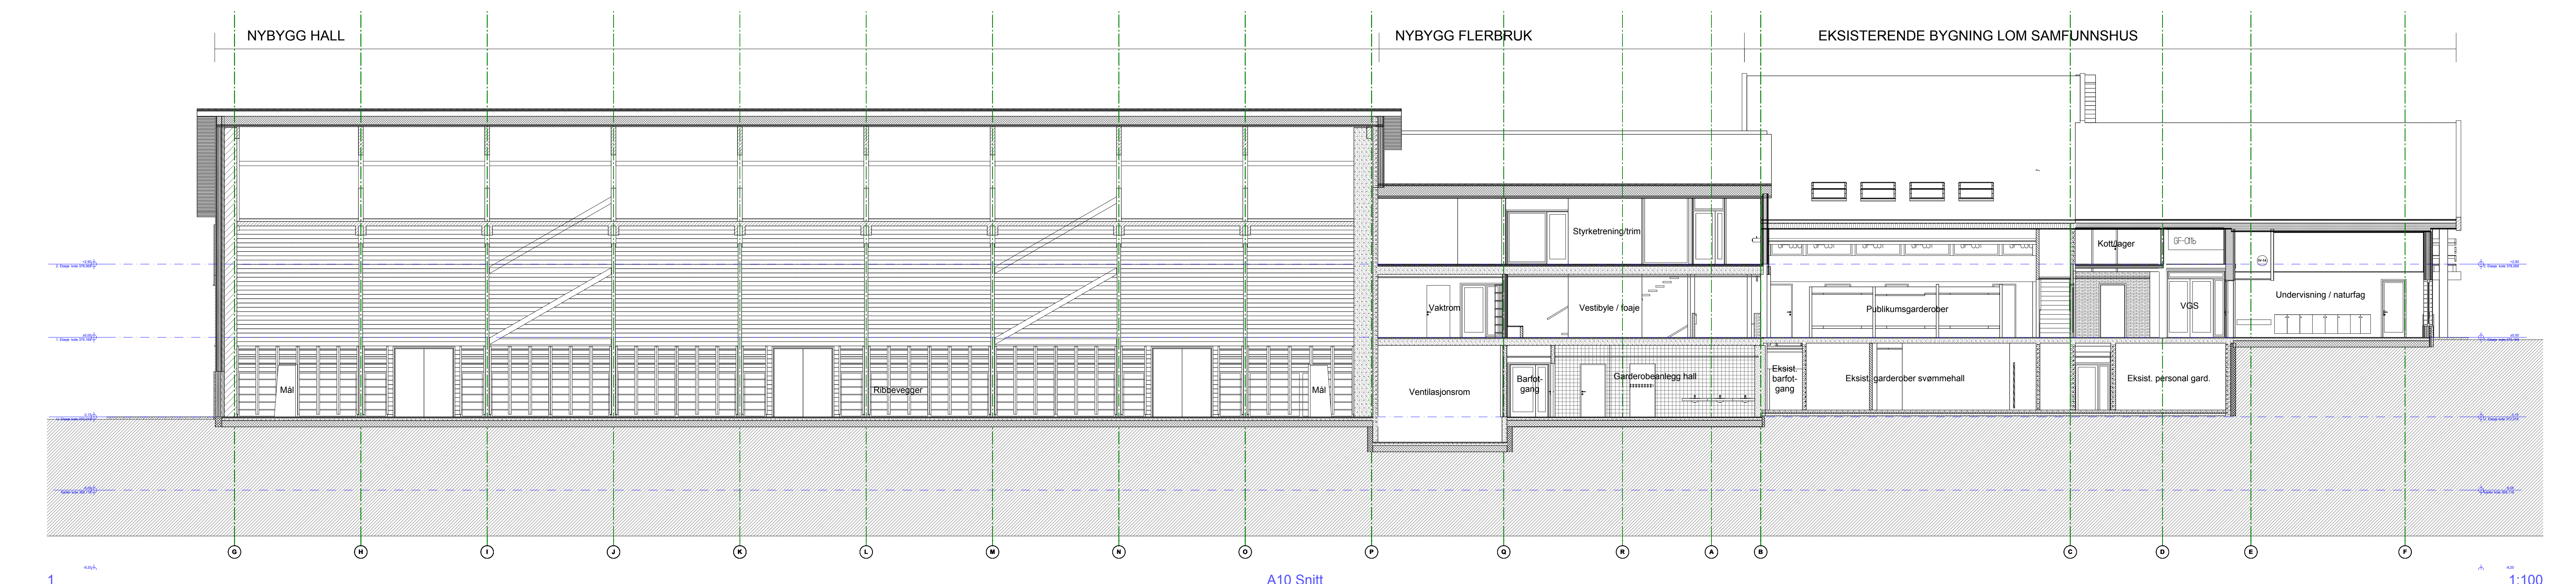

A10 Snitt

1:100

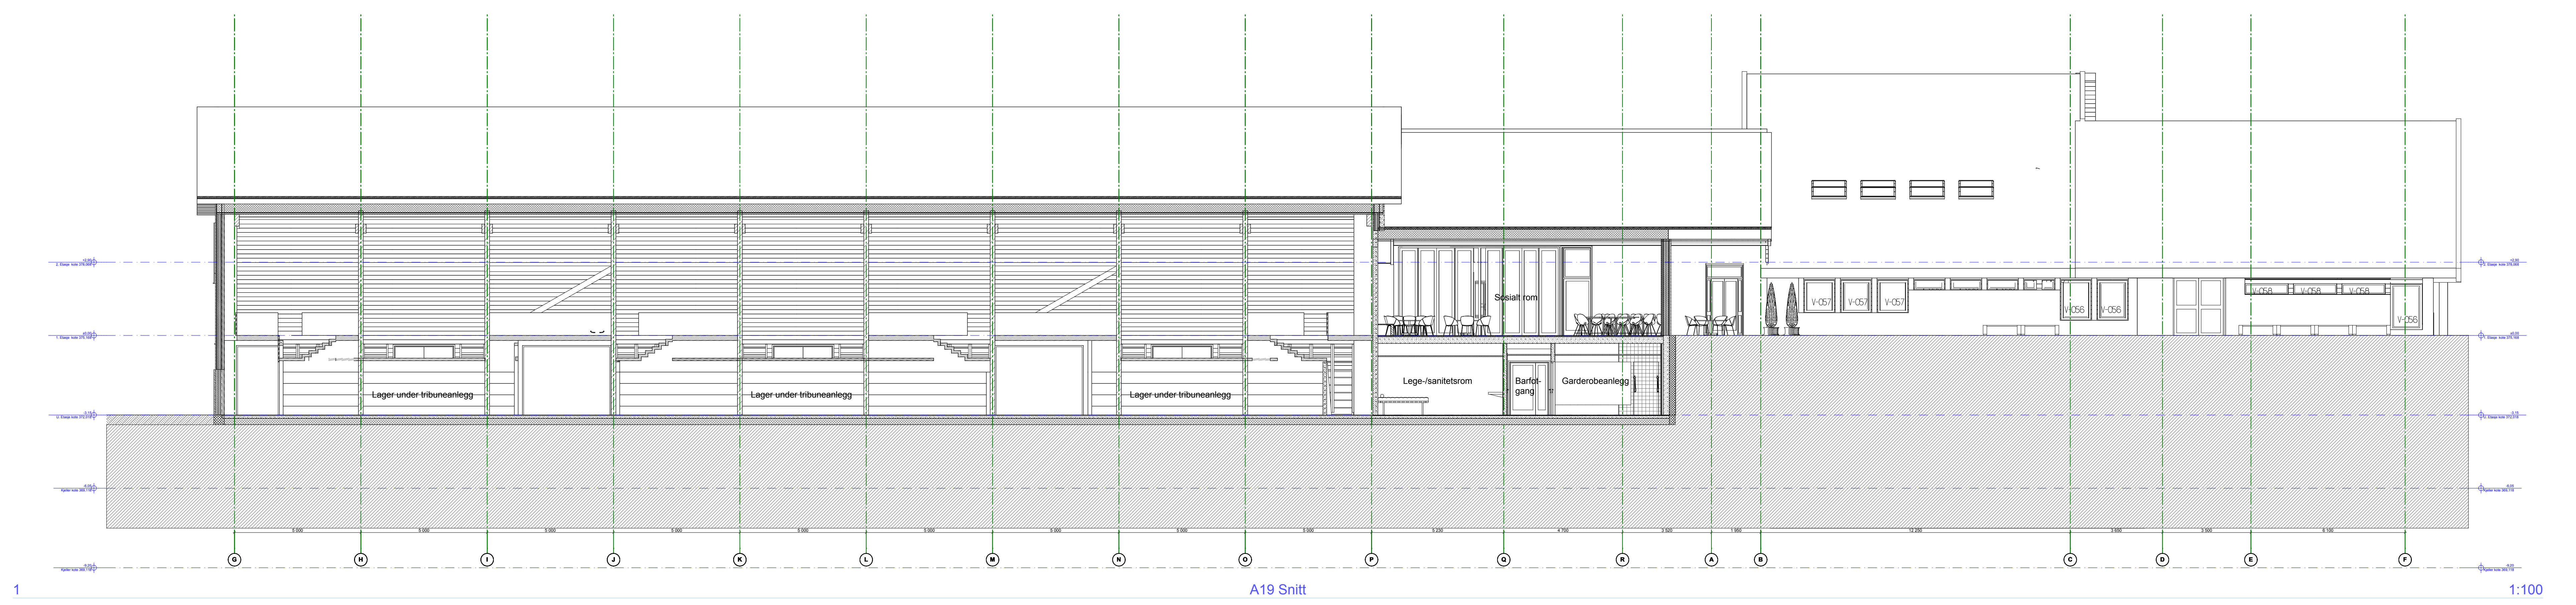

A19 Snitt

1:100

Prosjektansvarlig	ARK Arkitekt	15.10.2013	15.10.2013
Arkitekt	Rojo Arkitekter AS	15.10.2013	15.10.2013
Rådg. ing. Bygg	Multiconsult AS	15.10.2013	15.10.2013
Rådg. ing. Elektro	Norconsult AS	15.10.2013	15.10.2013
Rådg. ing. Vent.	VVS Norplan AS	15.10.2013	15.10.2013

AS-BUILT TEGNING FG5

**POJO**

Utbygger: Lom kommune  
 Prosjekt: Lom Flerbrukshus  
 Midtgård  
 Postnr. 2688 LOM

1024 AS3-105