




PLAN HOVEDETASJE

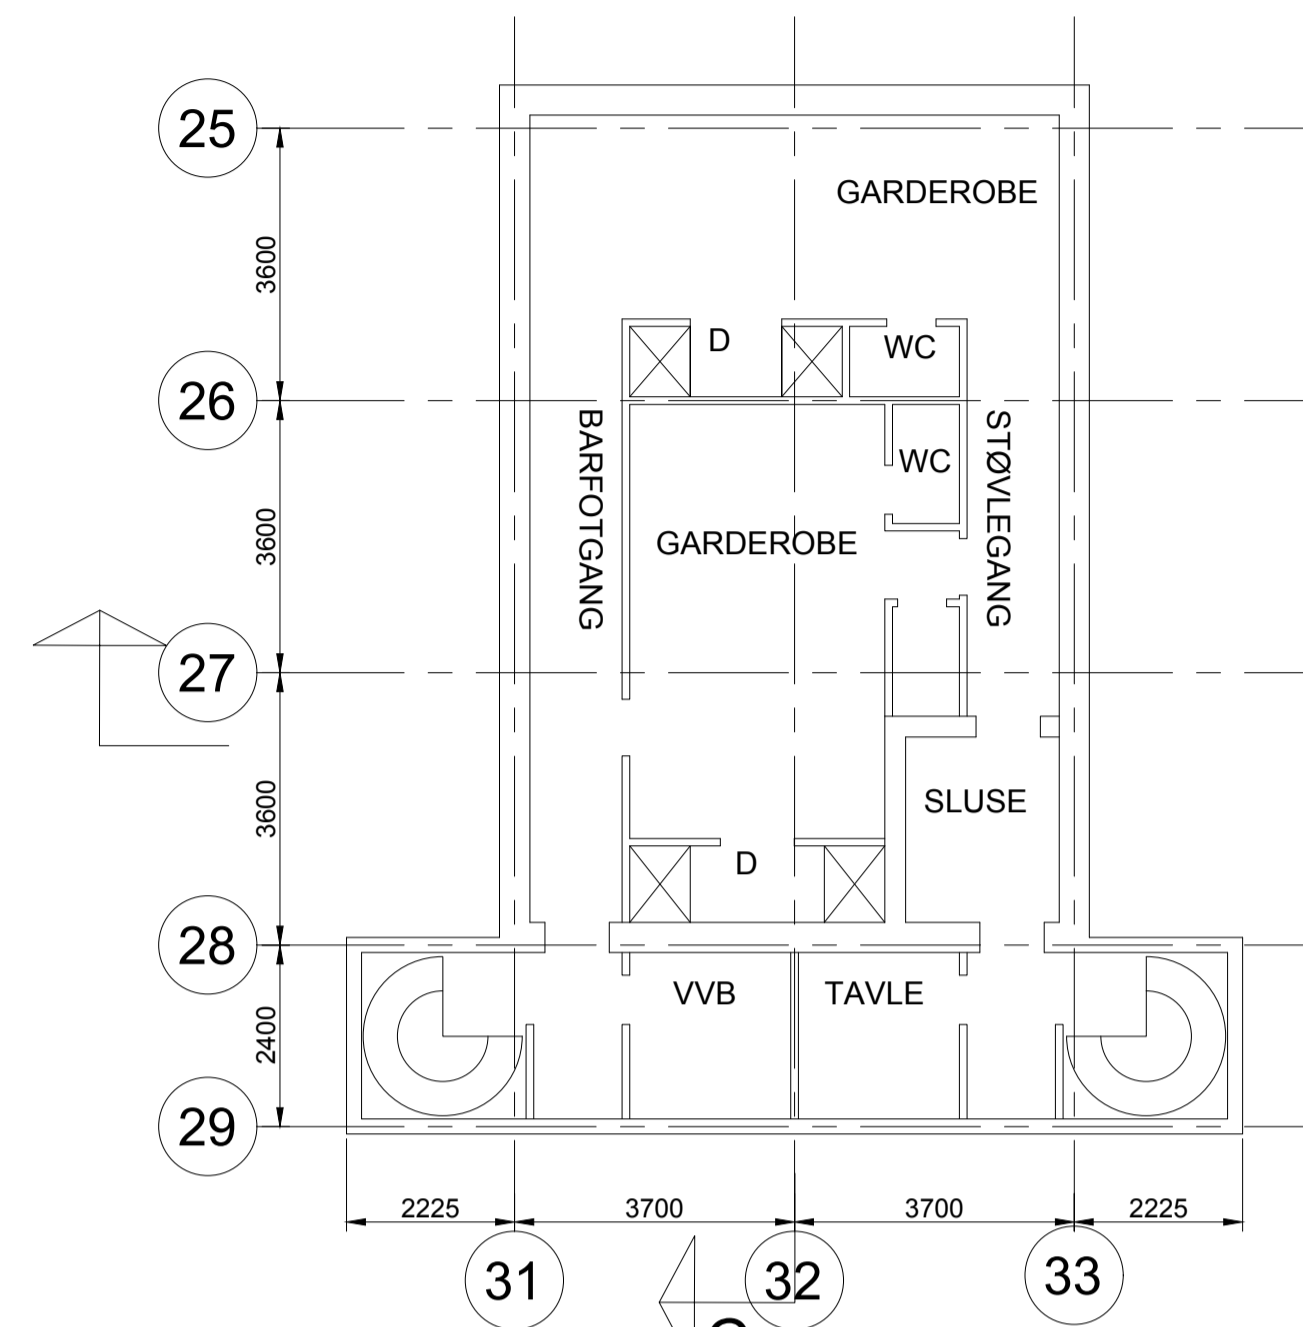

PLAN KJELLER /  
TILFLUKTSROM

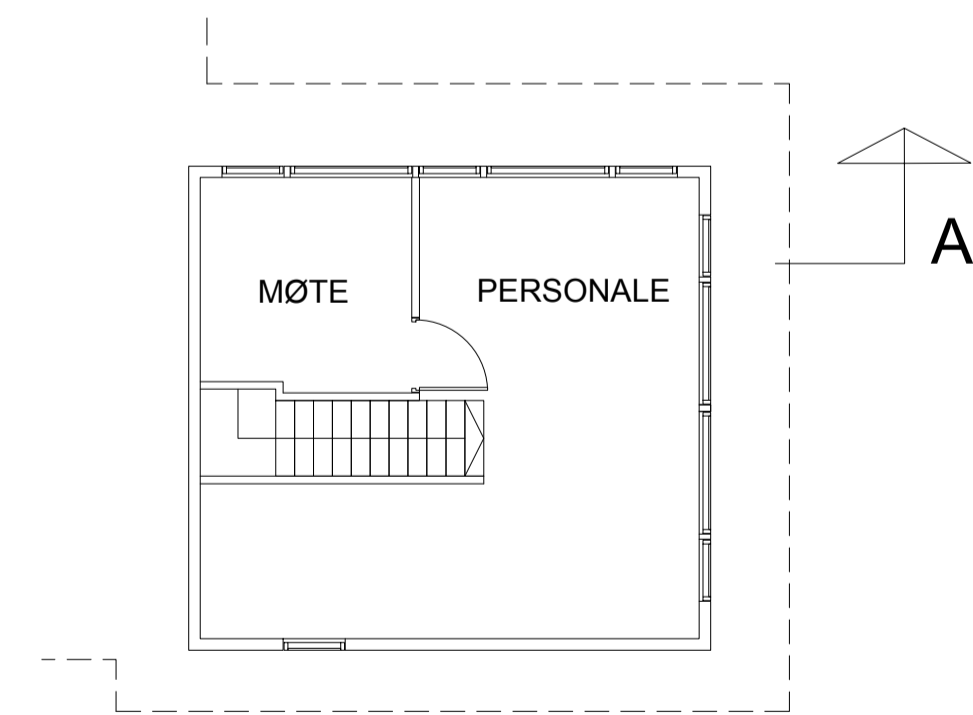

PLAN 2.ETASJE

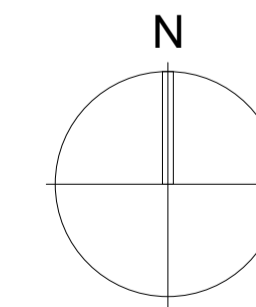

Som bygget

Vaksdal Kommune Stamnes Oppvekstun PLANER		PROSJEKT NR 2345	TEGN NR 1001	REVISJON
MÅLSTOKK 1:100/A1	REVISJON NR 15	PROSJEKT NR 2345	TEGN NR 1001	REVISJON -
DRUKT 09.02.2018	DRUKT 09.02.2018	DRUKT 09.02.2018	DRUKT 09.02.2018	DRUKT 09.02.2018
PLANNR 2345_Oppvekstun.dwg				
ARKITEKTER MNAL Forum Arkitektur AS Damsgårdveien 56 5058 Bergen TEL: 55 56 59 00 E-post: info@forumarkitektur.no				