
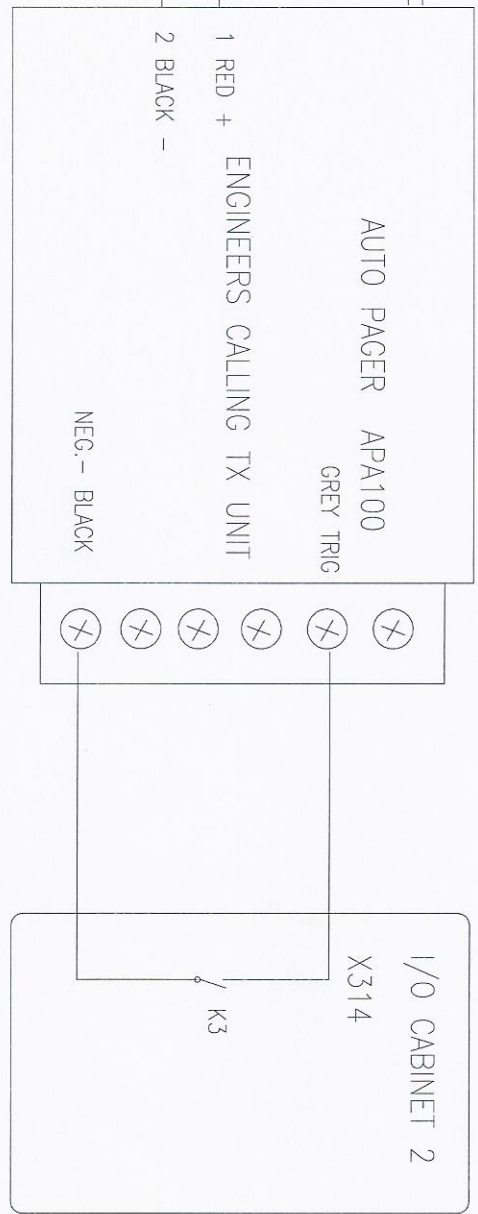


1 2 3 4 5 6 7 8 9 11 12 13 14 15

TRANSMITTER
 Current drain:
 5mA in St.by 100 mA in transmit.
 Power Requirement 12Vdc - 13.8 Vdc
 Dimentions: 100 x 85 x 32mm

ANTENNA COAX RG 58 length ca 1 m free core
 Steinco supply

12 VDC SUPPLY NOT PROVIDED BY STEINCO

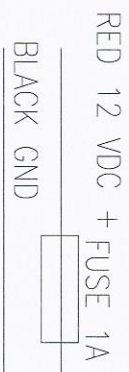

RECEIVER Pocket type
 Battery Life: App. 1 mounth based on 20 h. use per day
 Power Requirement 1.5VDC One pcs. "AA" or LR6 battery 1.5 V Alkaline Batteries
 Dimentions : 45 x 79 x19 mm

INSTALL THE TRANSMITTER PREFERABLY ON CABLE TRACK INSIDE CONSOLE BRIDGE OR ECR

REV. No.	REVISION	BY	CHK	APP	DATE	SMART Chief II FLEKKEFJORD SLIPP HULL NO. 175	TAG No.	8503	DESIGN	BY	DATE	HALVORSEN POWER SYSTEM	TITLE:	ENGINEERS ALARM	DRAWING No.	8503.1003	REV.	A1
A0	AS BUILT	LM	SEH	SEH	29.01.05				JKT	JKT	01.10.05			(A3)	NTS			
A1	New dwg frame	MO	TN	TN	12.05.16	FLEKKEFJORD SLIPP			RL	HOL	29.12.05							
									APPROVED		06.01.06							