


= Arkcol. sjøtettinger

= Landbruk

= Hage, veg, utmark

S. 2. 2019.
BAG.

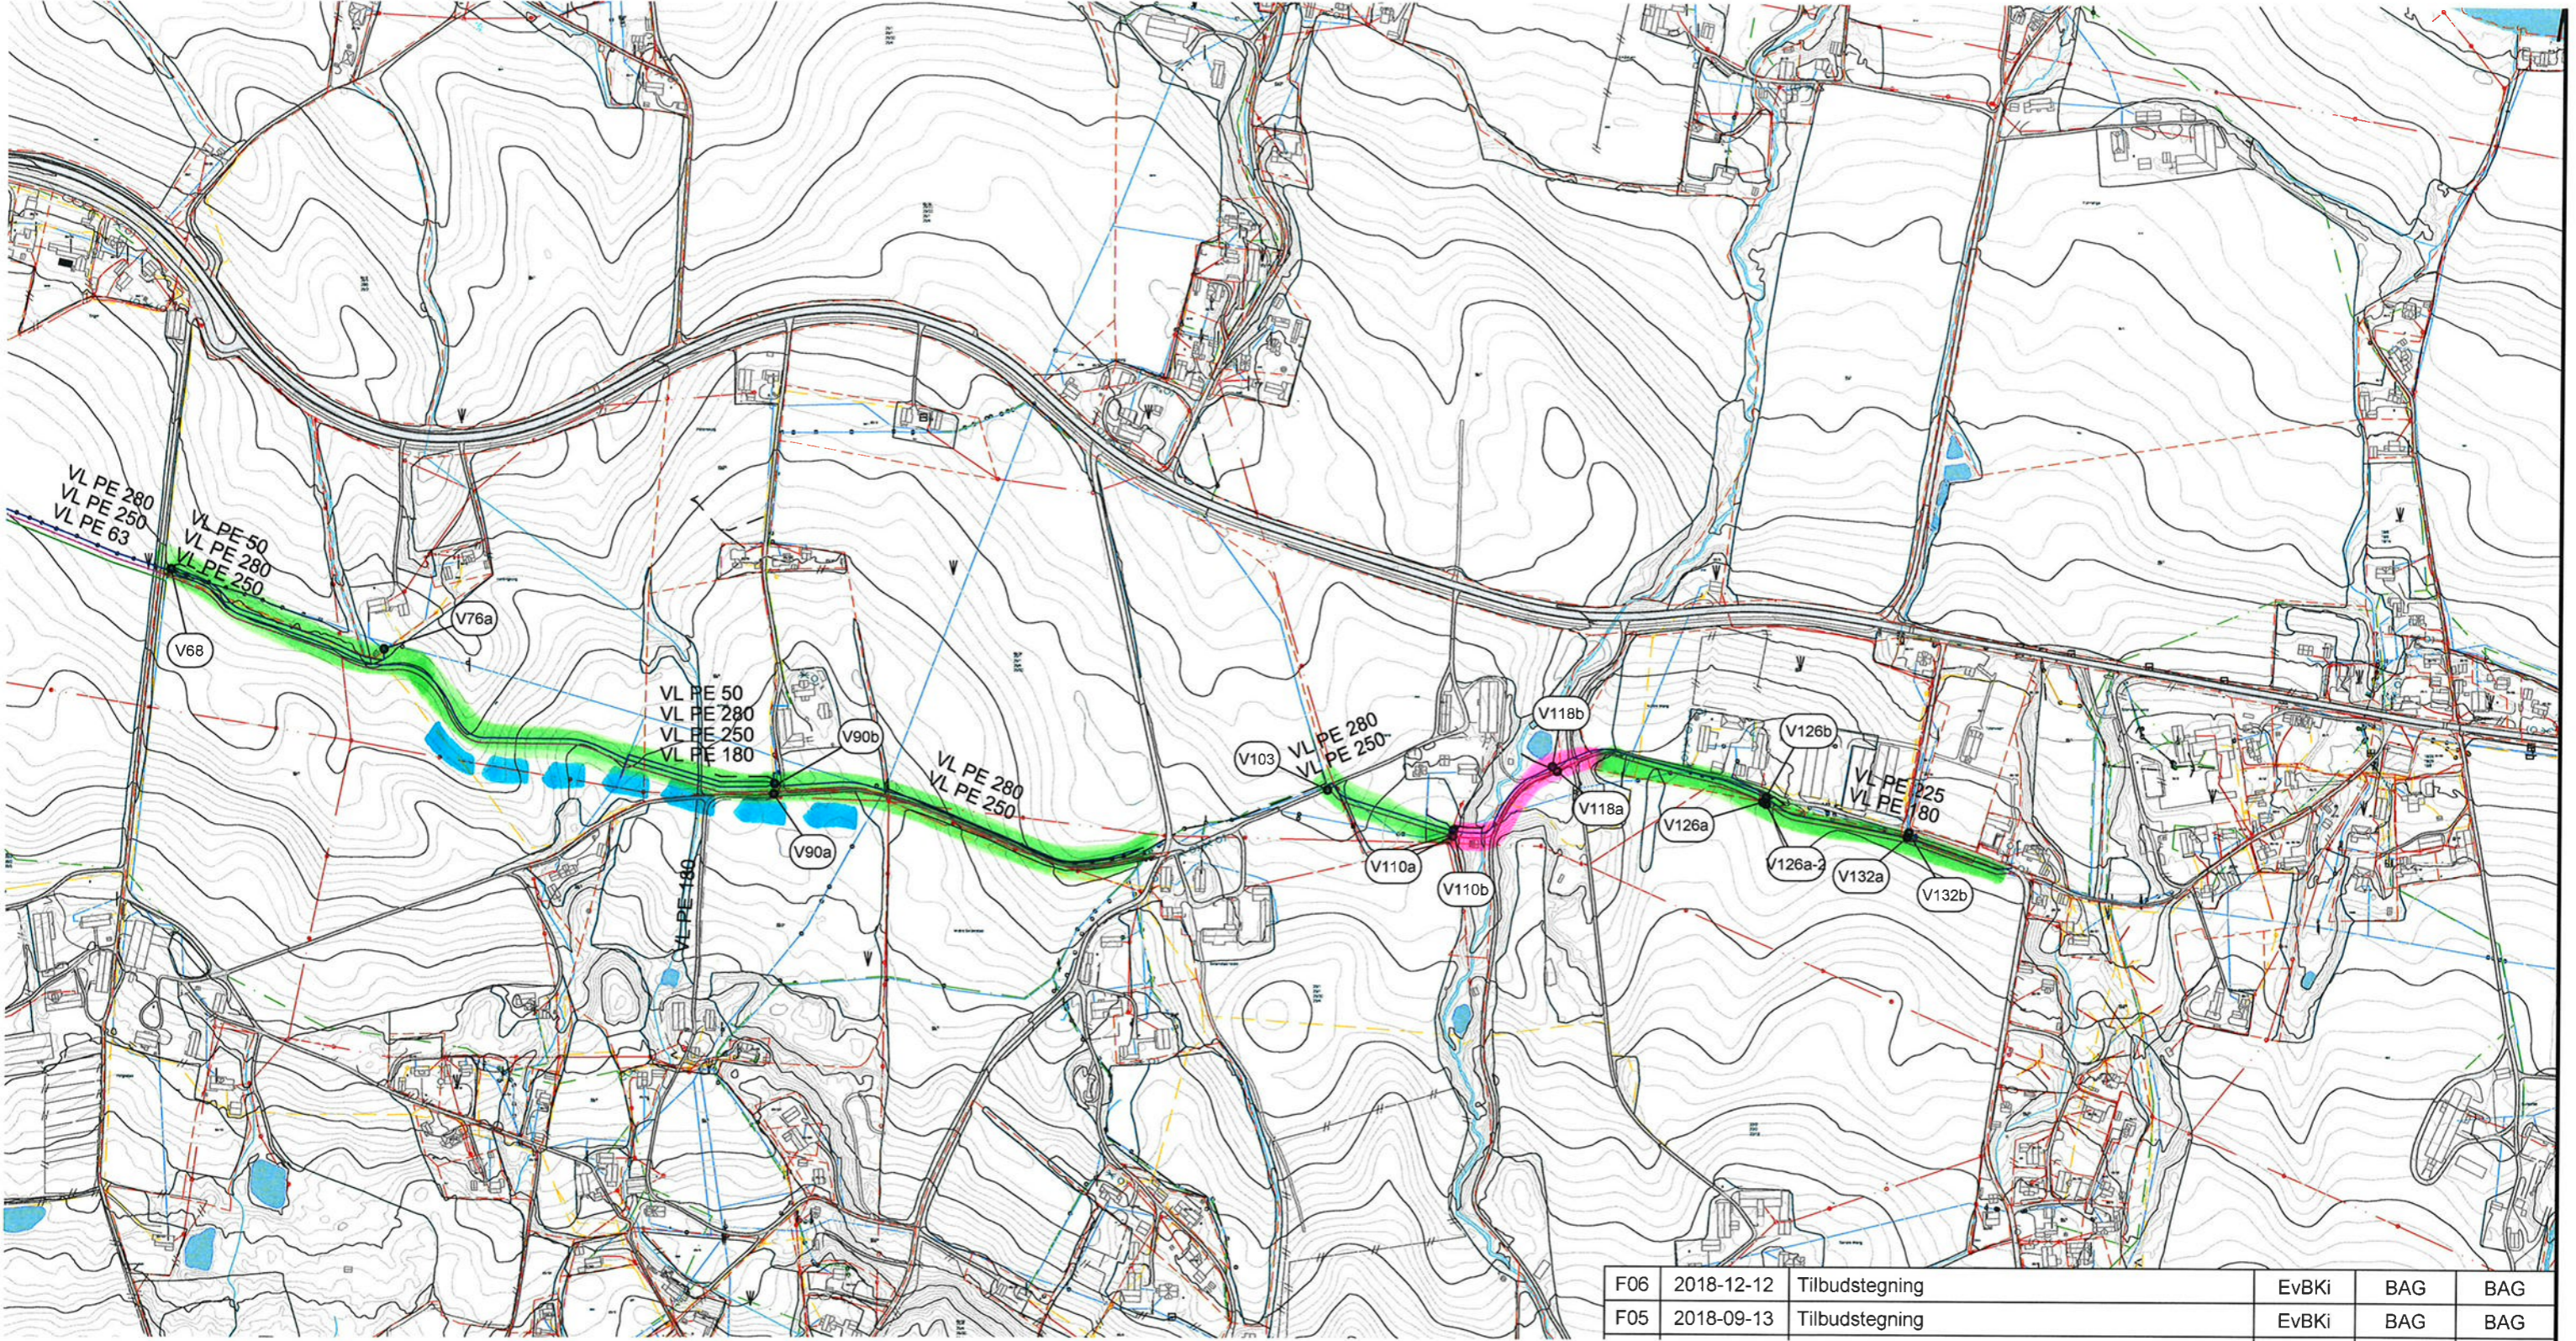

F06	2018-12-12	Tilbudstegning	EvBKi	BAG	BAG
F05	2018-09-13	Tilbudstegning	EvBKi	BAG	BAG

■ ■ = Arkeol. sjøtninger
■ = Landbruks
■ = Hage, veg, utmark

S. 2. 2019.
BAG.