


M=1:50

Ormäsön Kunstgress

M=1:50

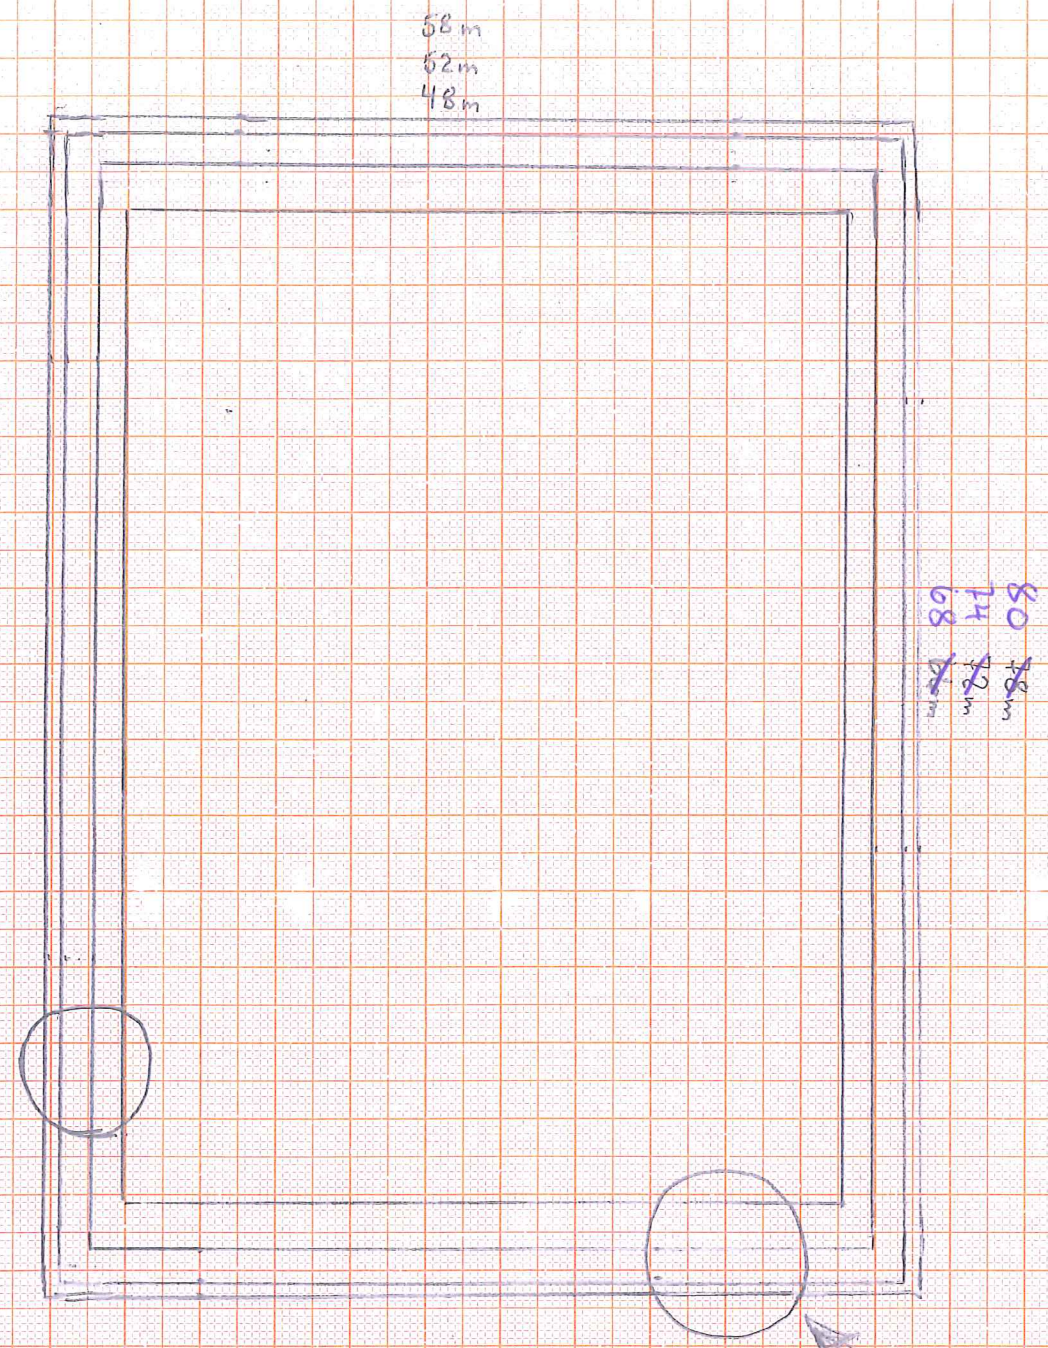

Spilleflak = $48 \times 66\text{m}$
 Kunstgress = $52 \times 72\text{m}$
 Utvendigemål inkl. 2m asfalt og 1m kerestrand (drainage) = $58 \times 78\text{m}$

