

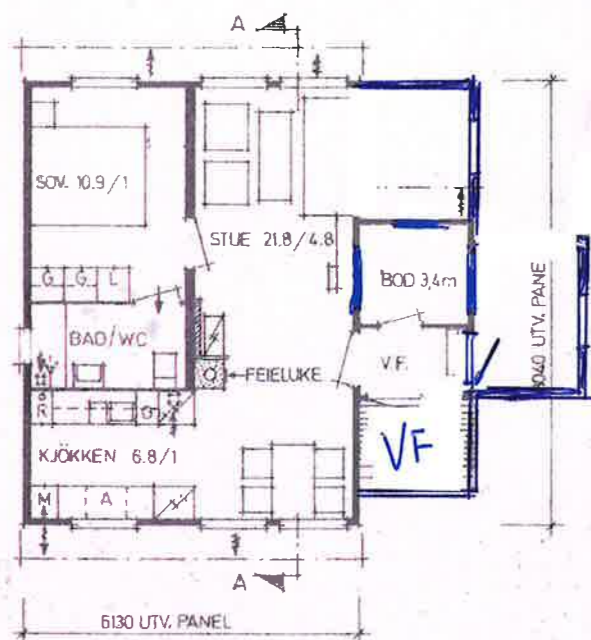
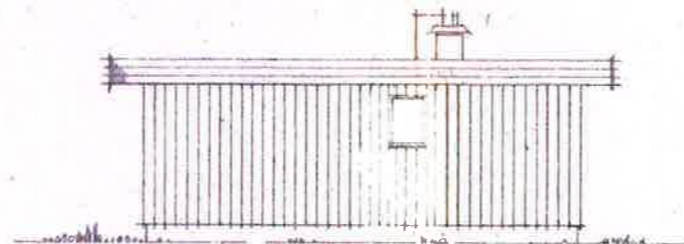


SNITT A-A

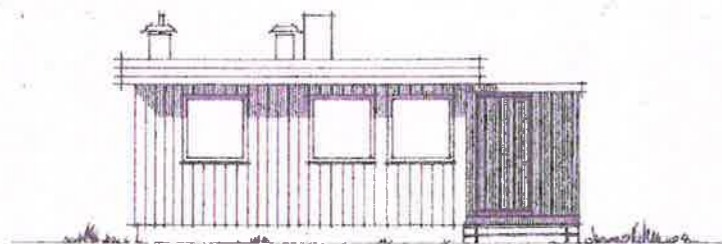


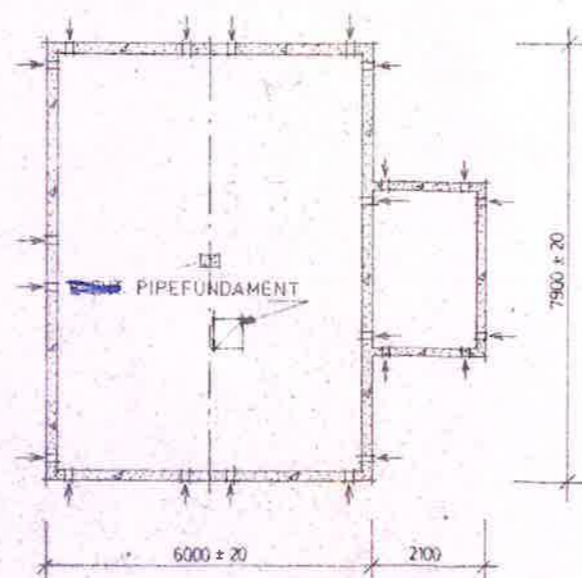

FUNDAMENTPLAN

Godkjent den 20. april 1971

FREI BYGNINGSRÅD

*Winkel*

BYGNINGSTEKNIKER  
 BEBYTTET AV ANDRE.

<b>079 - 70.</b>		
(HUSBANKENS REG. NR.)		
<b>MINIBOLIG BI ÷ N</b>		
Solveig Bergem, 1827 Hobøl	MÅL	TEGN. 3.2.71. KB
Byggeplass:	1: 100	KONTR.
Gnr. brnr.		ERST.

ANMERK  
 ANSITT - GJELDER - BRITTO