



12 11 10 9 8 7 6 5 4 3 2 1

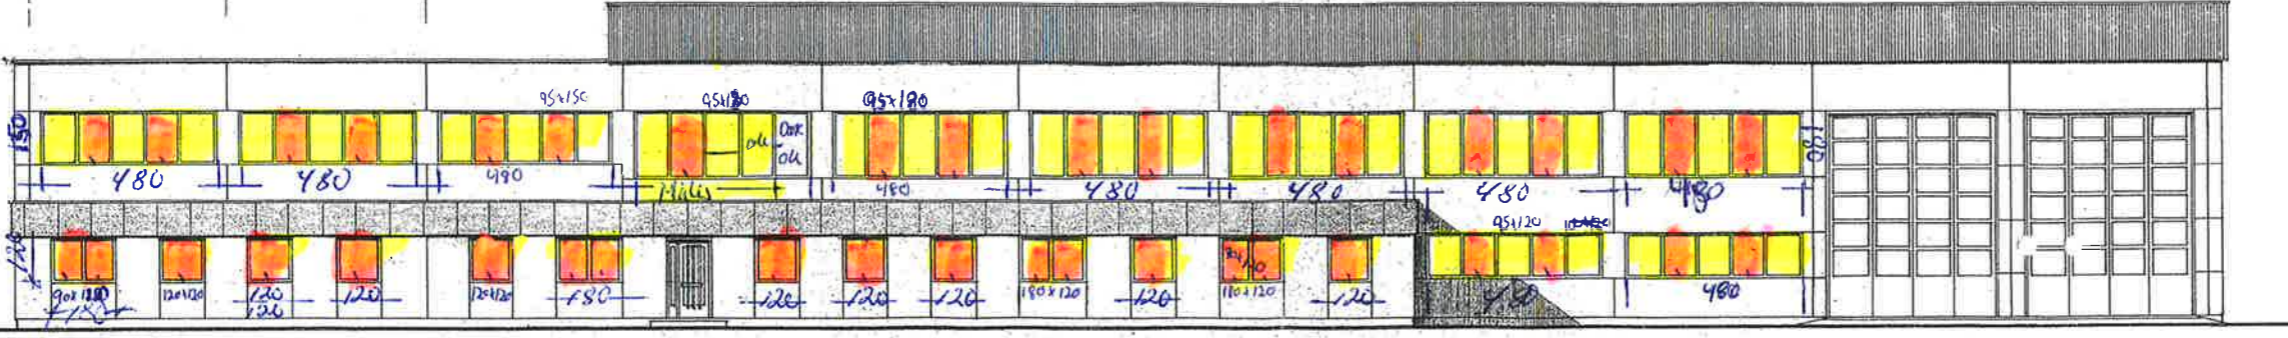


FASADE

1 2 3 4 5 6 7 8 9 10 11 12

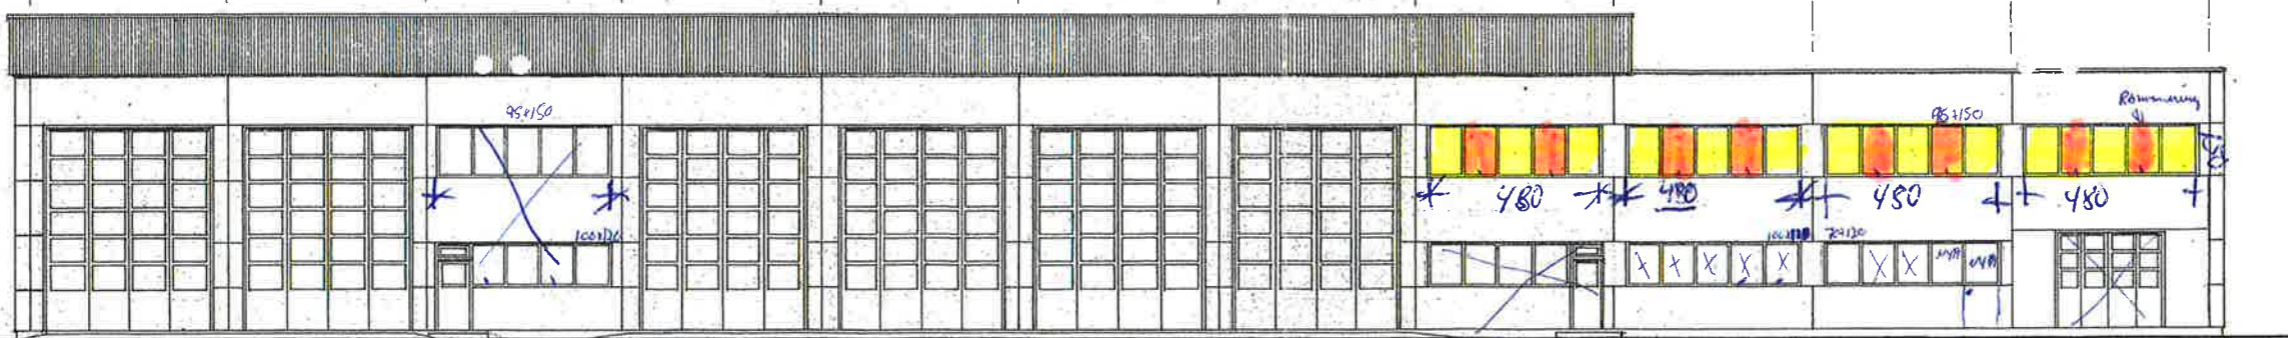


FASADE

A B C D E

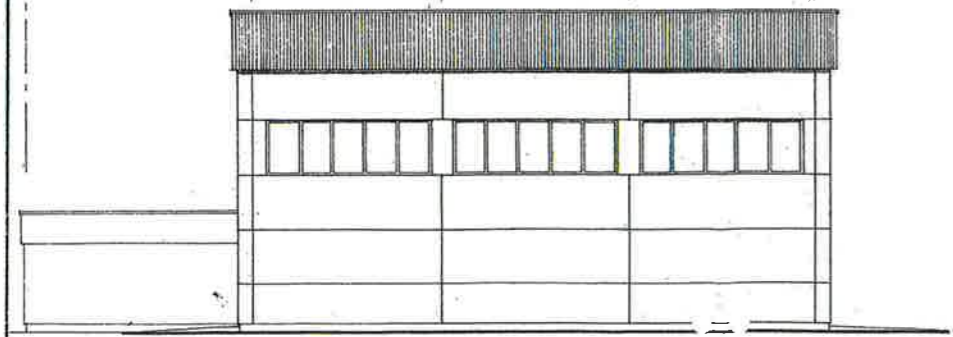

FASADE


E D C B A

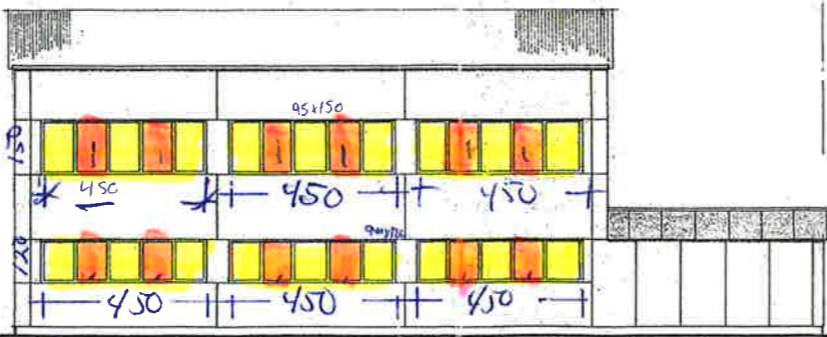

FASADE


= Öppningsbåre vinduer skiftes
 = Vinduer skiftes fastkarm

E B A

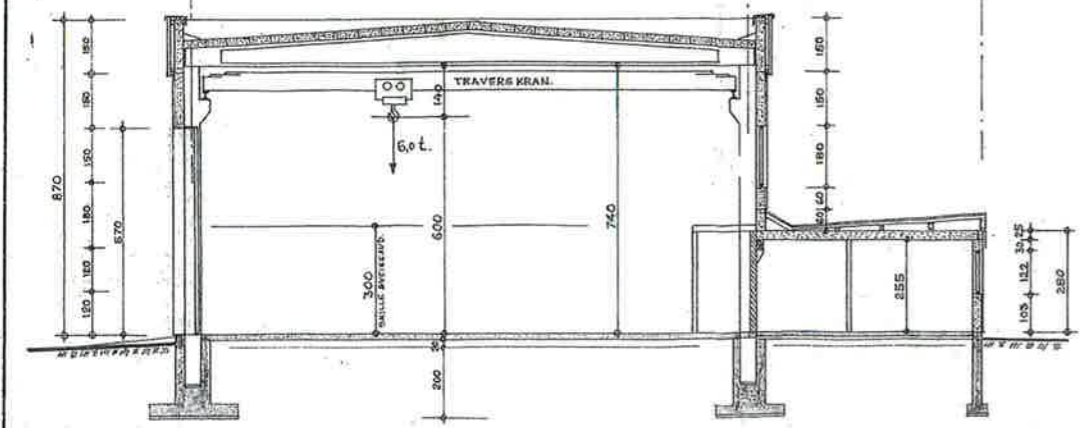

SNITT A-A

E D C B A

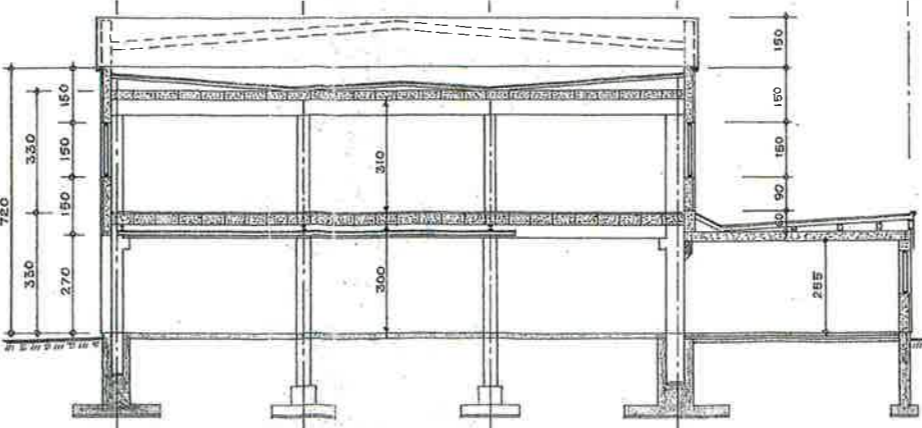

SNITT B-B

