



UGRADERT
iht sikkerhetsloven §11 og §12
jf offentliglova §13

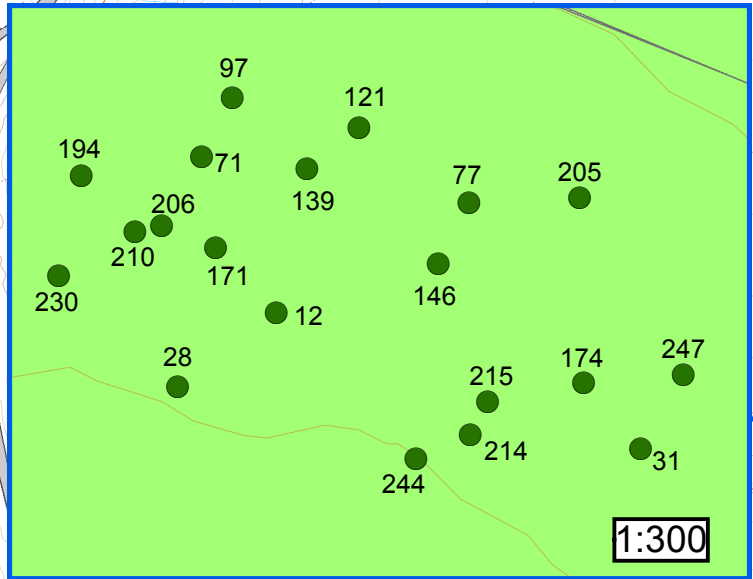

 FORSVARSBYGG

Innmålte trær i Huseby leir

(per 21.04.2019)

030107 HUSEBY
Oslo kommune
Region Viken

Grunnkart:
Norge digitalt

Miljø
sellin 25.06.2019

1:1 500

0 12,5 25
Meter

Tegnforklaring

-  Skjøtselsgrense
-  Tre

