


1 Plan fundamentering Driftsbygg
1 : 50

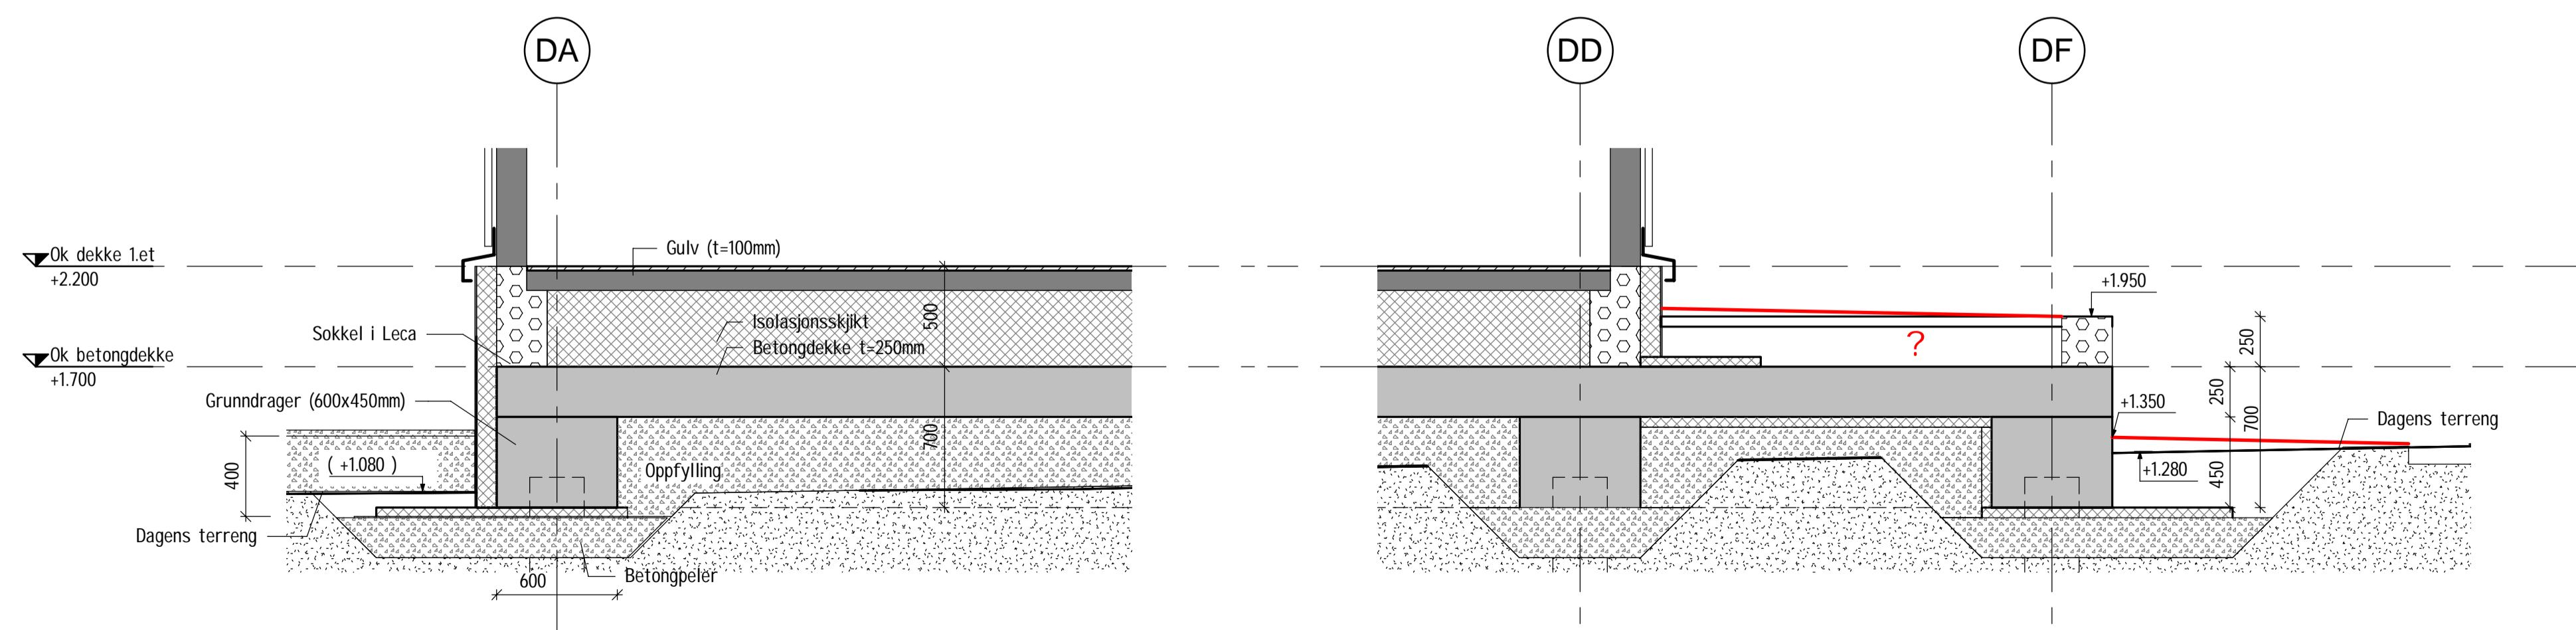

2 Typisk snitt fundament og gulv
1 : 25

HALDEN KOMMUNE / HAVN		RAMBOLL
Driftsbygg - Indre Mølen		
Doknr.	B 210 20 003	Dokument
Målestokk	1:50 (A1)	Tegn
	PRH	Dato
		08.03.2019