


ELEVATION 3
MODULE D1, D7
E0 INTRODUCTION

Pos. 2.7

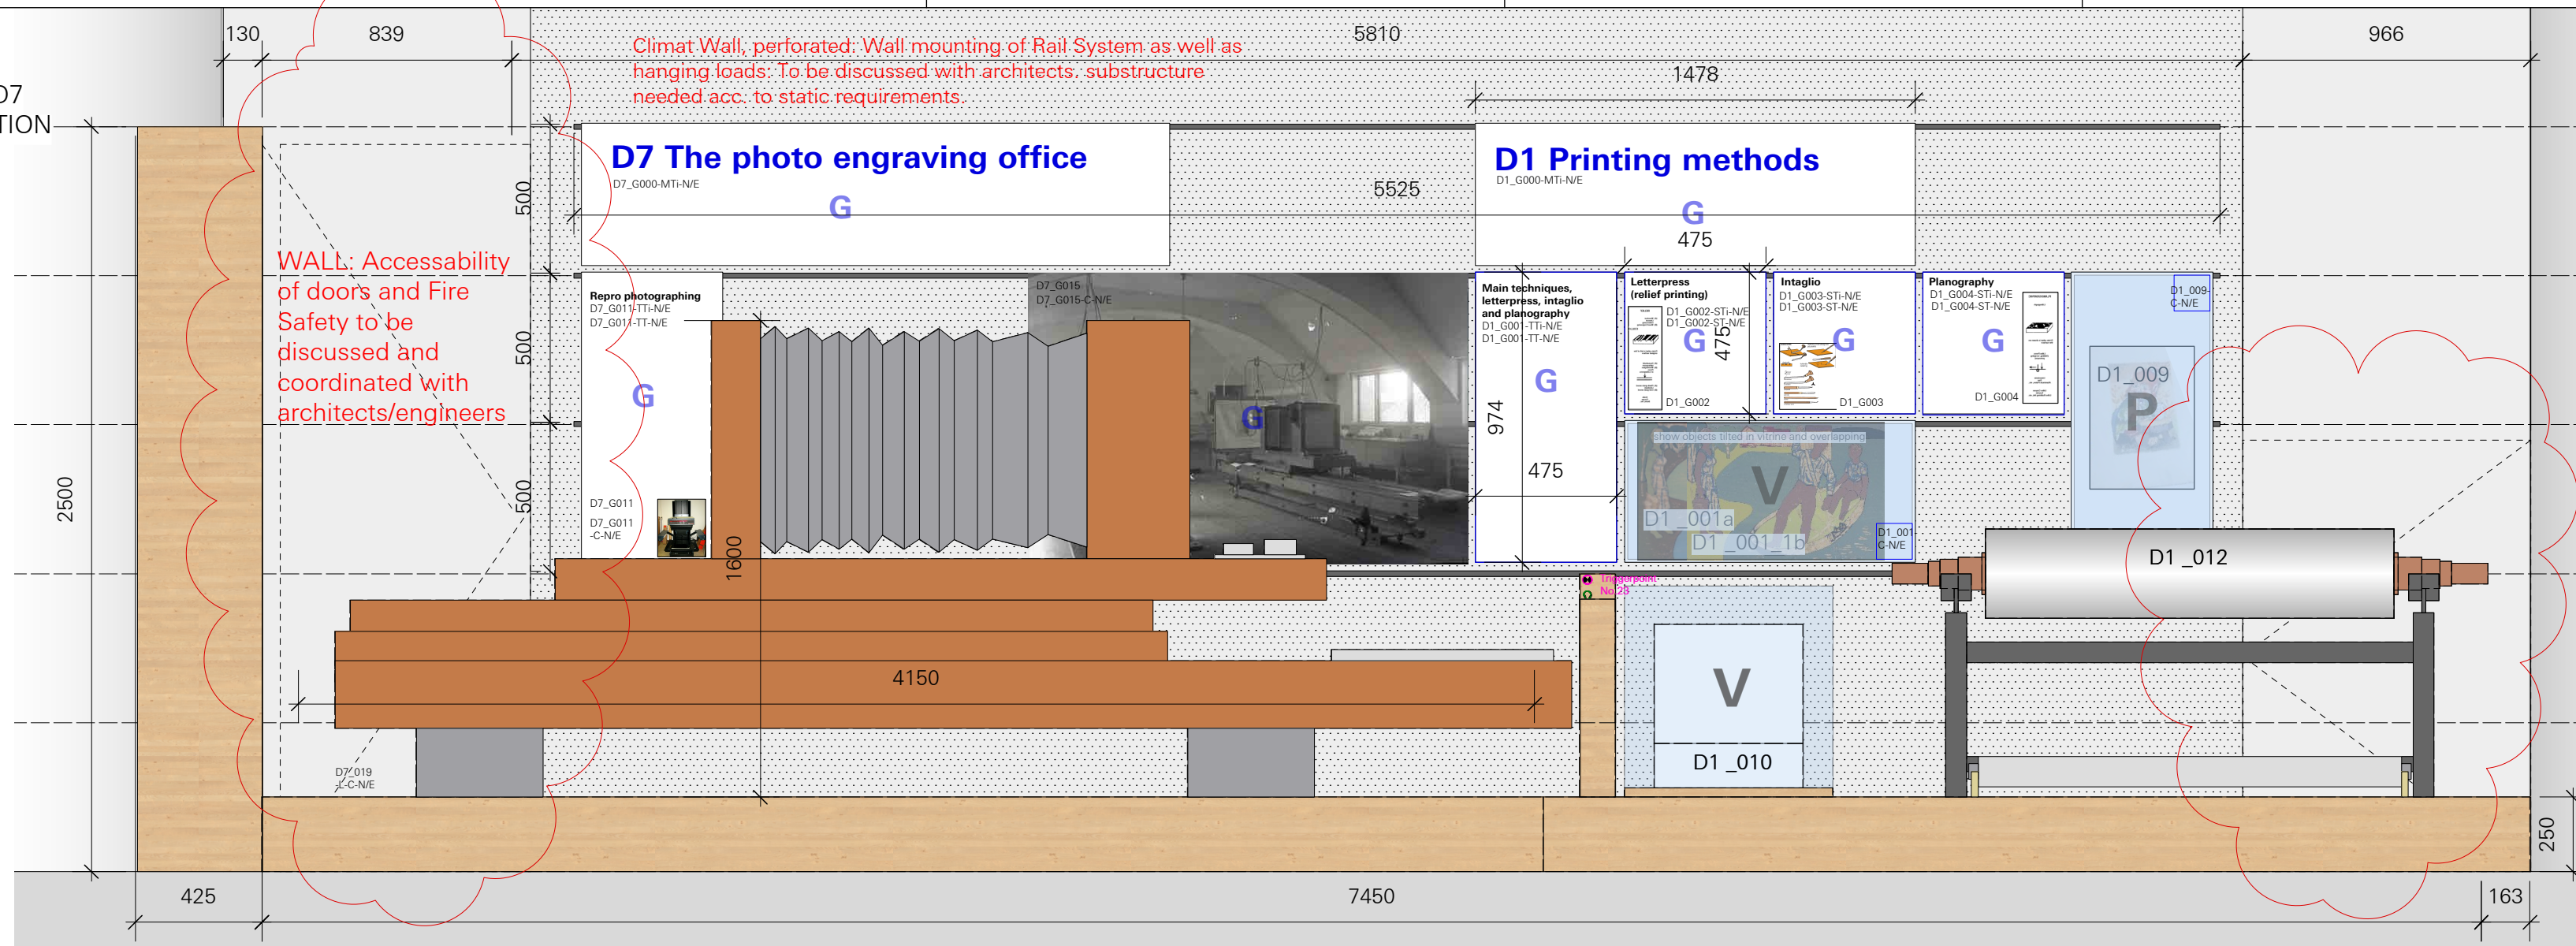

WALL: Accessibility of doors and Fire Safety to be discussed and coordinated with architects/engineers

Climat Wall, perforated: Wall mounting of Rail System as well as hanging loads: To be discussed with architects, substructure needed acc. to static requirements.

ATELIER BRÜCKNER
ARCHITECTURE
EXHIBITIONS
SCENOGRAPHY

LEGEND

SPECIALISTS

- M MEDIEN
- G GRAPHIC
- L LIGHT
- TGA BUILDING TECHNOLOGY
- EXHIBITION ATB

RELEASED



All measurements have to be revised carefully by the contractor/executor and compared with on-site situations. Differences concerning measurements or planning / stock have to be conveyed immediately to the designer. Details and drawings are only valid with annotation of approval by the designer.

MUST
MUSEUM STAVANGER

NORWEGIAN PRINTING MUSEUM
STAVANGER

ELEVATION 3
MODULE D7, D1
M 1:20

KEY PLAN

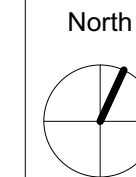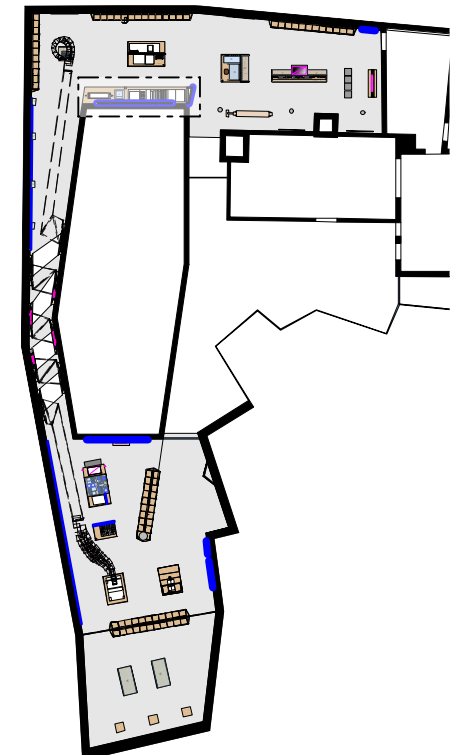

DETAIL PLAN - MODULE D
PEDESTRAL - MODULE D7/D1

client **Museum Stavanger**
Øvre Strandgate 88
4005 Stavanger I Norwegian
T. +47 40 60 17 01
www.museumstavanger.no
bitten.bakke@museumstavanger.no

planner exhibition scenography **ATELIER BRÜCKNER GMBH**
Krefelder Strasse 32
70376 Stuttgart I Germany
T. +49 711 5000 77 116
F. +49 711 5000 77 22
ngm@atelier-brueckner.com


papersize	scale	unit	sign
DIN A2	1:20	mm	sm

filename
NGM-ATB_D_1.5.3.0_01

date	code	planningphase
13.09.2019	NGM-ATB	LPH 4 - DD

type	hierarchy	no.	index
D	1.5.3.0	01	00

TOP VIEW
MODULE D7, D1
M 1:20

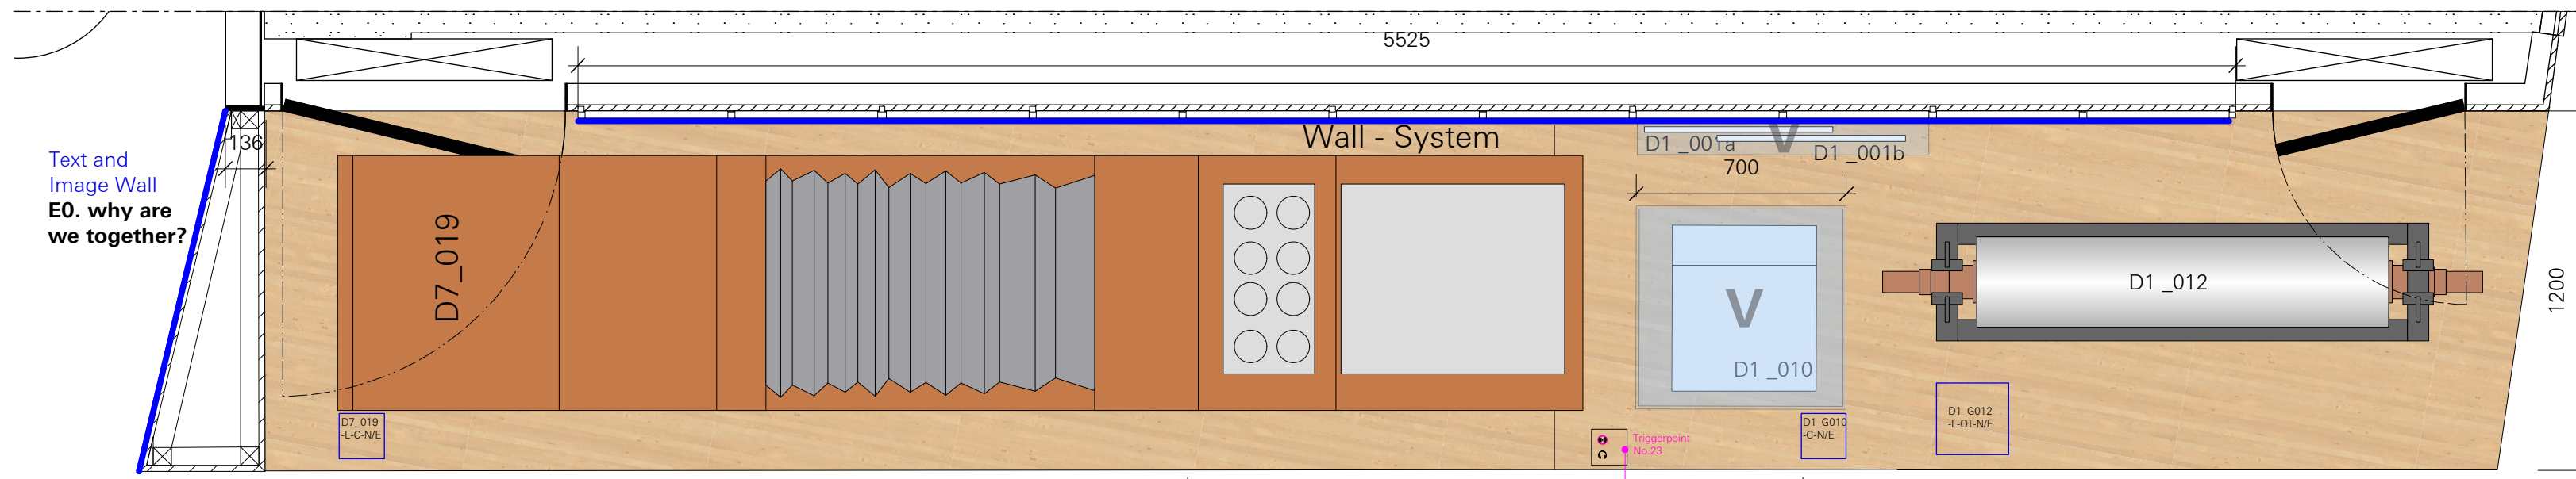

Text and Image Wall
E0. why are we together?

D7. The photo engraving office

Triggerpoint see plan:
NGM-ATB_D_1.0.1.0_03

D1. Printing Methods

E0 Introduction

Introduction
E0_G001-TI-N/E

Triggerpoint see plan:
NGM-ATB_D_1.0.1.0_03

ELEVATION 4
MODULE E0
M 1:20

