PEDESTAL DIORAMA DARKROOM
MODULE D7

Diorama Detail see plan:
NGM-ATB_D_1.5.6.0_03

Pos. 2.9

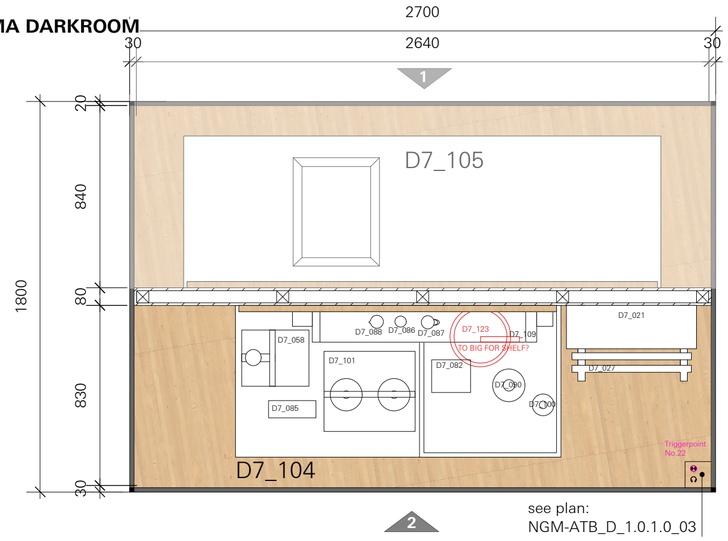

see plan:
NGM-ATB_D_1.0.1.0_03

TOP VIEW PEDESTAL - PHOTO ENGRAVING OFFICE
MODULE D7
M 1:20

PEDESTAL DIORAMA ETCHING
MODULE D7

Diorama Detail see plan:
NGM-ATB_D_1.5.6.0_03

Pos. 2.9

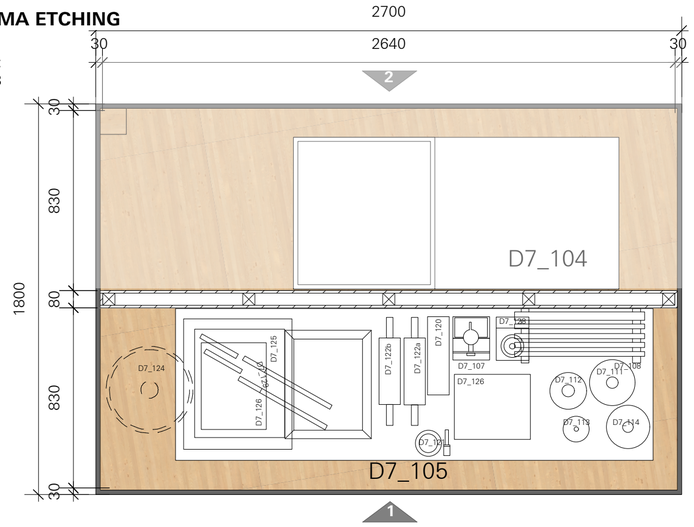

TOP VIEW PEDESTAL - PHOTO ENGRAVING OFFICE
MODULE D7
M 1:20

Please also see light planning Details!
See plan: NGM-ATB/BH_D_1.1.0.0_07

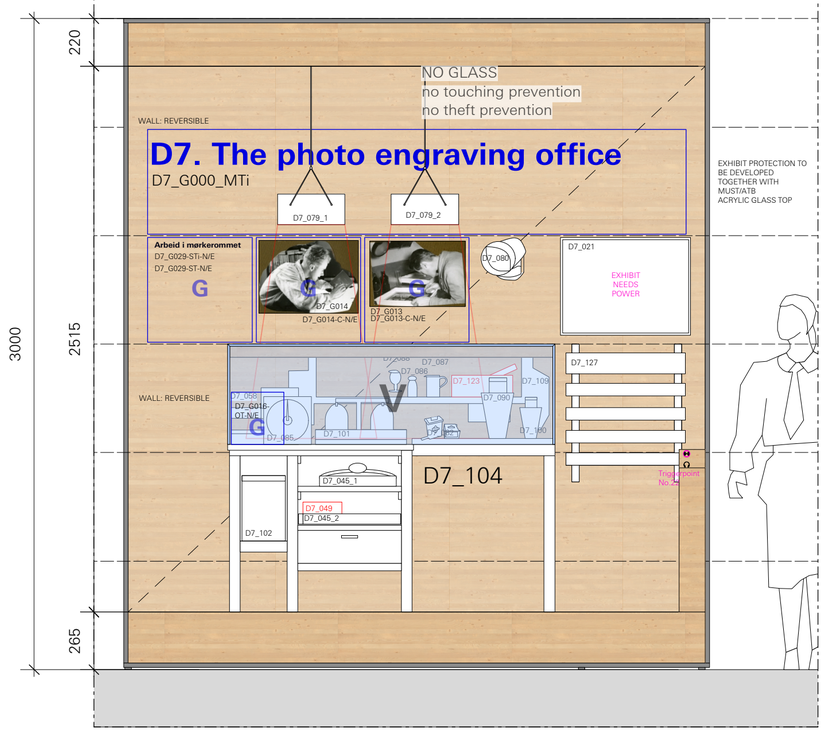

ELEVATION 2
PEDESTAL - PHOTO ENGRAVING OFFICE
MODULE D7
M 1:20

Please also see light planning Details!
See plan: NGM-ATB/BH_D_1.1.0.0_07

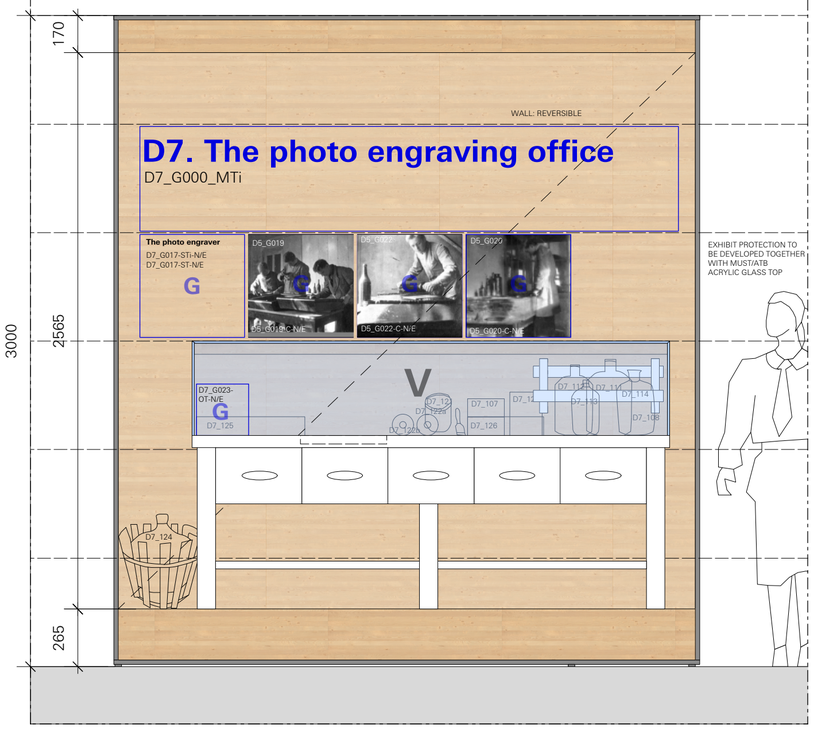

ELEVATION 1 PEDESTAL - PHOTO ENGRAVING OFFICE
MODULE D7
M 1:20

ATELIER BRÜCKNER
ARCHITECTURE
EXHIBITIONS
SCENOGRAPHY

LEGEND

SPECIALISTS

M	MEDIEN
G	GRAPHIC
L	LIGHT
TGA	BUILDING TECHNOLOGY
	EXHIBITION ATB

RELEASED

All measurements have to be revised carefully by the contractor/executor and and compared with on-site situations. Differences concerning measurements or planning / stock have to be conveyed immediately to the designer. Details and drawings are only valid with annotation of approval by the designer.

MUST
MUSEUM STAVANGER

NORWEGIAN PRINTING MUSEUM
STAVANGER

KEY PLAN

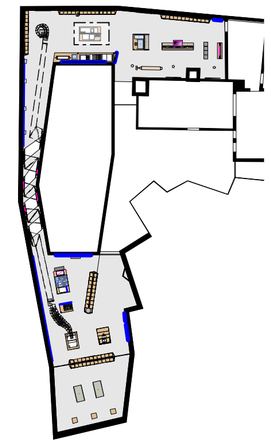

DETAIL PLAN - MODULE D
DIORAMA, PHOTO ENGRAVING OFFICE - M. D7

client
Museum Stavanger
Øvre Strandgate 88
4005 Stavanger I Norwegian
T. +47 40 60 17 01
www.museumstavanger.no
bitten.bakke@museumstavanger.no

planner exhibition szenopgraphy
ATELIER BRÜCKNER GMBH
Krefelder Strasse 32
70376 Stuttgart I Germany
T. +49 711 5000 77 116
F. +49 711 5000 77 22
ngm@atelier-brueckner.com

papersize	scale	unit	sign
DIN A1	**1:50/20**	**mm**	**sm**

filename
NGM-ATB_D_1.5.6.0_01

date	code	planningphase
13.09.2019	**NGM-ATB**	**LPH 4 - DD**

type	hierarchy	no.	index
D	**1.5.6.0**	**01**	**00**

© 2019 ATELIER BRÜCKNER