

LEGEND

SPECIALISTS

- M MEDIEN
- G GRAPHIC
- L LIGHT
- TGA BUILDING TECHNOLOGY
- EXHIBITION ATB

X = power markings



RELEASED

All measurements have to be revised carefully by the contractor/executor and compared with on-site situations. Differences concerning measurements or planning / stock have to be conveyed immediately to the designer. Details and drawings are only valid with annotation of approval by the designer.



NORWEGIAN PRINTING MUSEUM
 STAVANGER

KEY PLAN

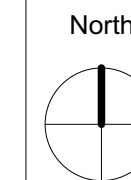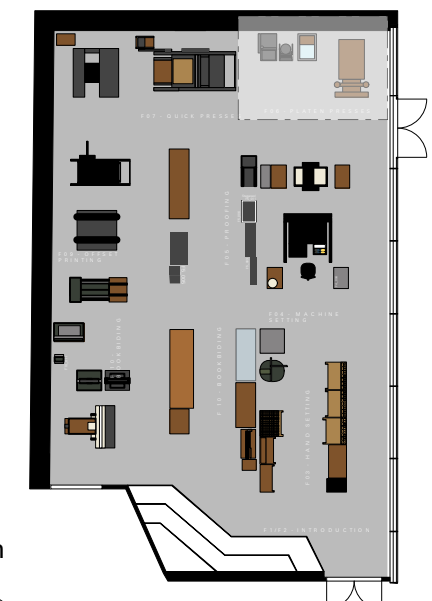

DETAIL PLAN - PRINTING WORKS
 SECOND FLOOR

client **Museum Stavanger**
 Øvre Strandgate 88
 4005 Stavanger | Norwegian
 T. +47 40 60 17 01
 www.museumstavanger.no
 bitten.bakke@museumstavanger.no


planner **ATELIER BRÜCKNER GMBH**
exhibition Krefelder Strasse 32
scenography 70376 Stuttgart | Germany
 T. +49 711 5000 77 116
 F. +49 711 5000 77 22
 ngm@atelier-brueckner.com

papersize	scale	unit	sign
DIN A2	1:25	mm	sm

filename
NGM-ATB_D_2.6.1.0_01


date	code	planningphase
13.09.2019	NGM-ATB	LPH 4 - DD

type	hierarchy	no.	index
D	2.6.1.0	01	00

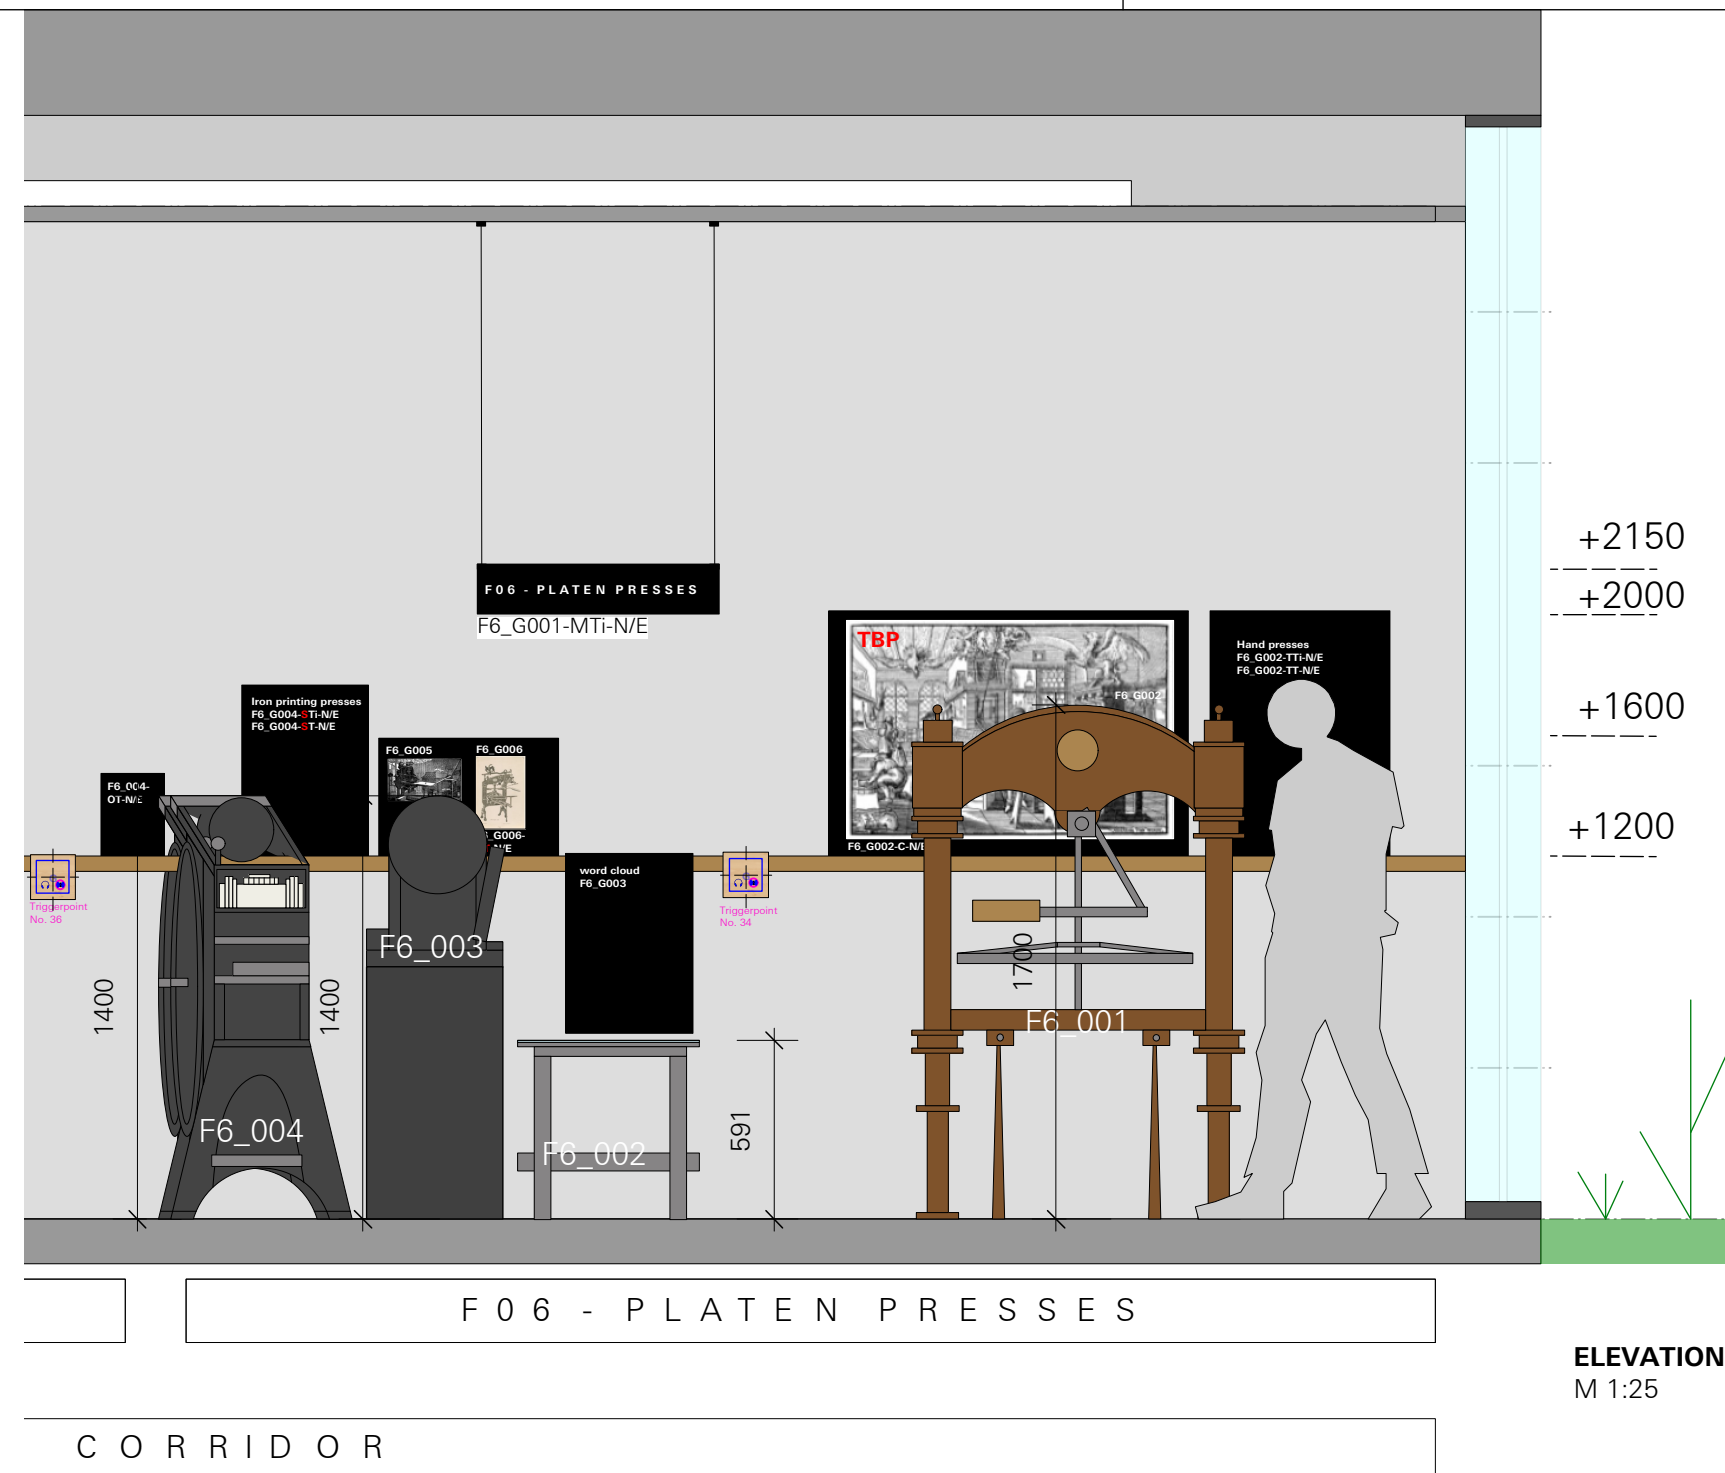


+2150
 +2000
 +1600
 +1200

ELEVATION
 M 1:25

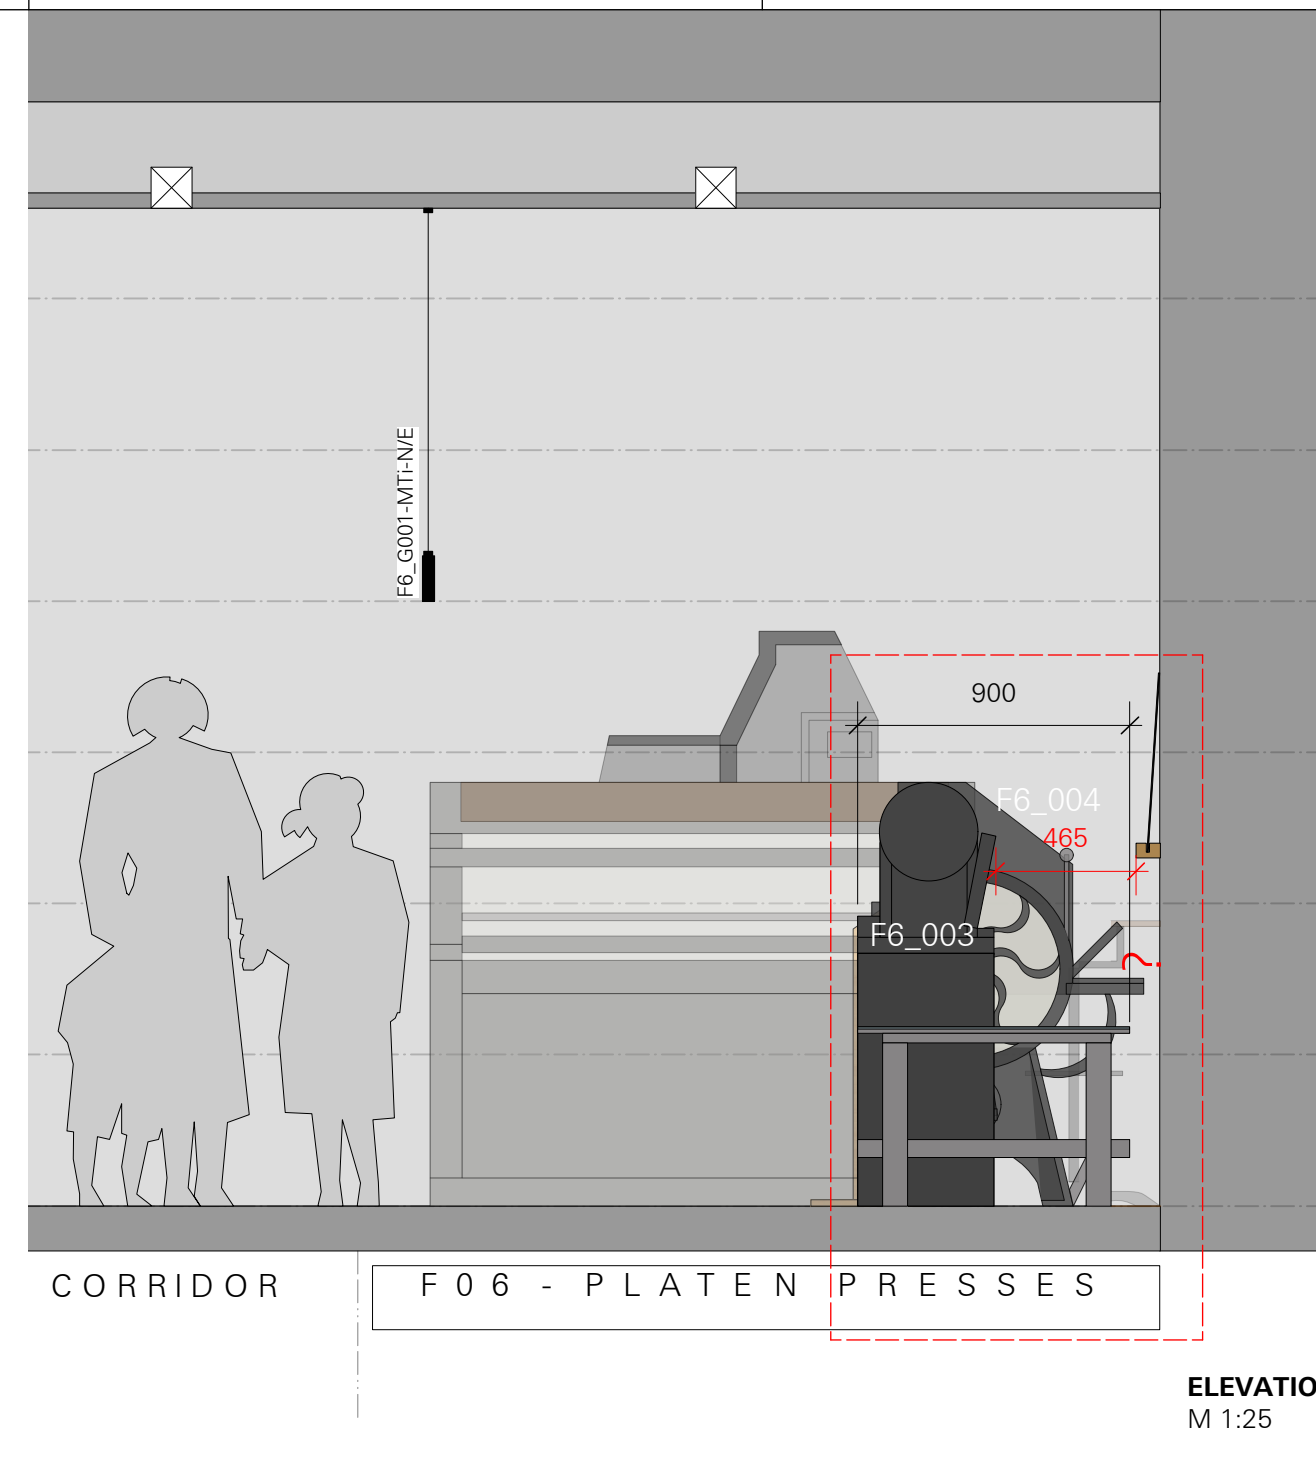

ELEVATION
 M 1:25

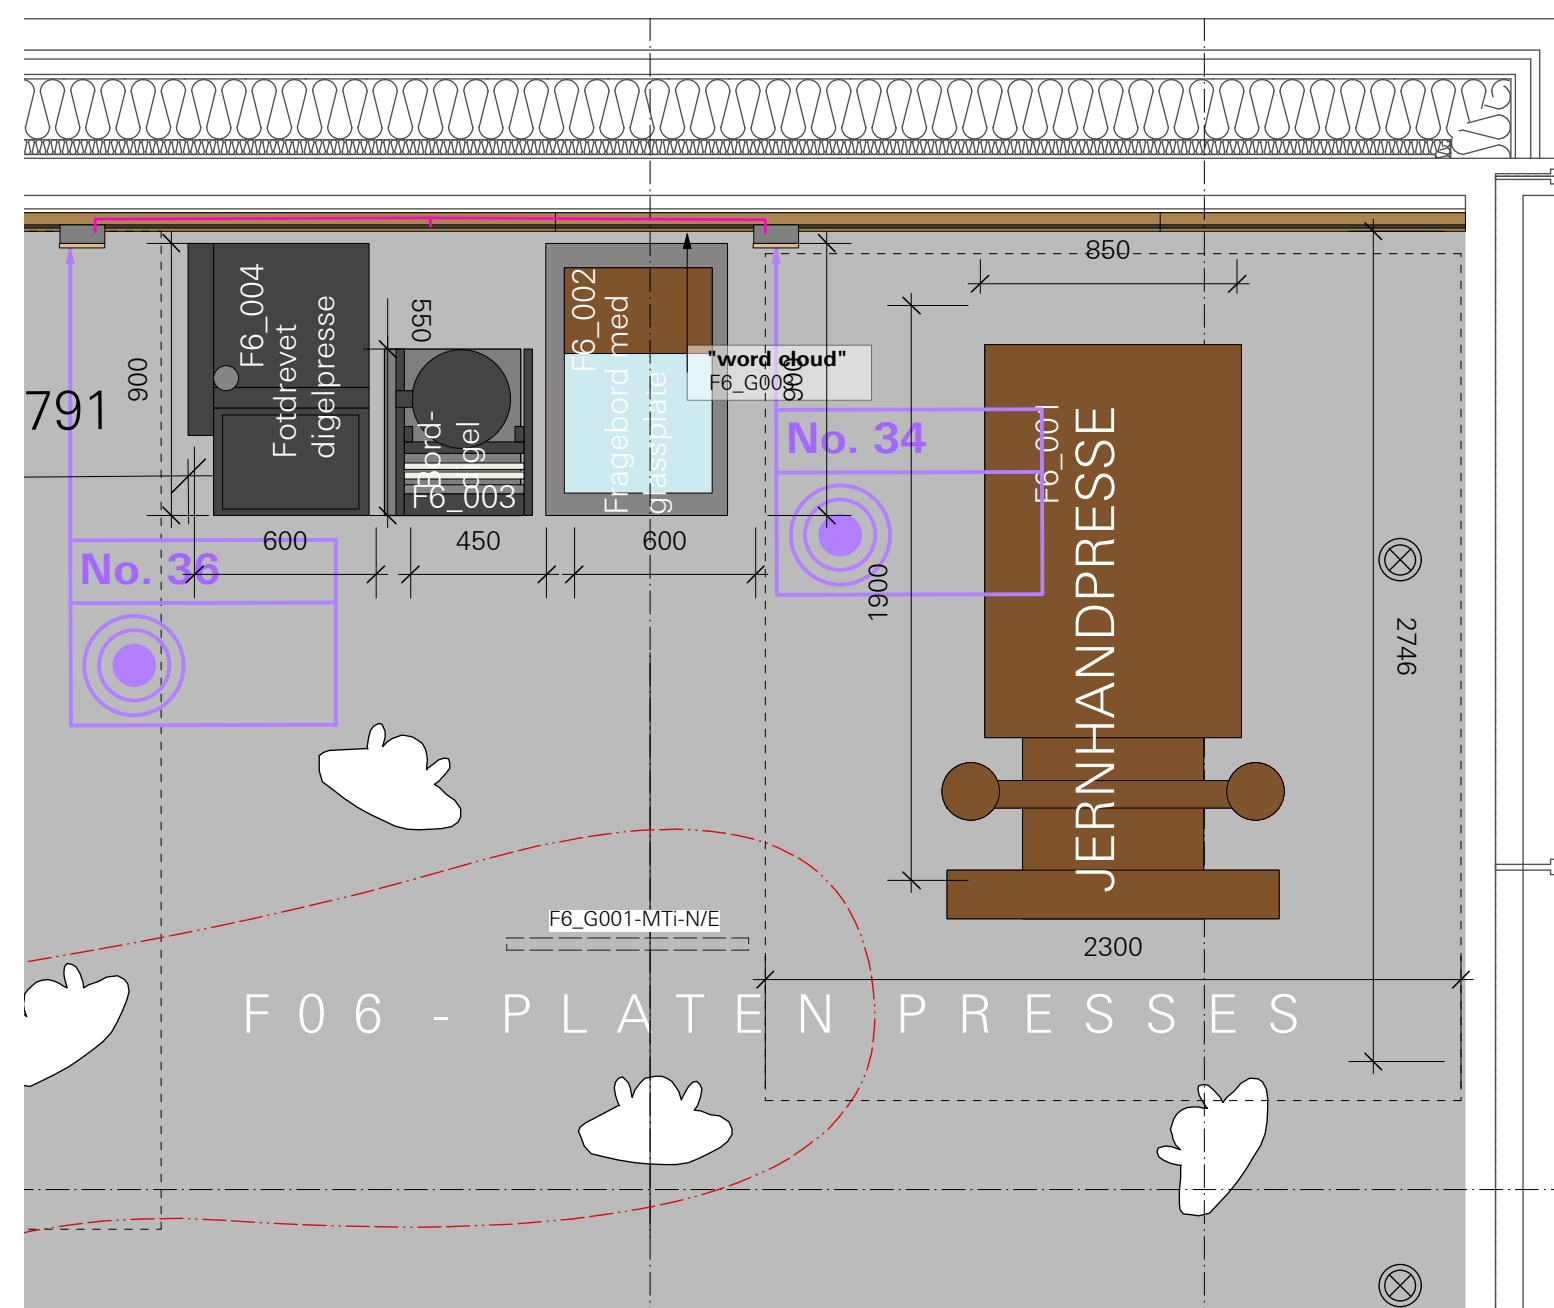

TOP VIEW
 M 1:25