


<b>TONNING &amp; LIENG AS</b> RÅDGIVENDE INGENIØRBYRÅ BYGGETEKNIKK - BYGGJELEDELSE J. ALLANS G.T. 9, 8500 KRISTIANSUND N. TLF. (073) 77411		KRISTIANSUND KOMMUNE REHAB. AV RÅDHUSET.	
TEGN	TRAC	FORMAS	UTSNITT
6	7/3		FASADE VEST
DA TO	ERSTATTER TEGN	MALESTØKK	TEGN NR.
28.6.96		1:50	1373 11
			REV



**RÅDHUSET**  
 drif. tegn nr. 107/08-10

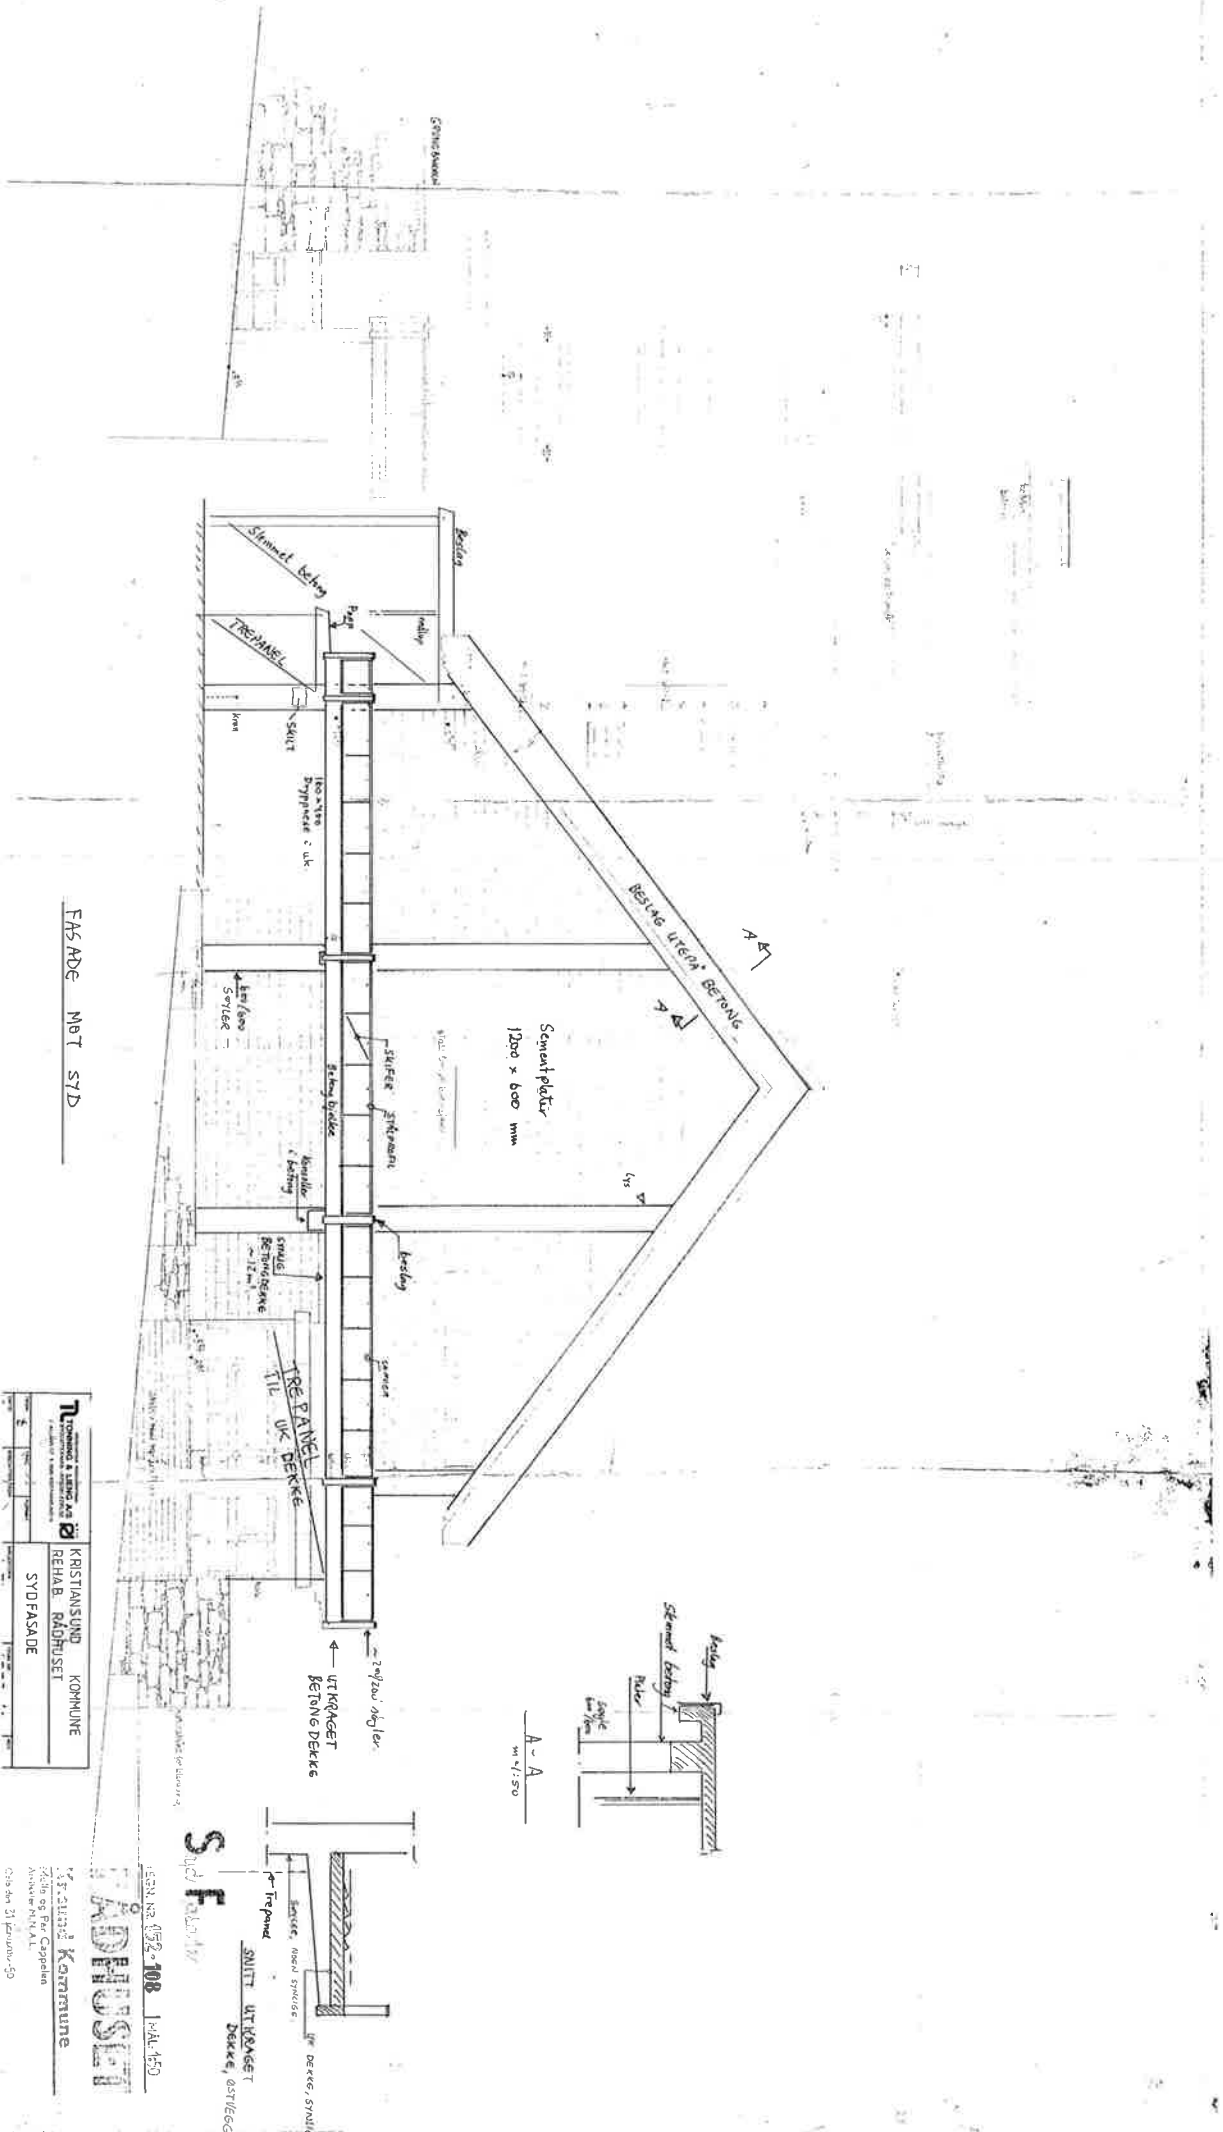

FASADE MOT SYD

<p>KOMMUNE</p>		

A - A  

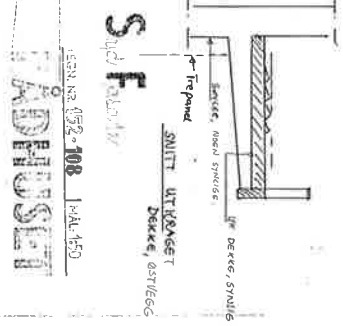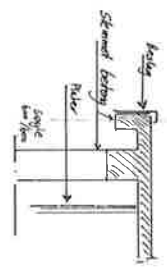

**RÅDHUSET**  
