



Eviskerte sitering

101m gasje  
70-75m dragskering

101m Gasje


97,5m Dragskering



OK:

1) BKB 25/73 M bunn  
25/65 selger M bunn

2) LEK9+SPA = Klakk+Lek9

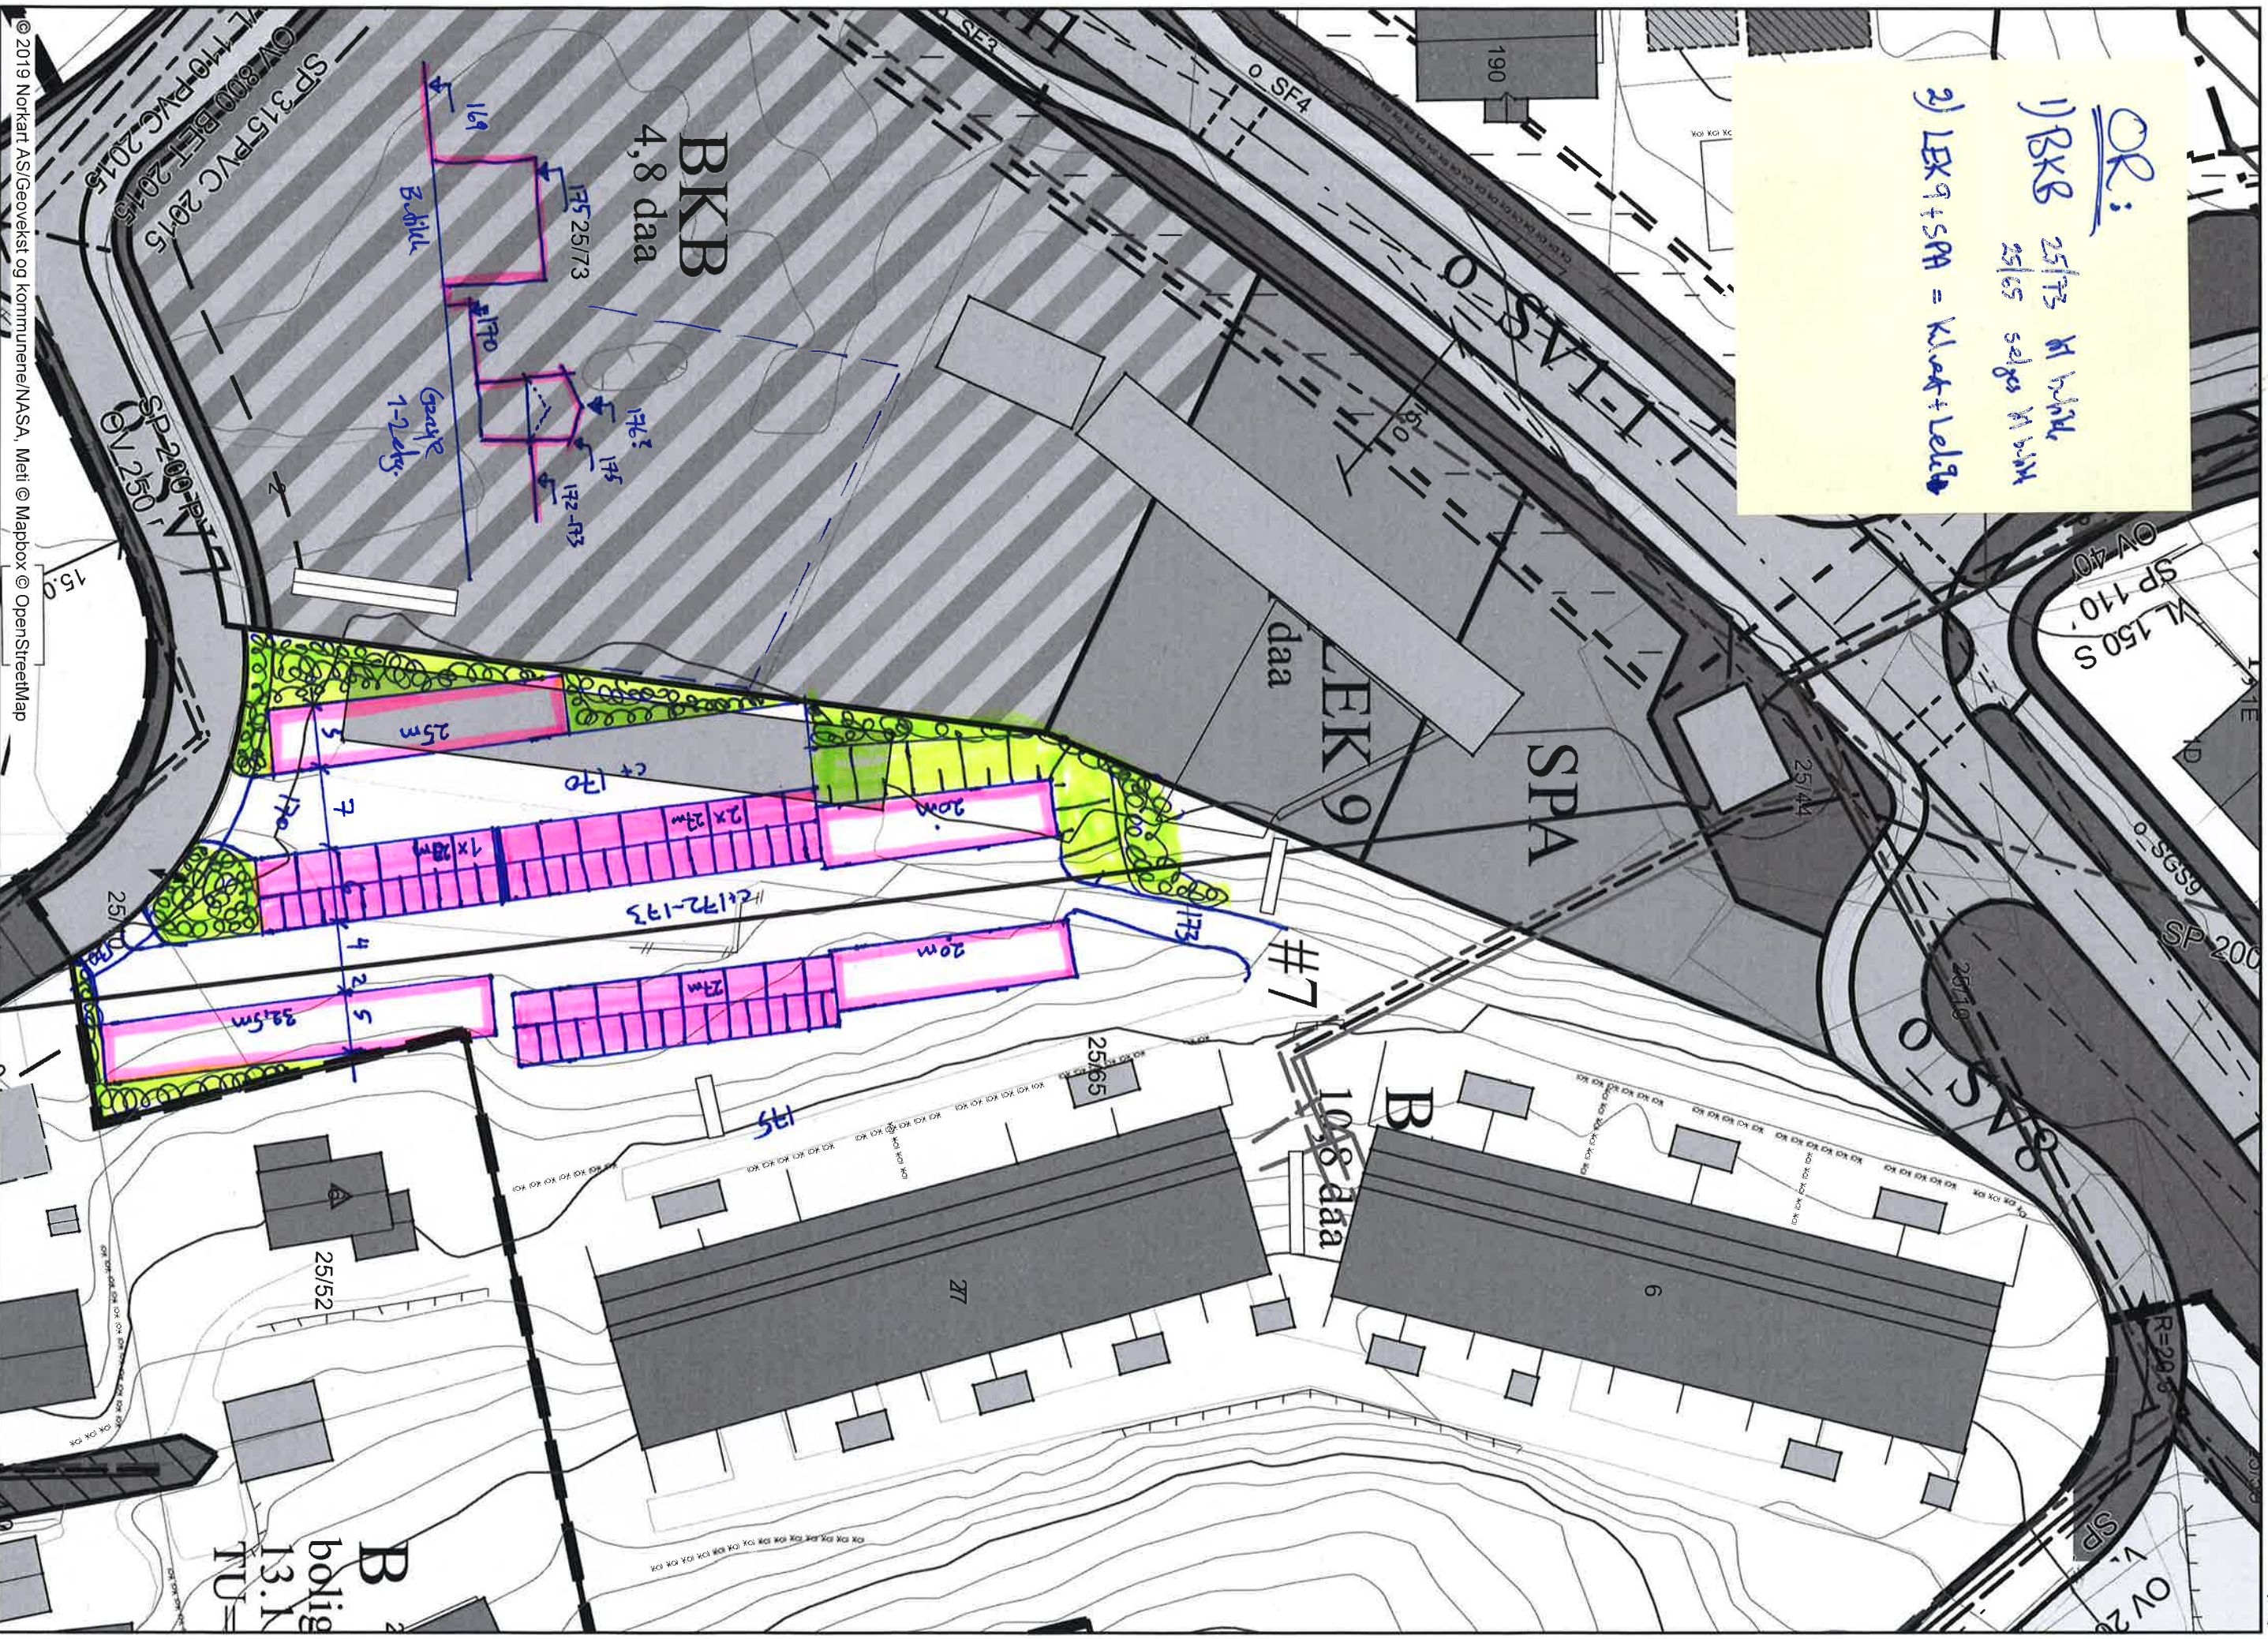

BKB  
4,8 daa

LEK9  
10,8 daa

SPA

B

B  
bolig  
13,1 daa