


Reinsvoll skole. Gymbygget.

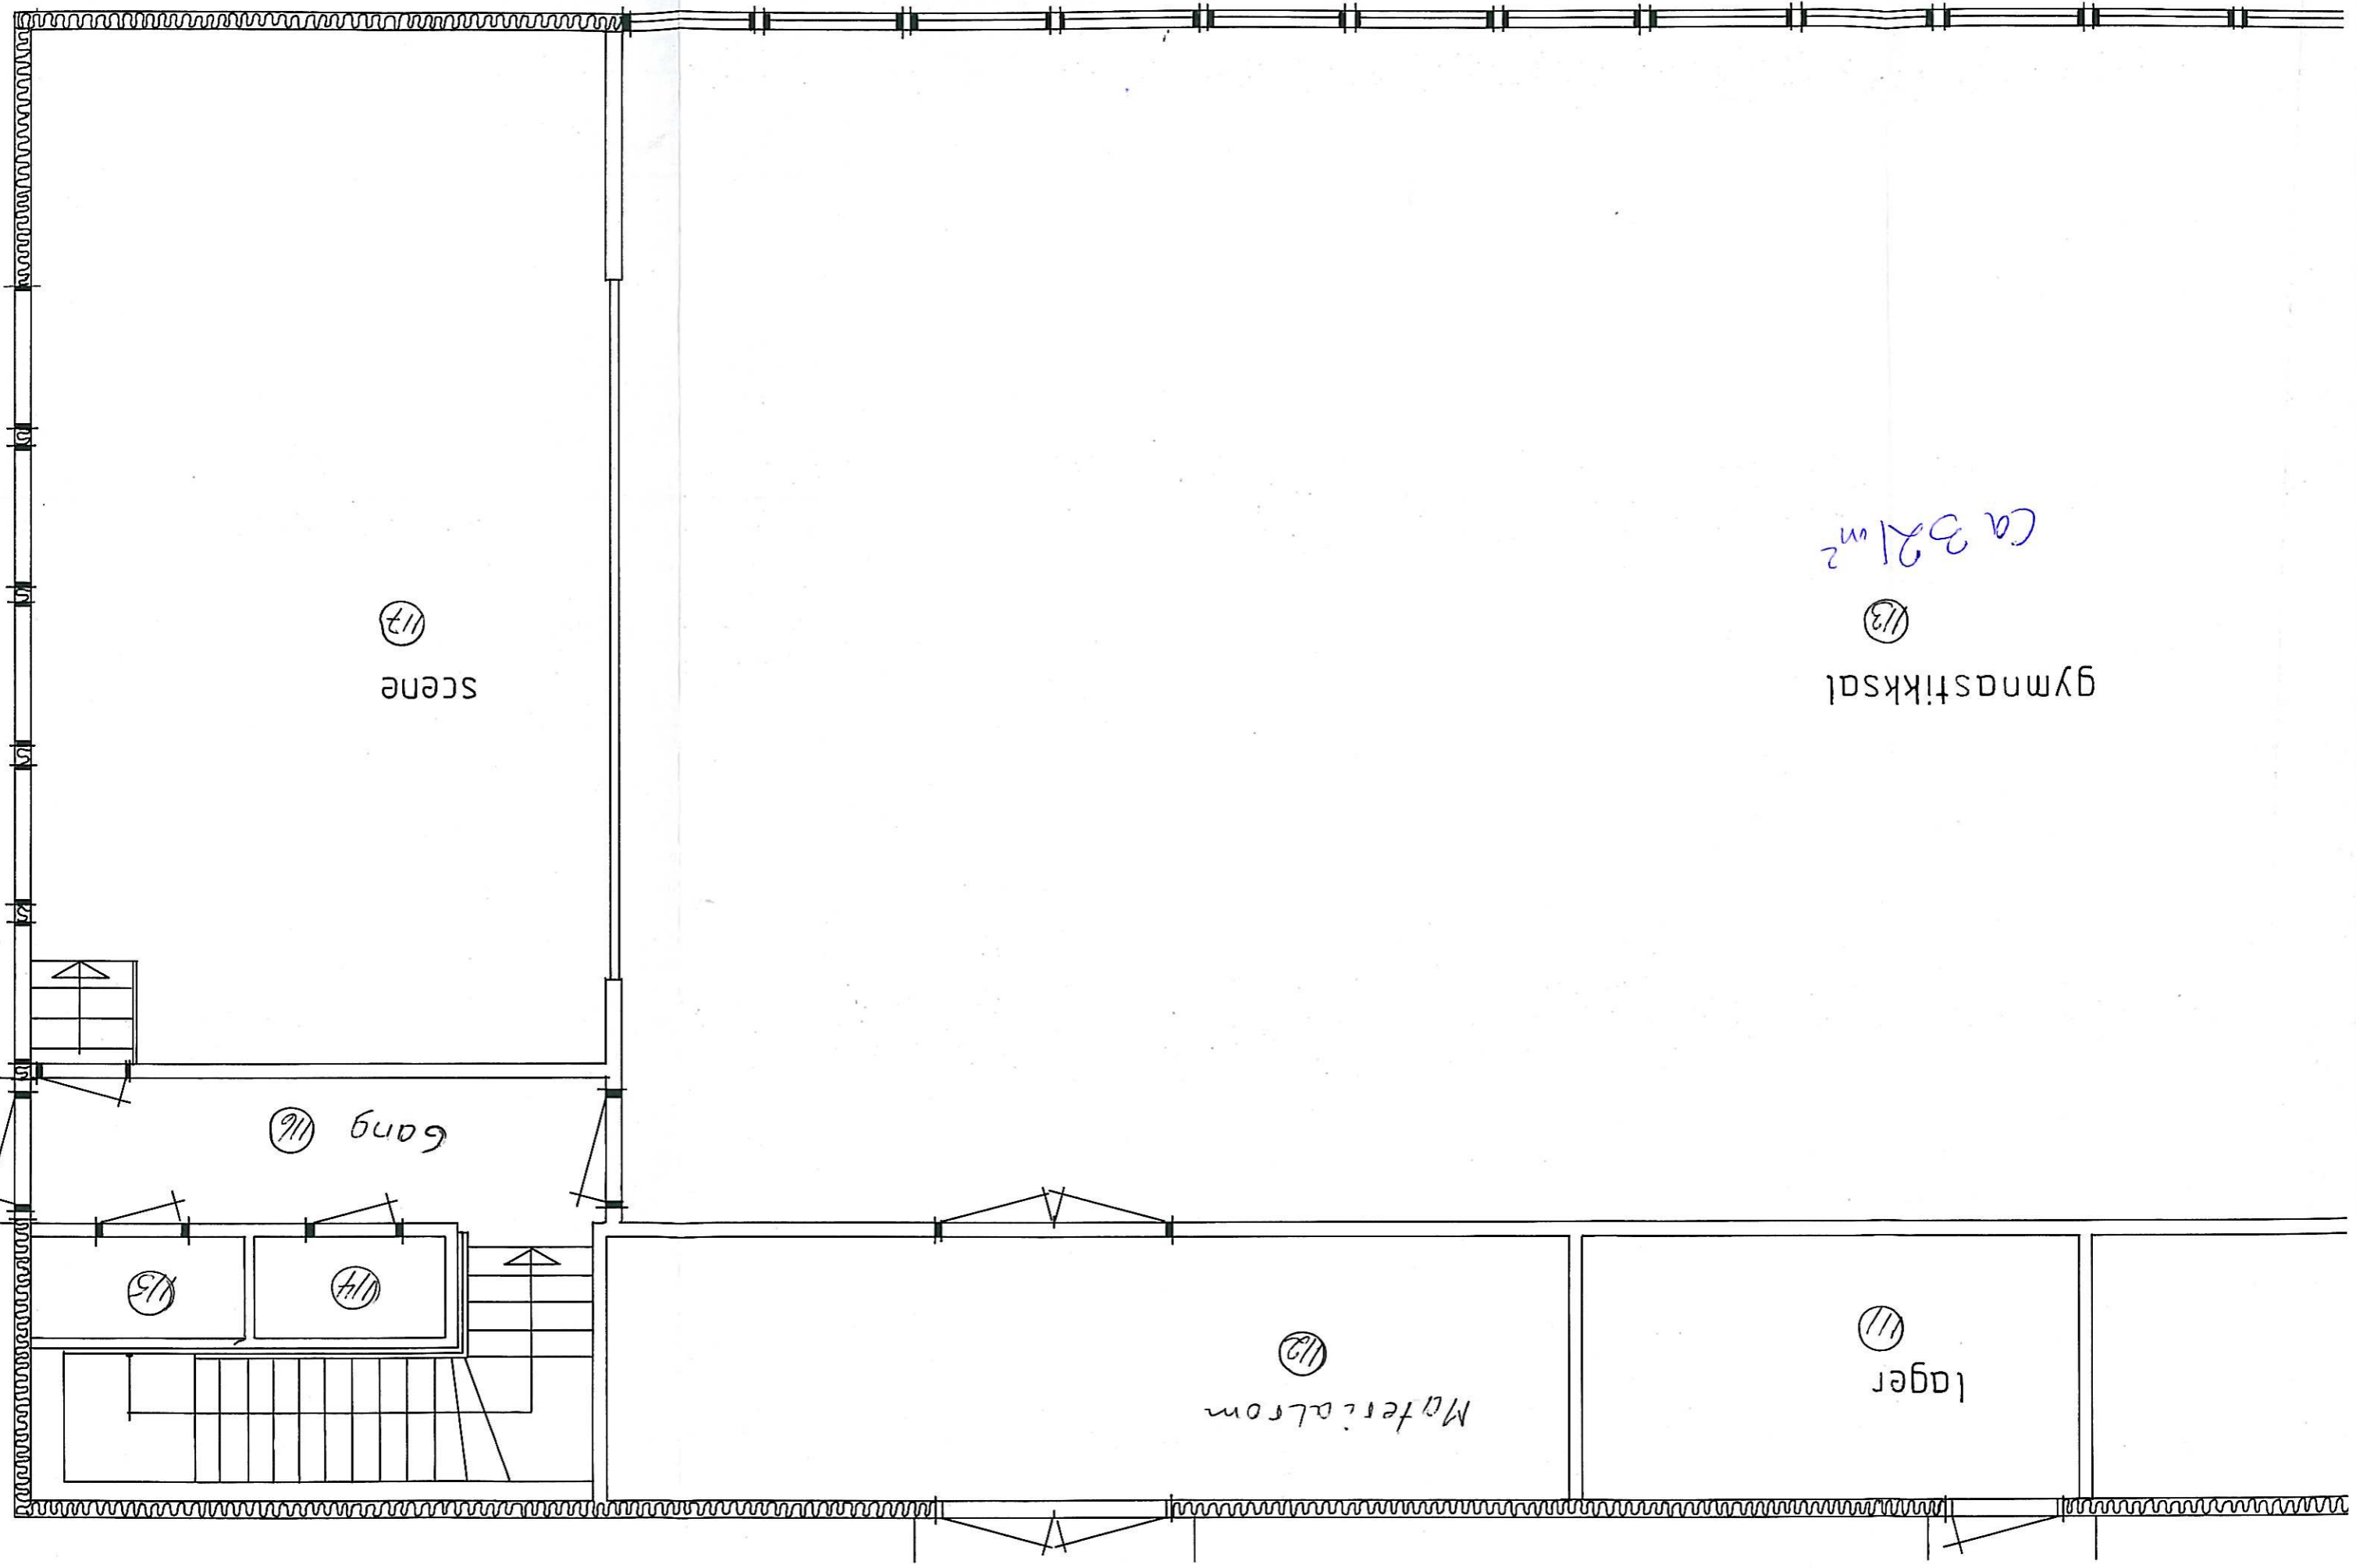

ca 321 m²

113

gymnastikkasal

117

scene

111

gang

115

114

112

Materialrom

116

lager