


Eksponert fasade etter riving.

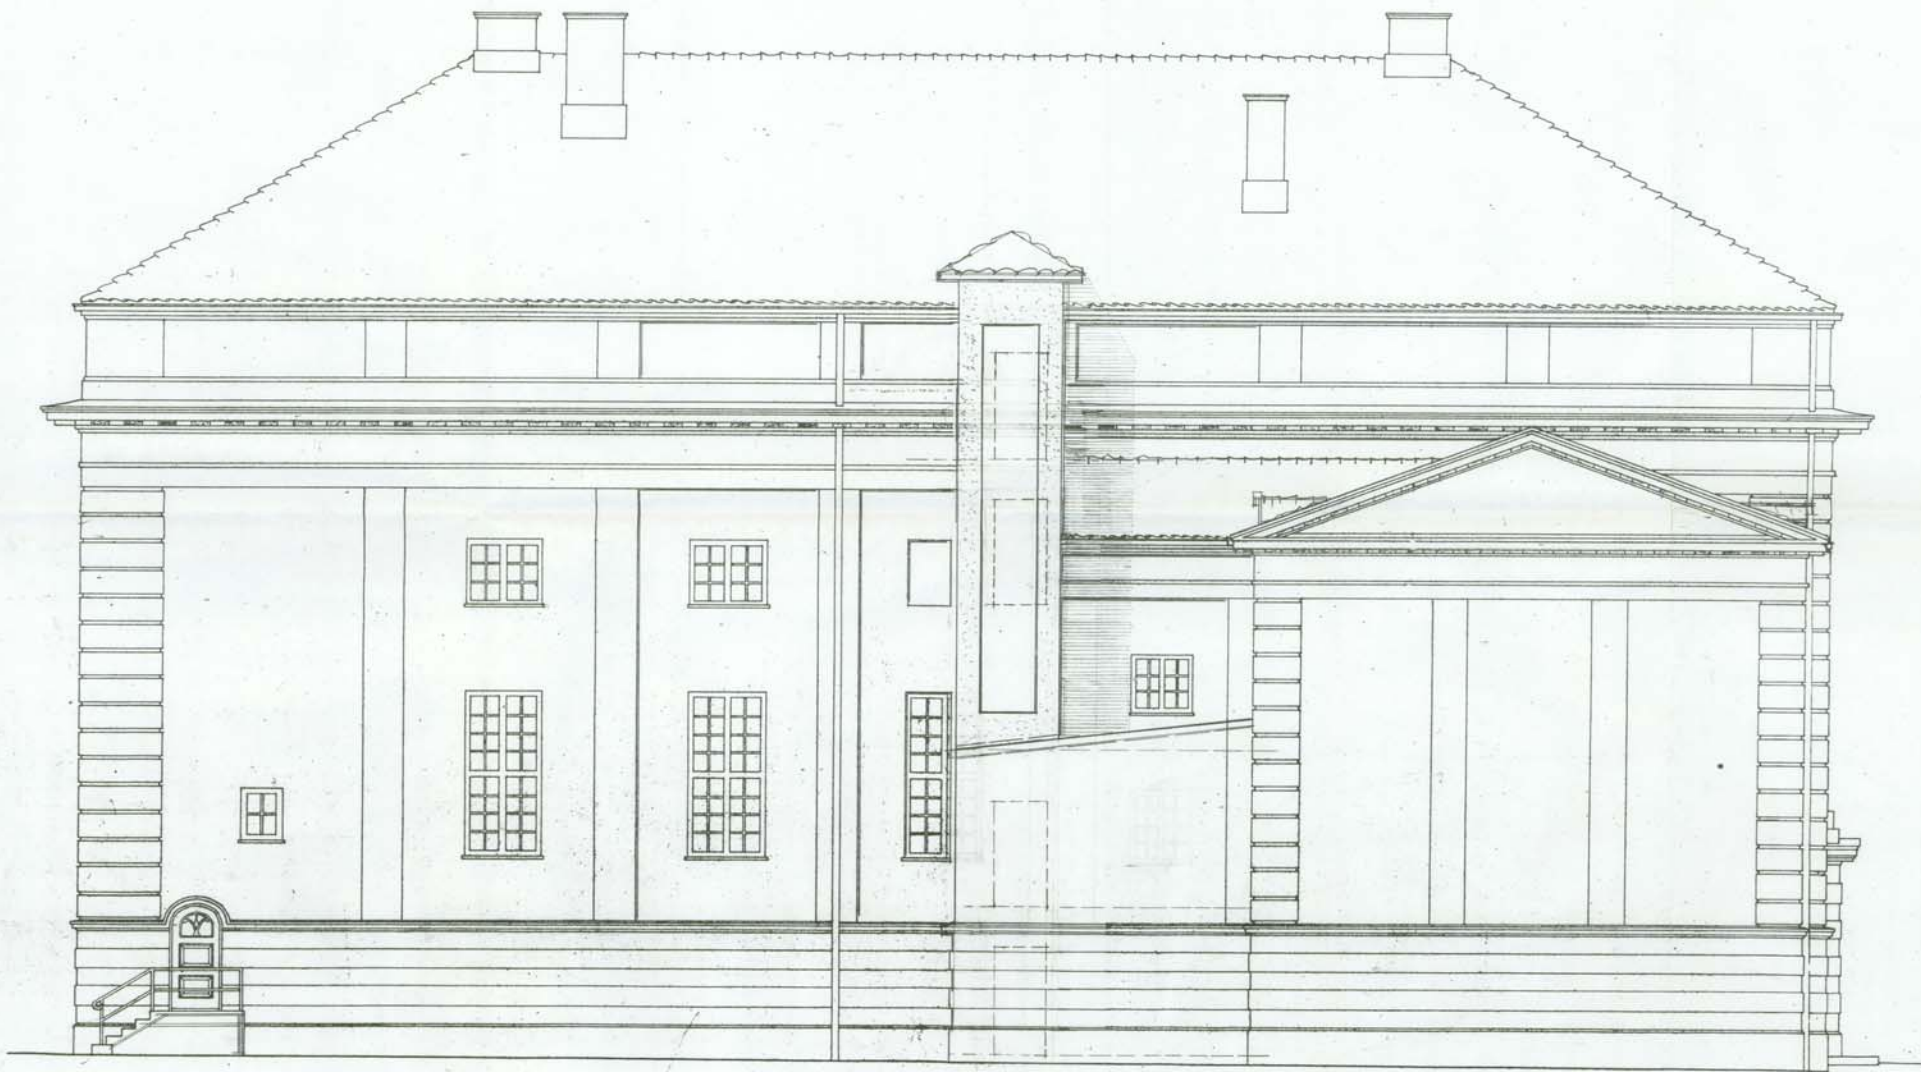


BL . V

DRAMMENS FRIMURERLOGES  
NYBYGNING.  
1923 - 1993



• BAKFACADE •  
• MOT SYD • NABB •

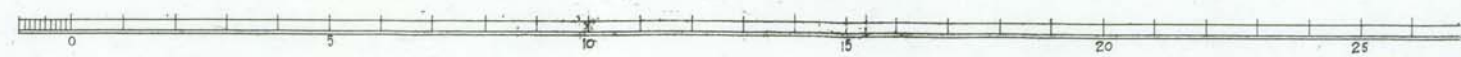

PROSJEKT HEISILØGEN  
Anmeldingstegning  
Fødselsnr og byggesaksnummer  
11444, 14444, 14444  
Drammen den 3 Juli 1996

15.02.97  
14.02.97  
14.02.97

REVIDERT TEGNING GODKJENT  
18.9.1997  
12.9.1996



