


Snitt A

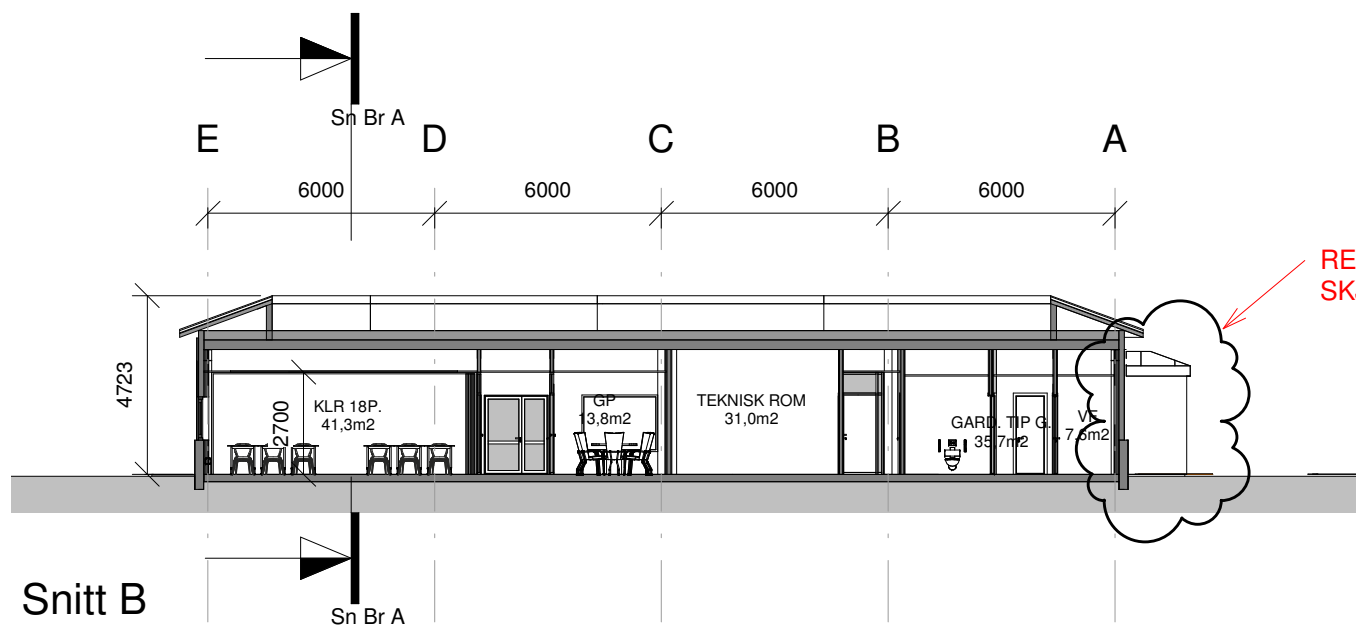

REV. 13.05.20:
SKJERMET INNG. TIP-GARD.

Snitt B