


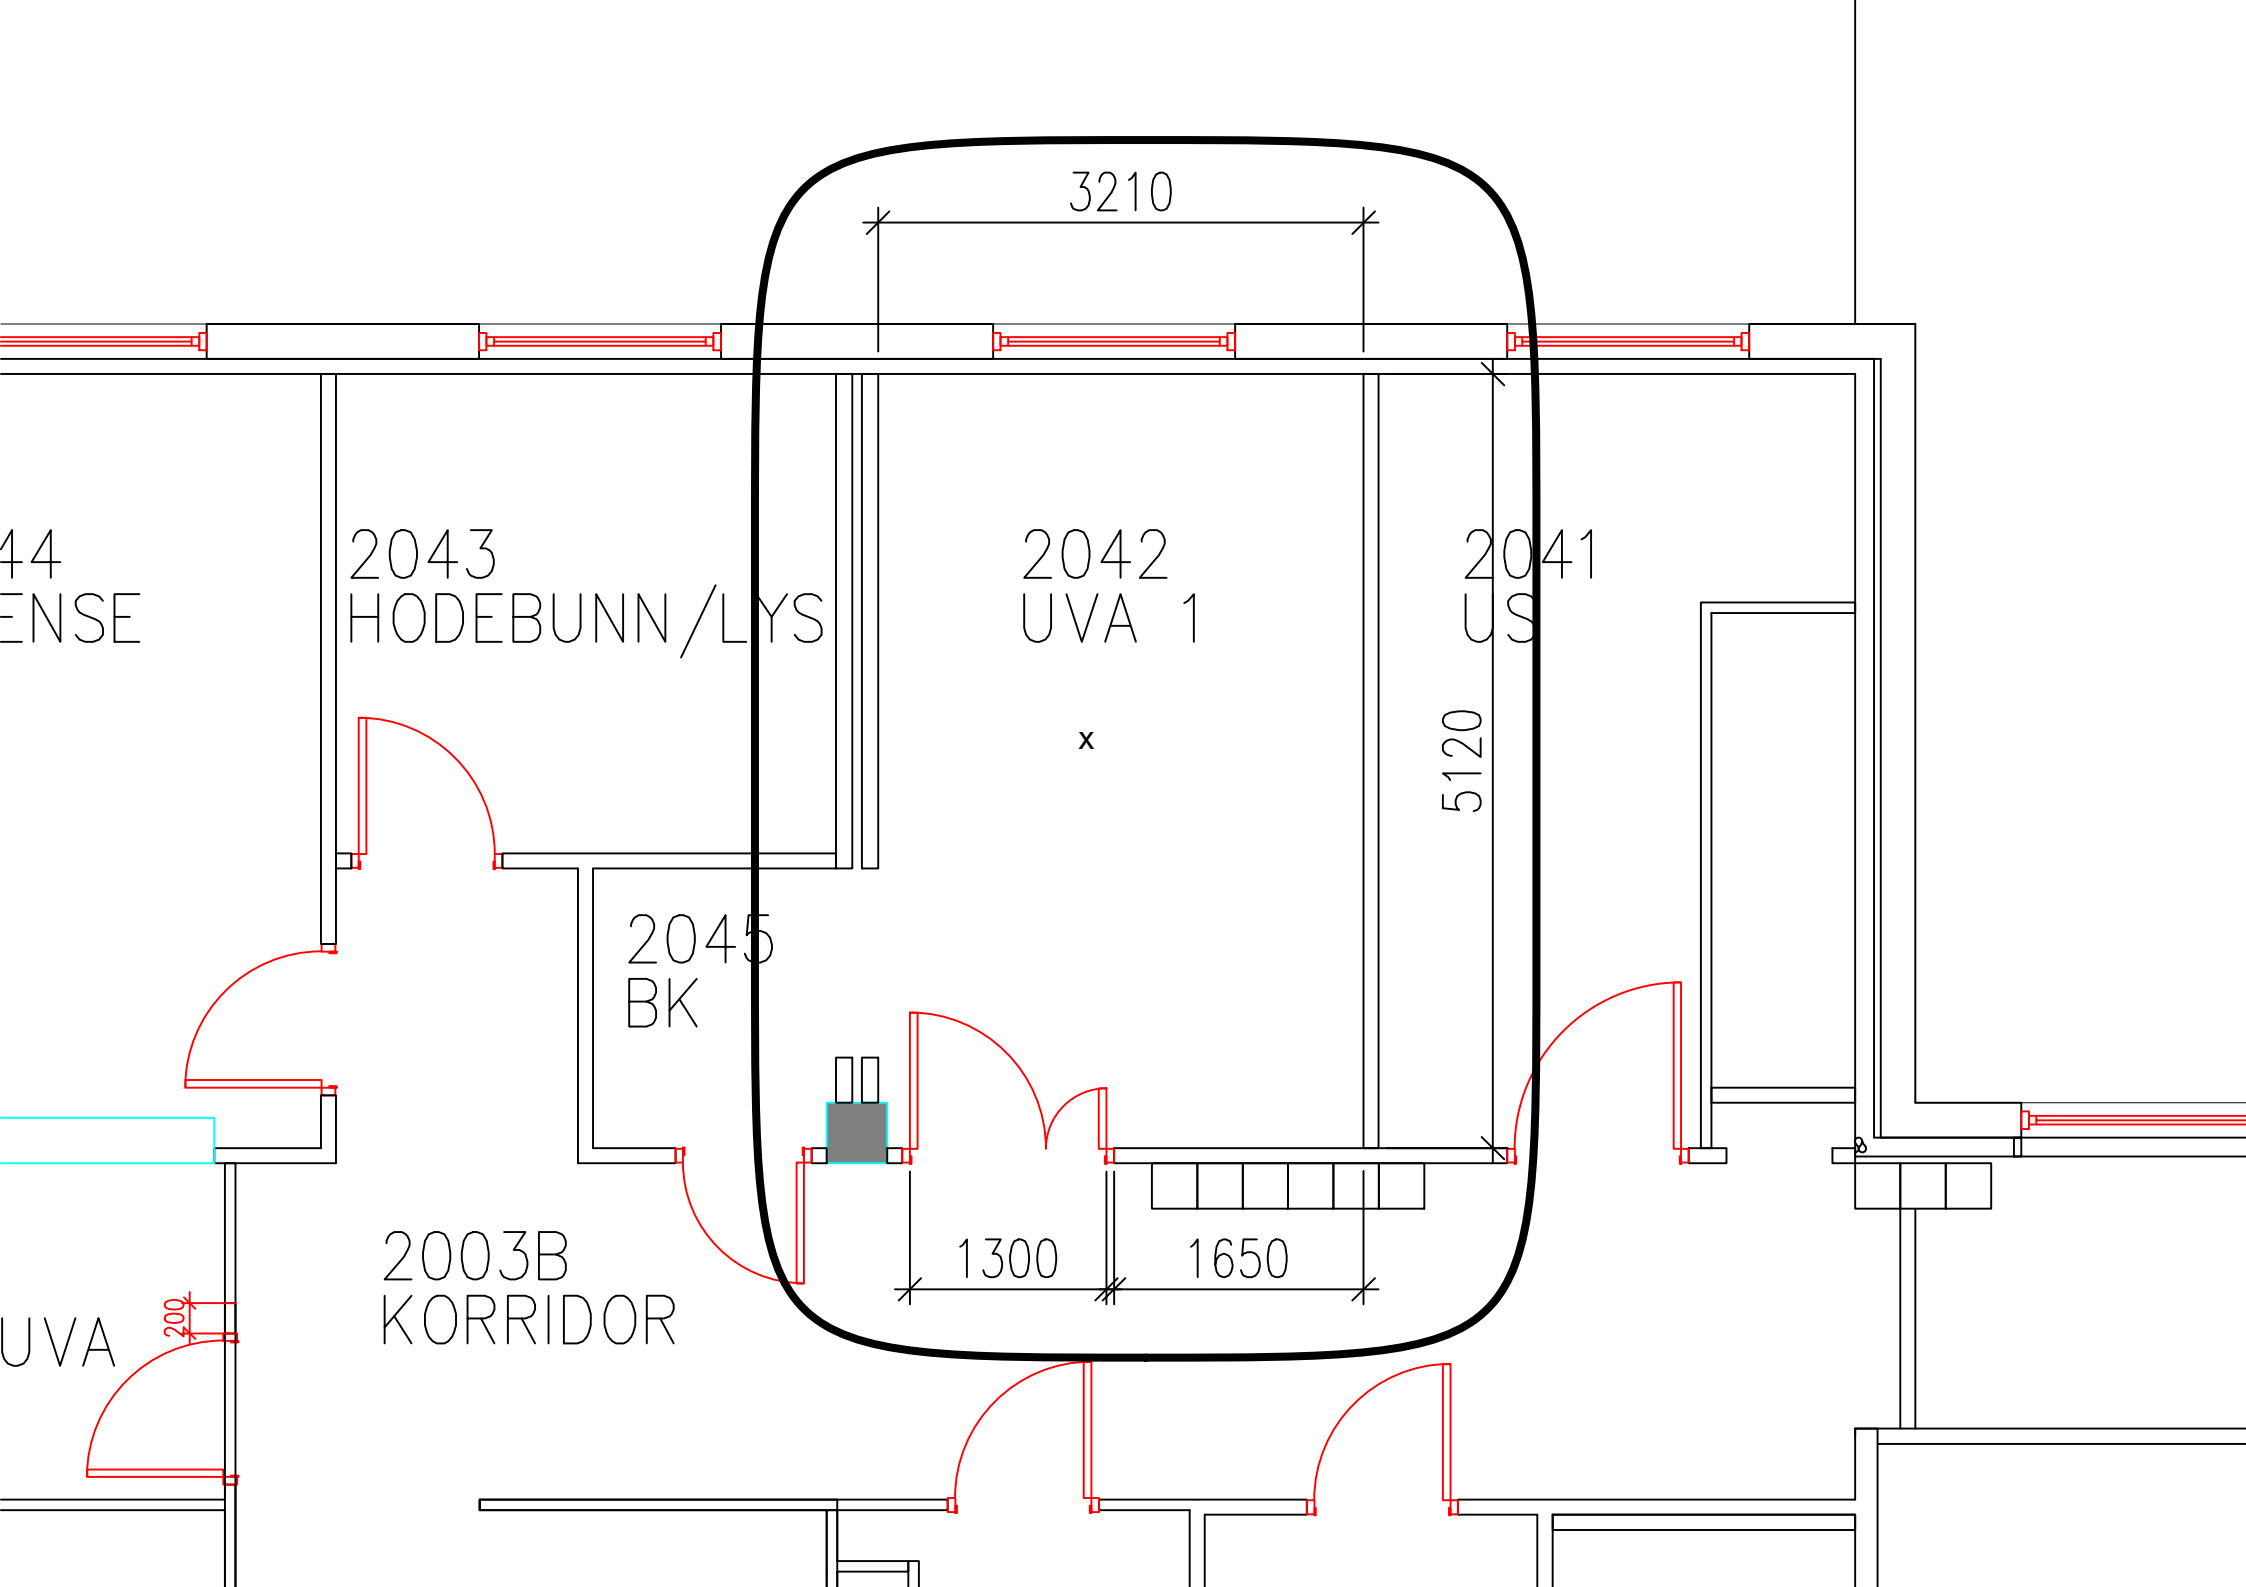

3210

2042
UVA 1

x

2041
US

5120

2045
BK

2043
HODEBUNN/LYS

2003B
KORRIDOR

1300

1650

200

44
ENSE

UVA