

LIESLIA FELT SKYTEBANE.
HV-SKOLEN DOMBAS.

Bane 7

INNTAKS BASSE

VANNRESERVOAR (1200m³)
BRANN SL. MATR.
HYDRANT.

BRANN SL. MATR.
HYDRANT.

6

4.2

4.1

4.1

4

3

2


1

1

BANE 1

BANE 2

BANE 3

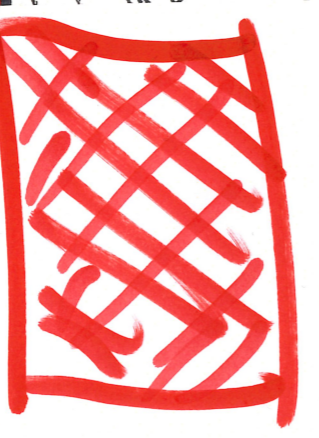

Bane 4

= NYE HYTTER
3,6 x 3M. INNEBYGGE
(4 STK)

INV. NR 0603 BRUNN MED PUMPE

DOVRE

BOM

BUM

STANDARDKASS BANE 7

