




HØYBLOKK VEST

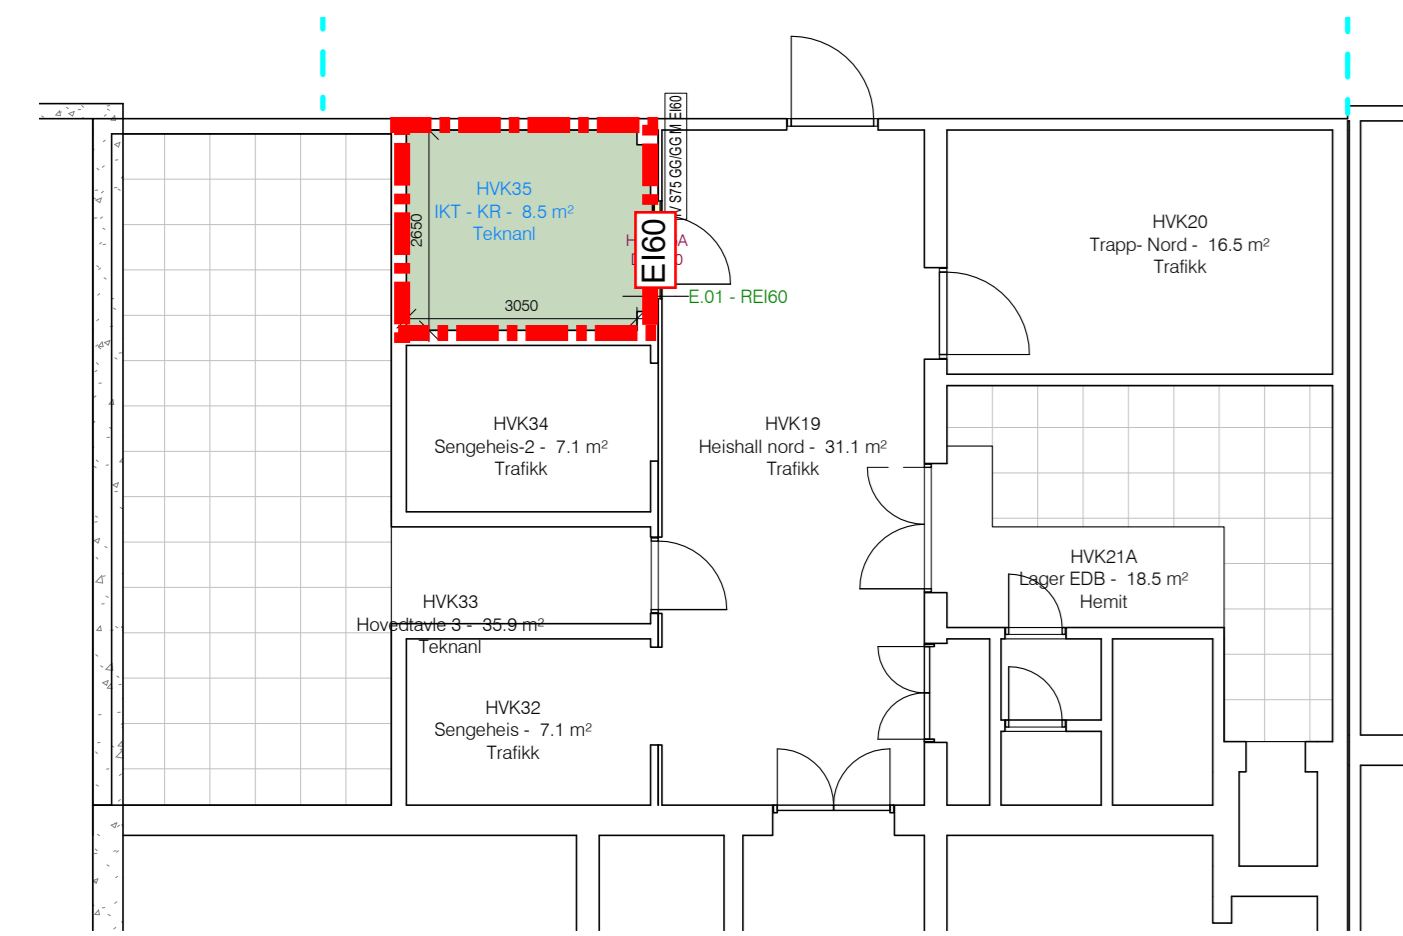


HV - Plan U2 1 : 100

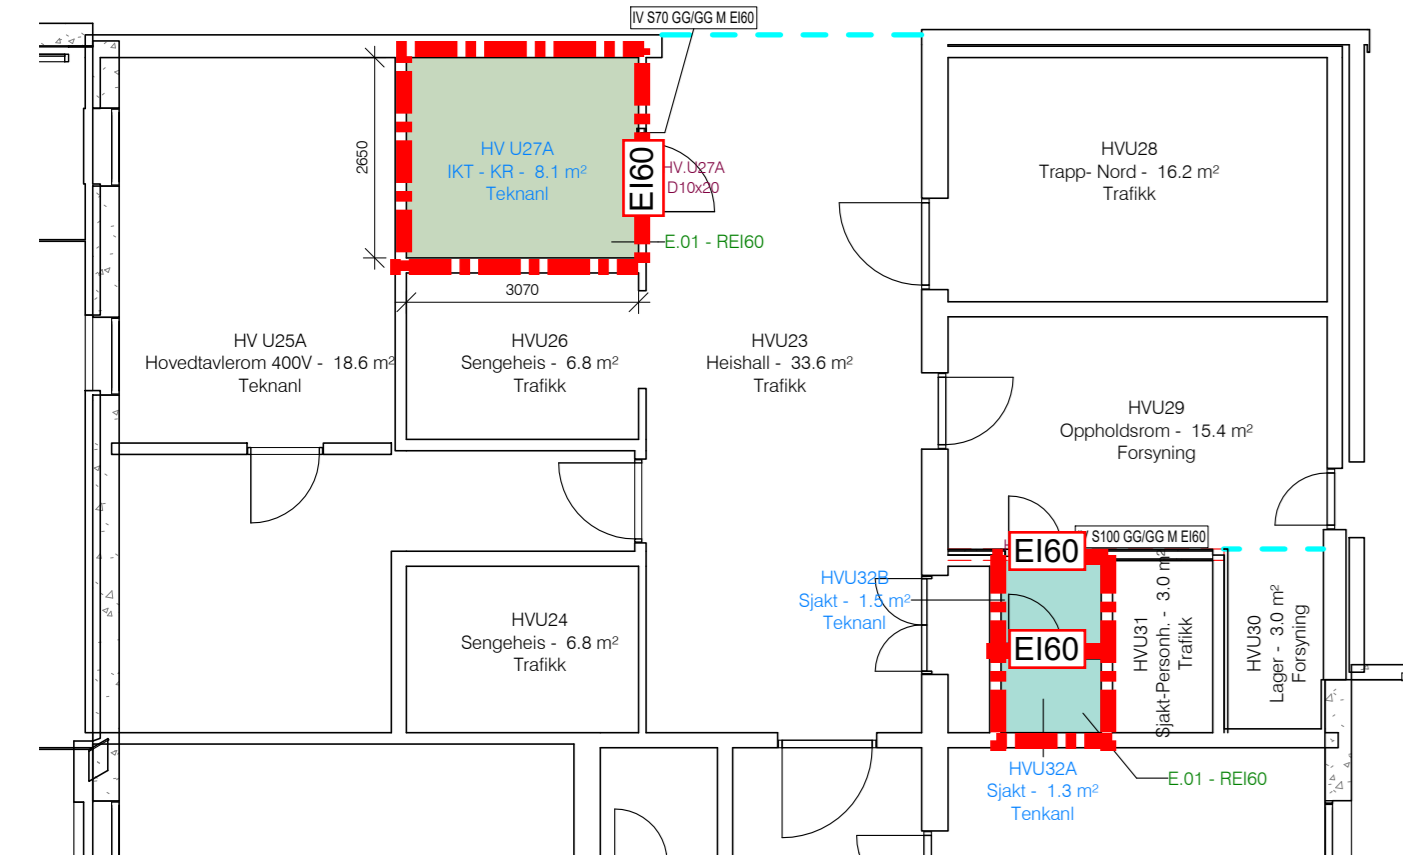


HV - Plan U1 1 : 100

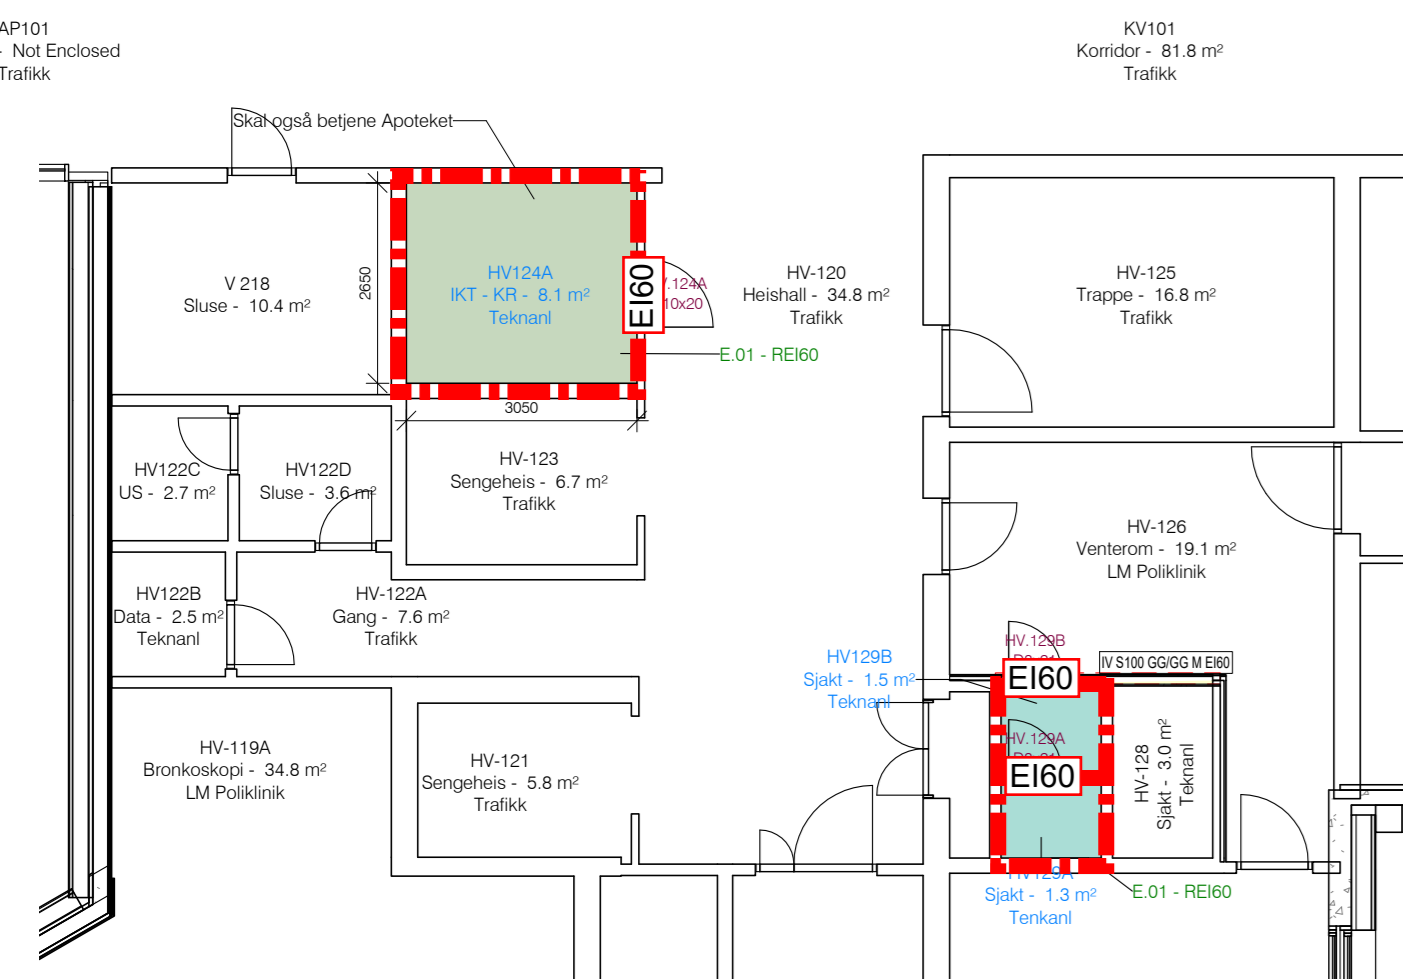


HV - Plan 01 1 : 100

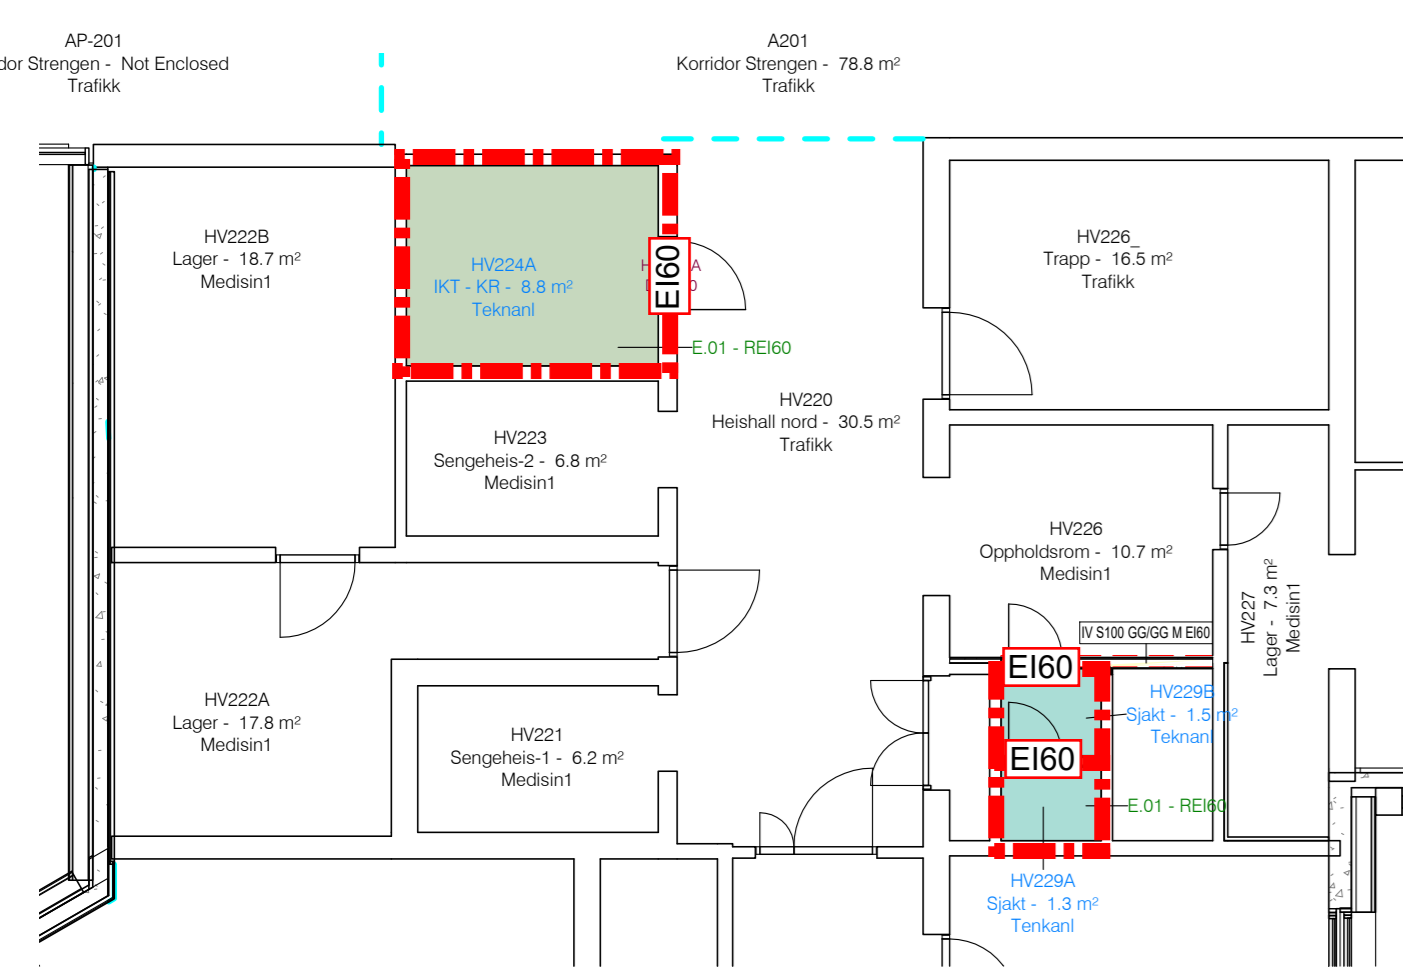


HV - Plan 02 1 : 100

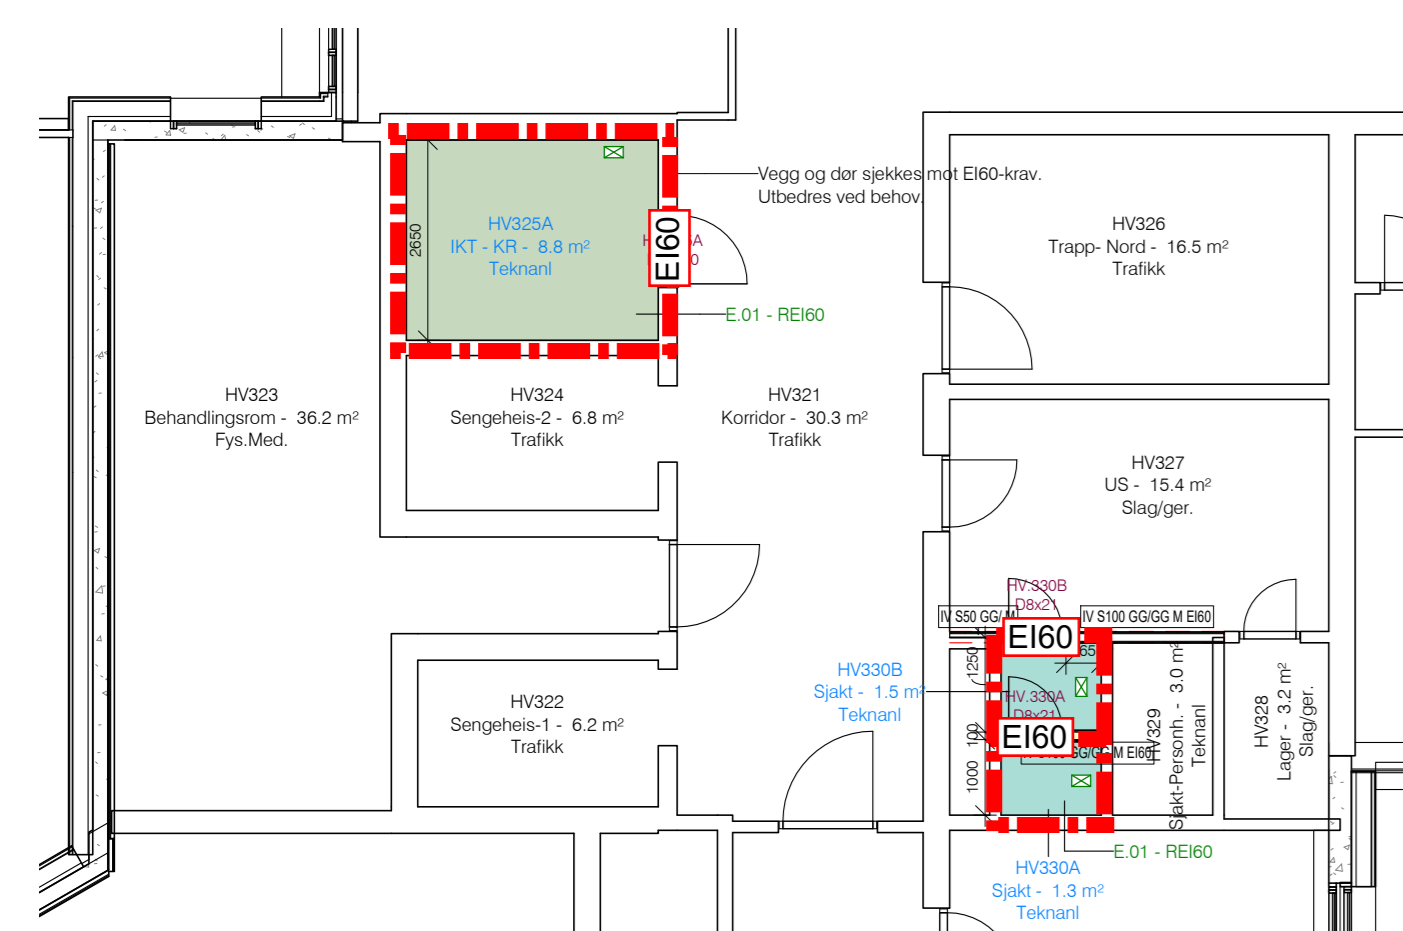

HV - Plan 03 1 : 100

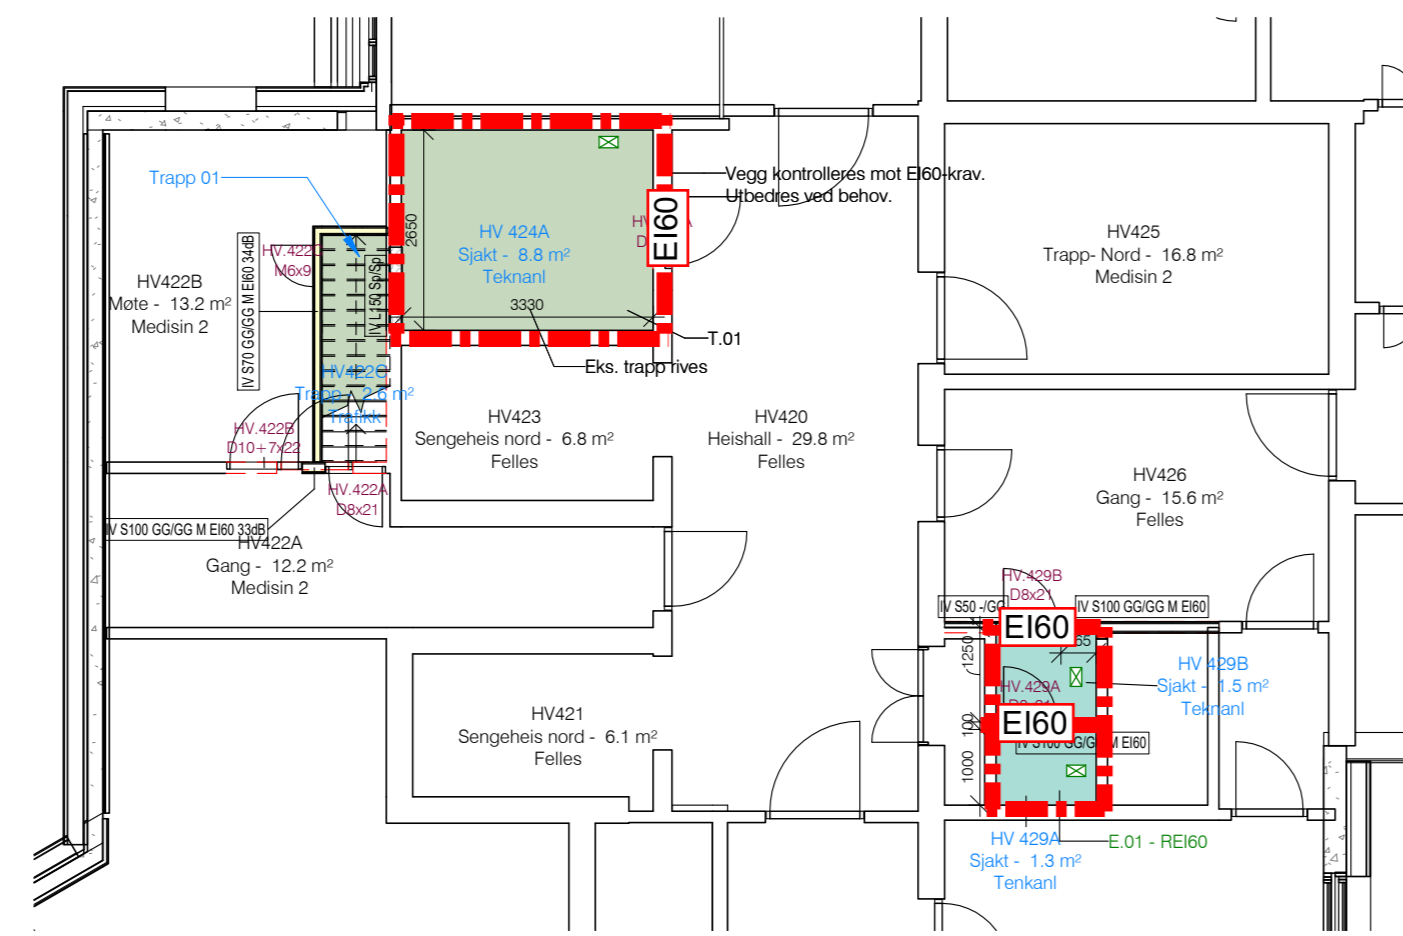


HV - Plan 04 1 : 100

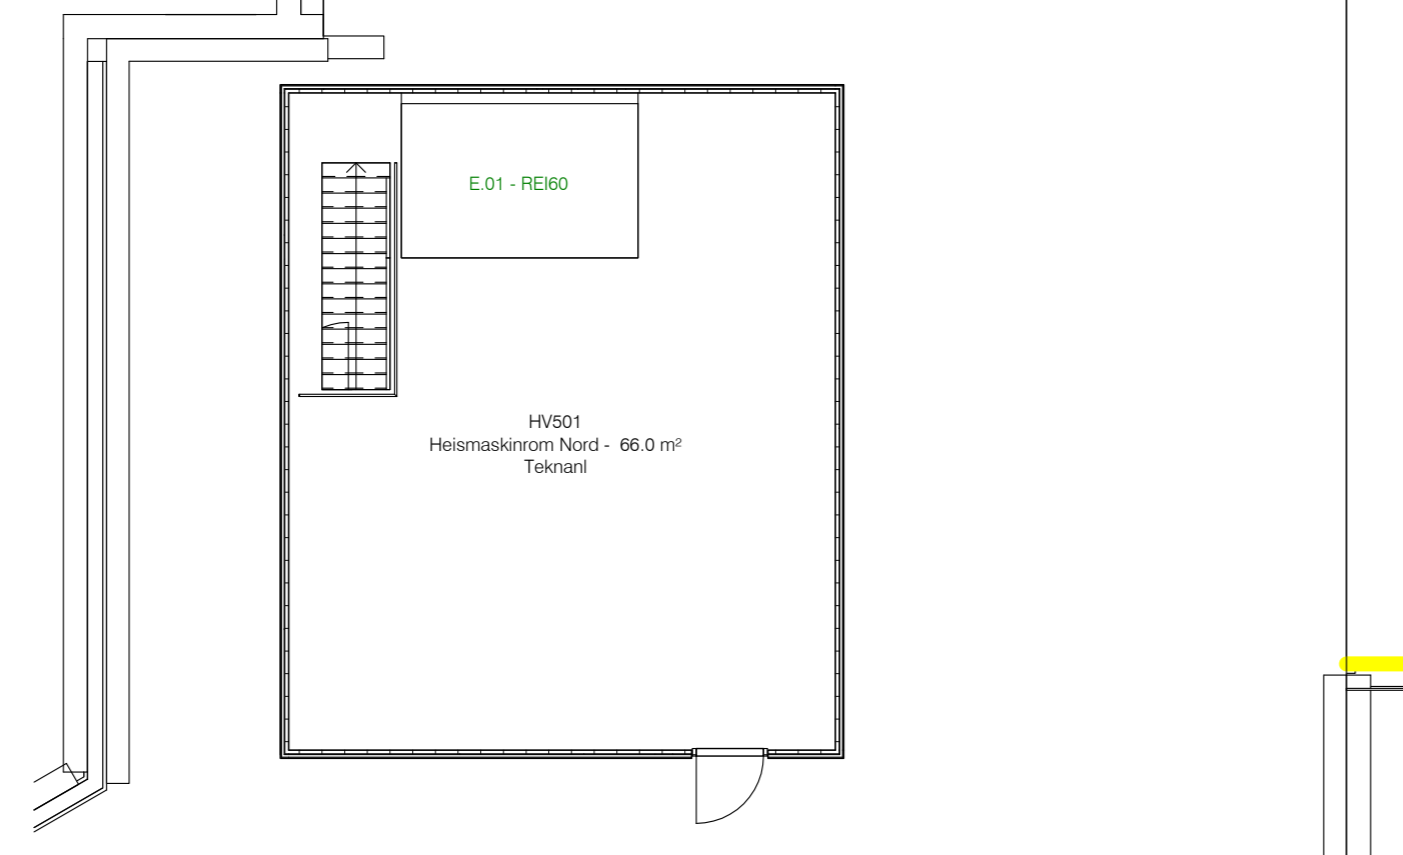


HV - Plan 05 1 : 100


HØYBLOKK ØST

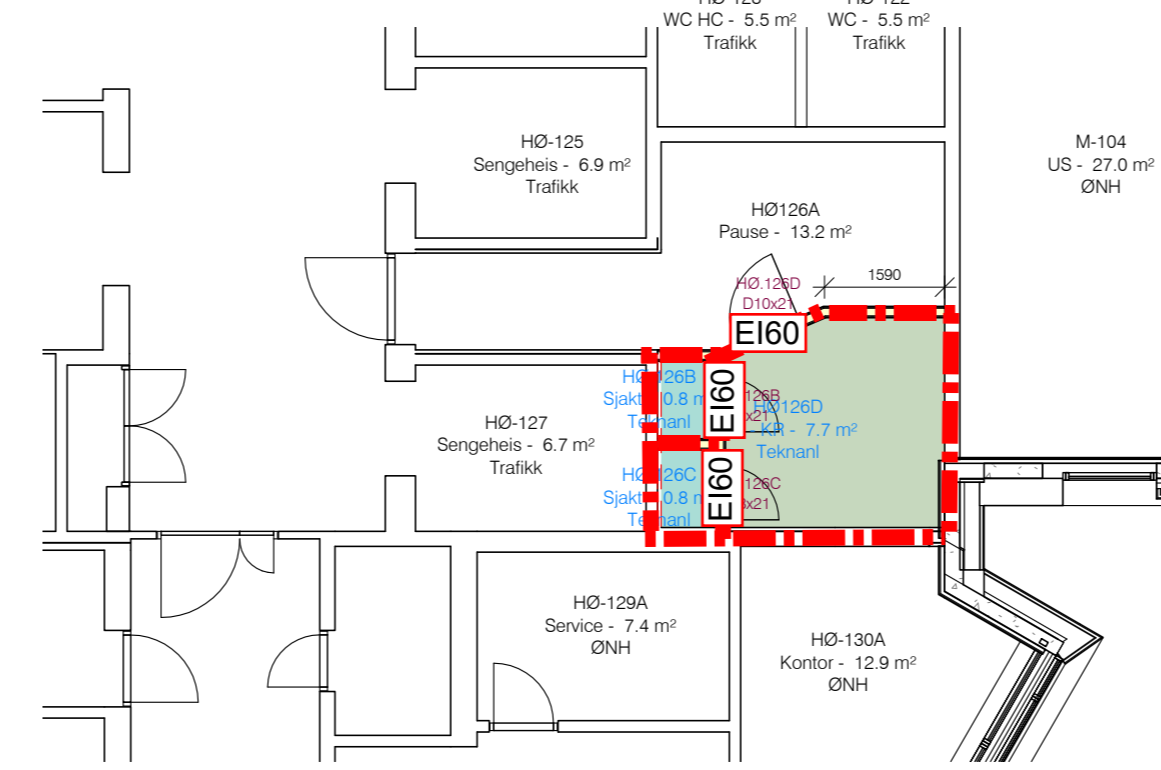


HØ - Plan 01 1 : 100

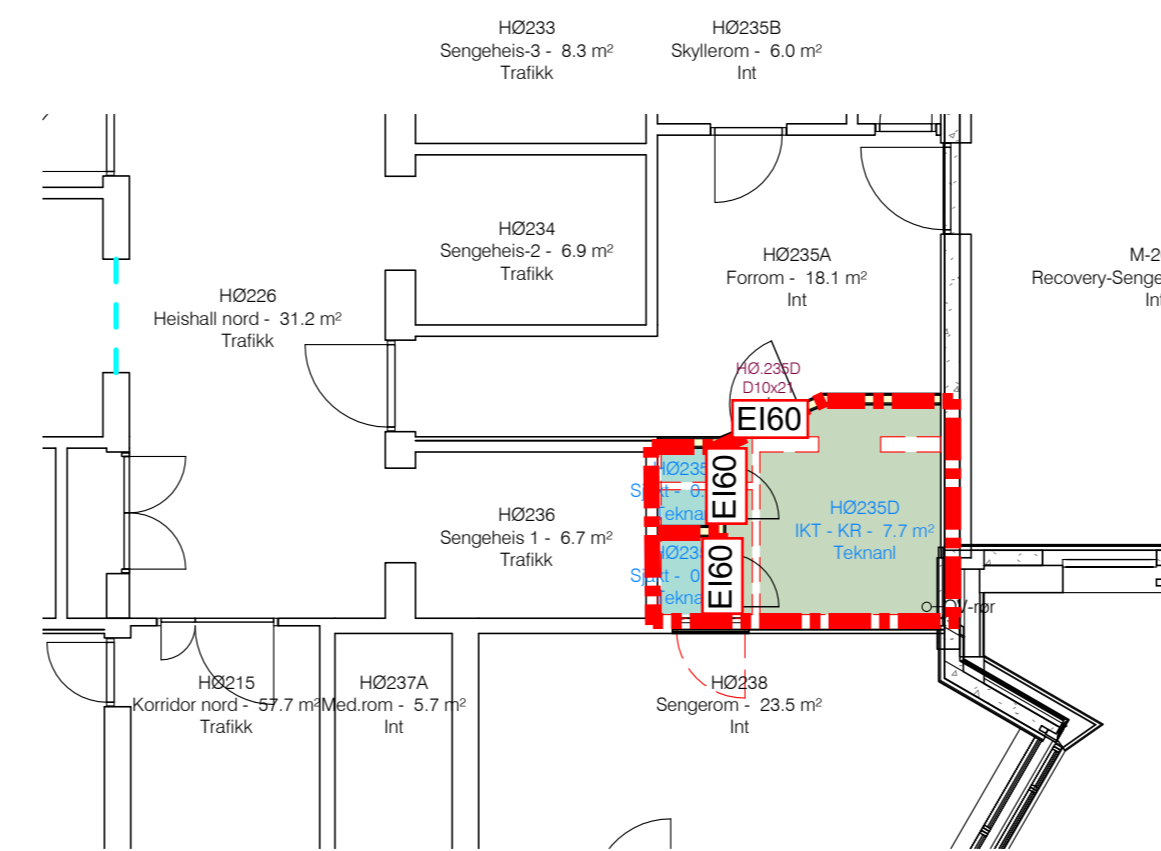


HØ - Plan 02 1 : 100

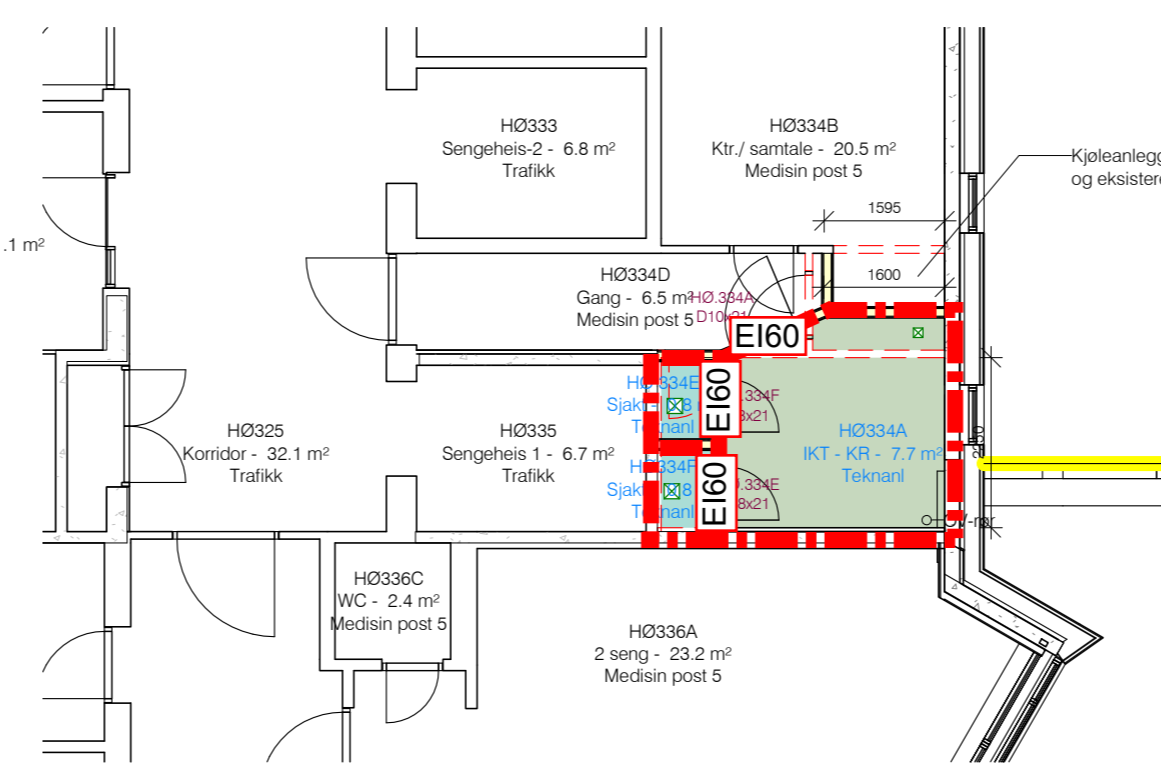


HØ - Plan 03 1 : 100

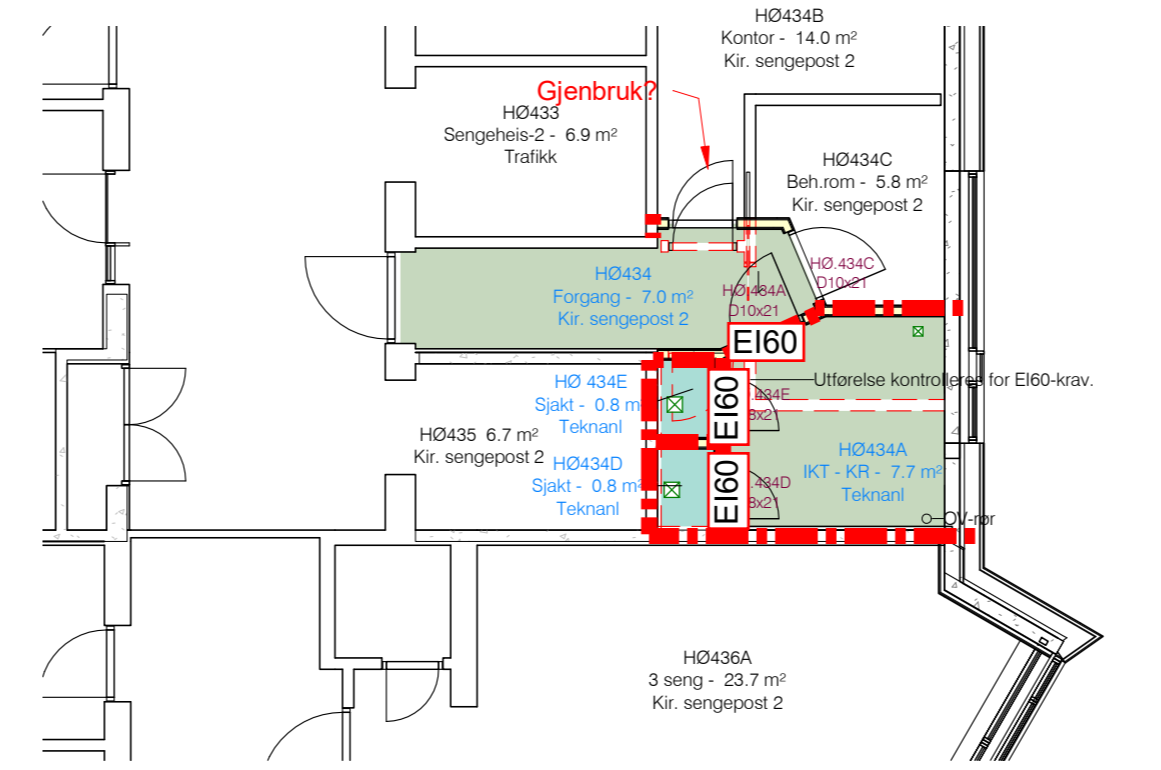


HØ - Plan 04 1 : 100

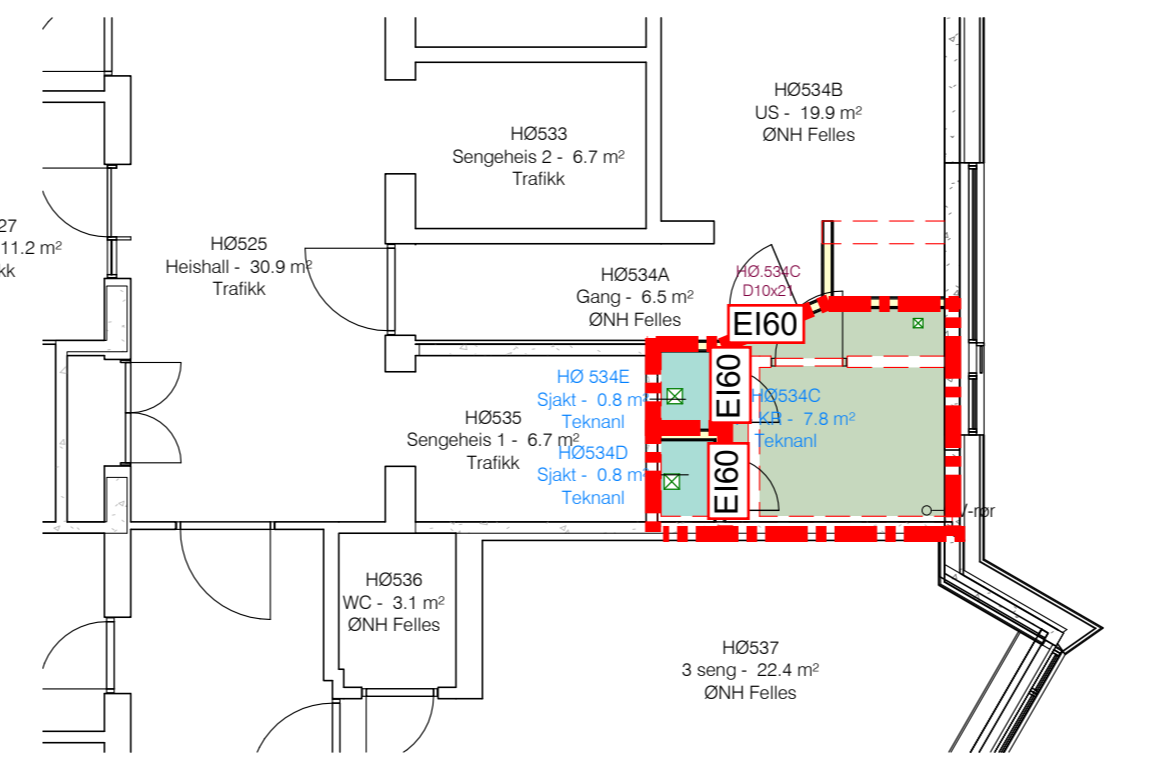


HØ - Plan 05 1 : 100

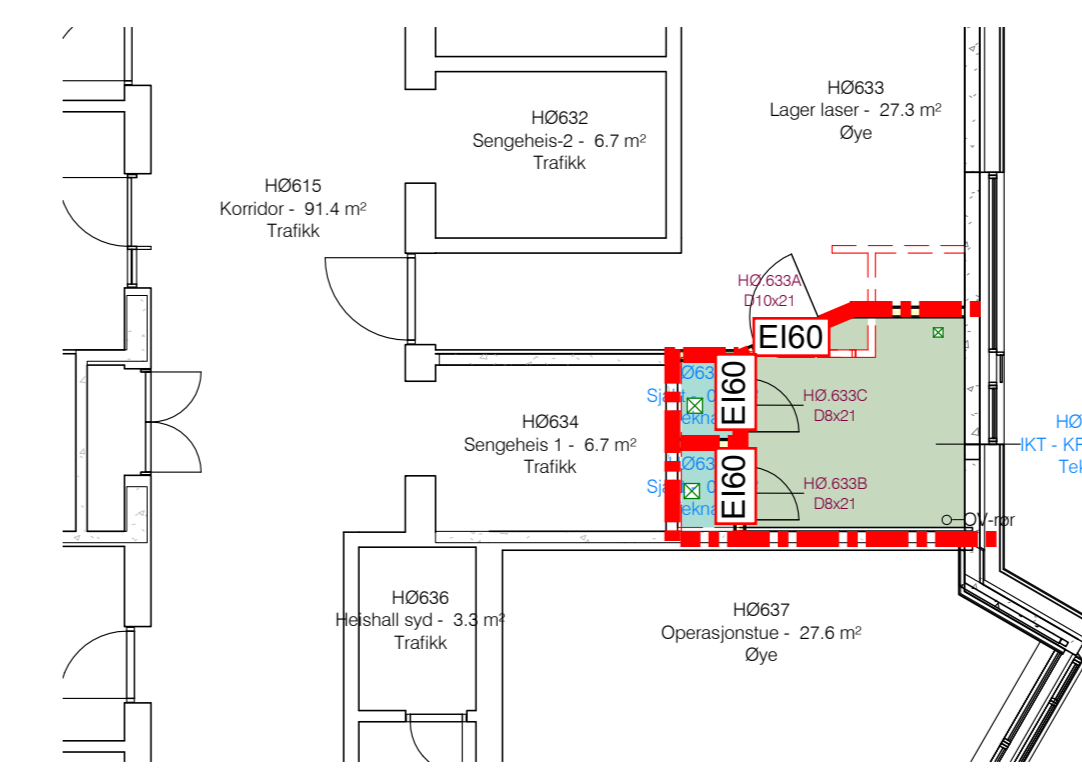


HØ - Plan 06 1 : 100

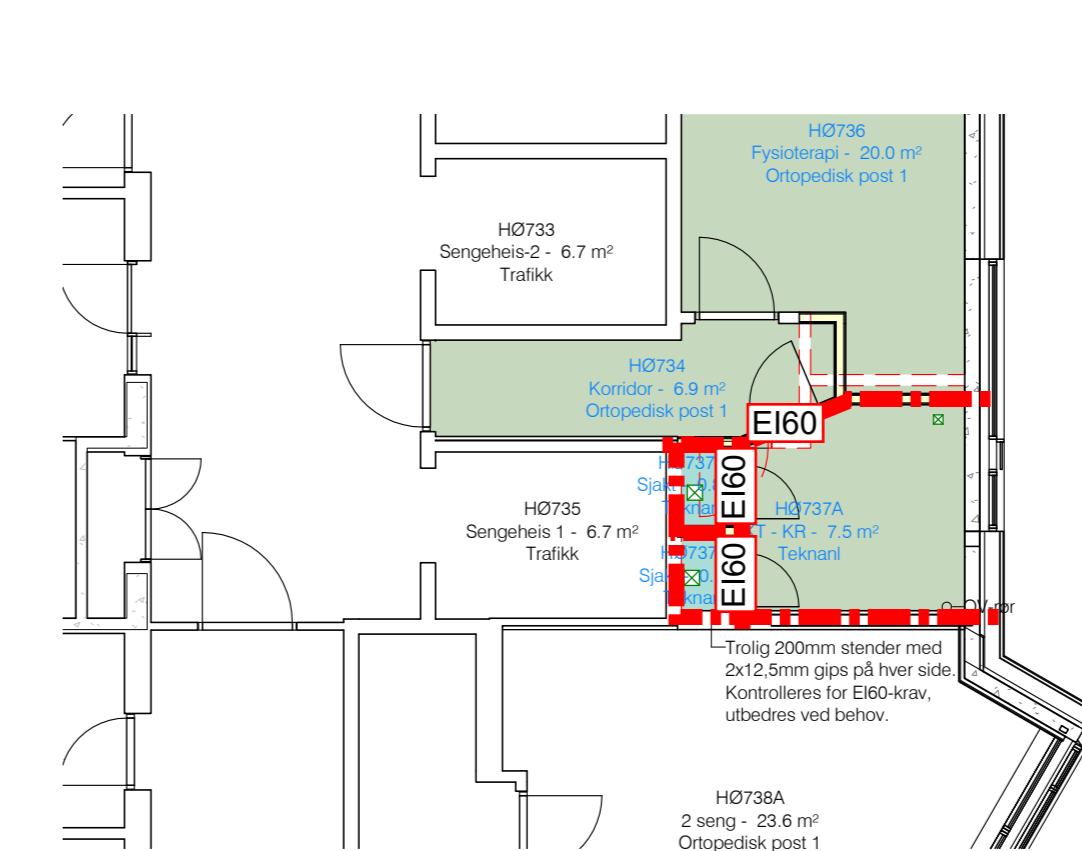

HØ - Plan 07 1 : 100

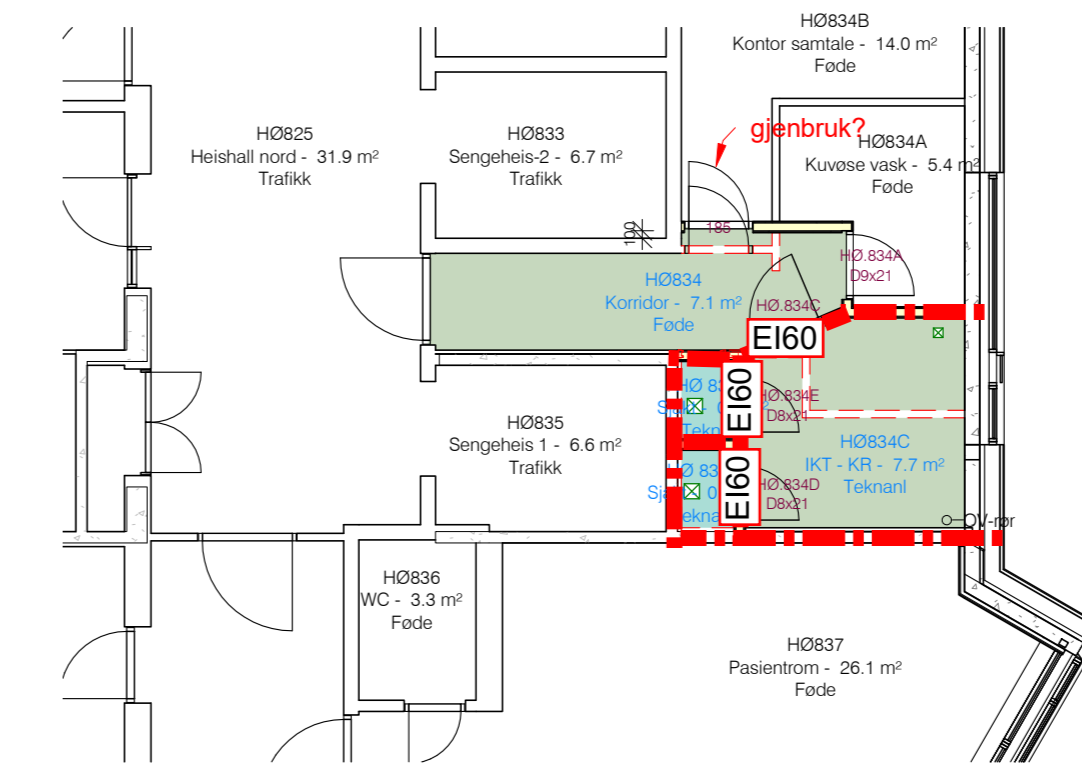

HØ - Plan 08 1 : 100

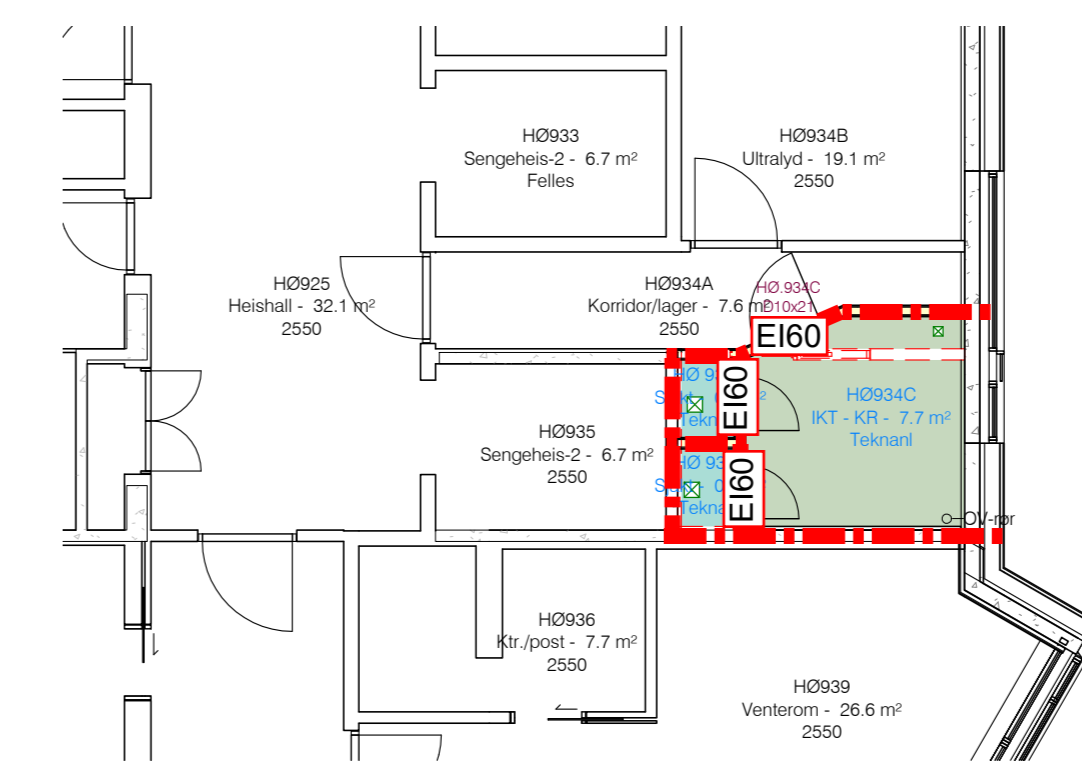

HØ - Plan 09 1 : 100

Symbolforklaring:
Ei 60 A2-s1,d0

Dører:
Ei 60 I
Ei 60 Sa

Antet:
Tegningen er å anse som konsepttegning og skal leses sammen med tilhørende brannnotat/-konsept. Tegningen har ikke status som byggetegning.