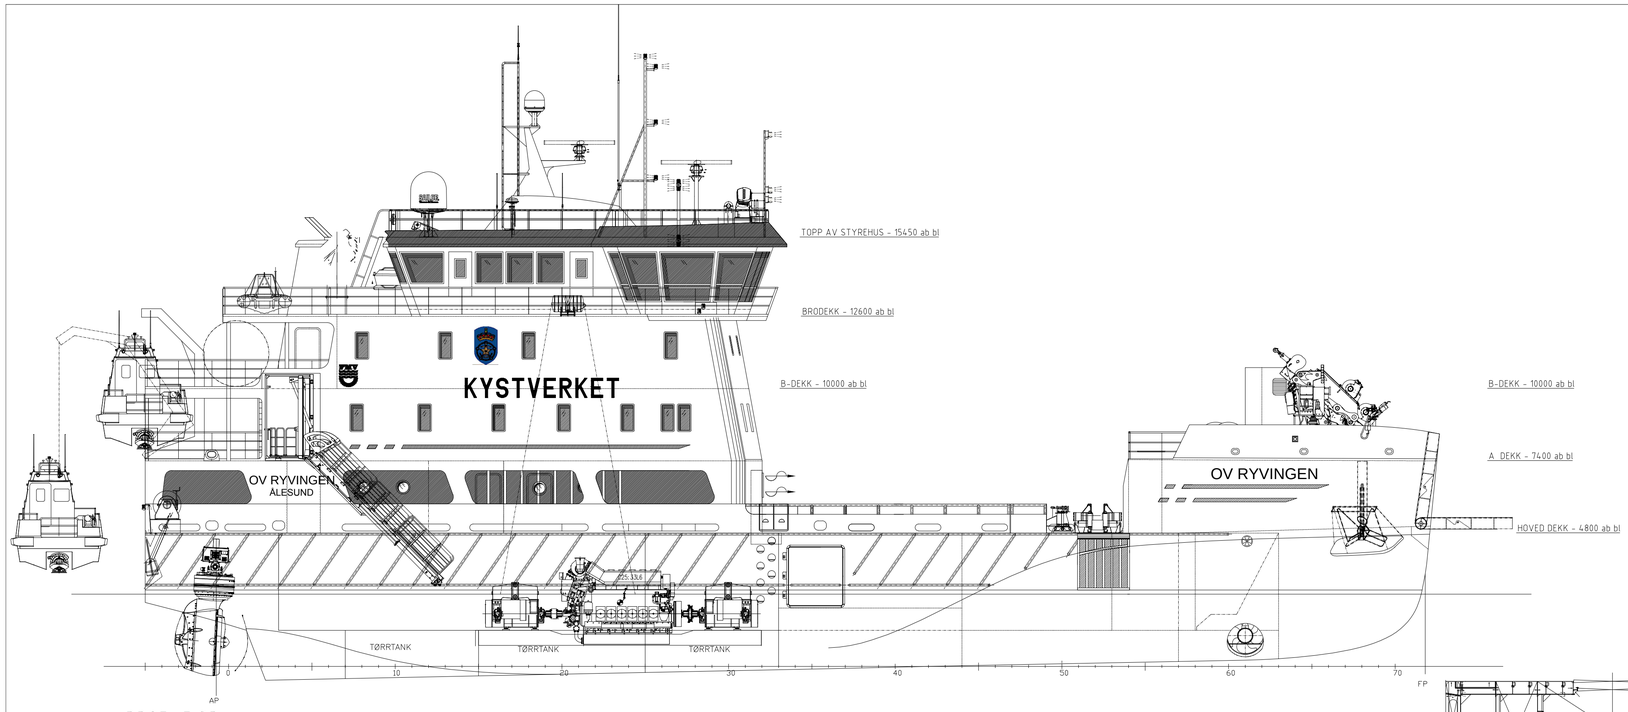

PROFILE SB

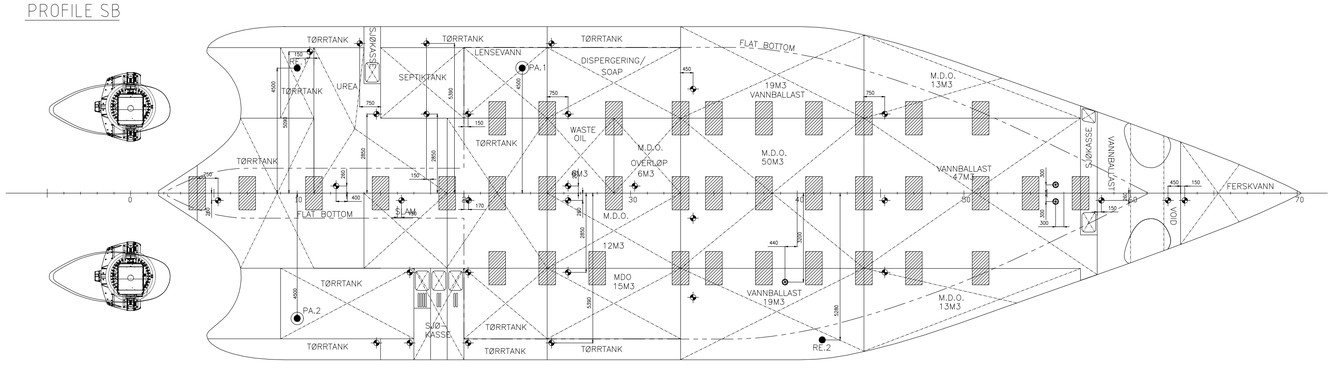

UNDER TANK TOP

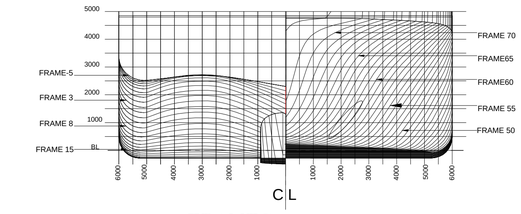

FRAMES

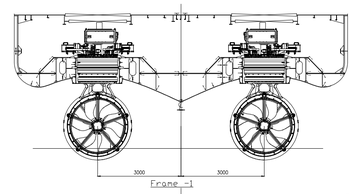

Frame -1

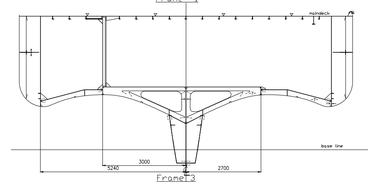

Frame 3

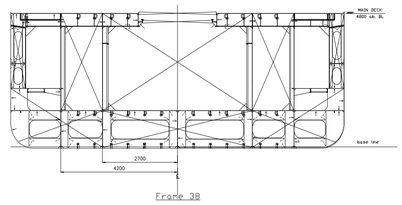

Frame 38

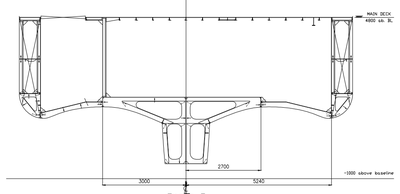

Frame 5

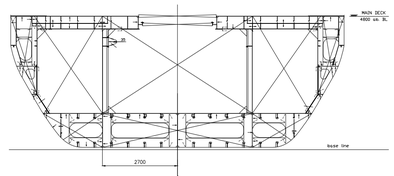

Frame 49

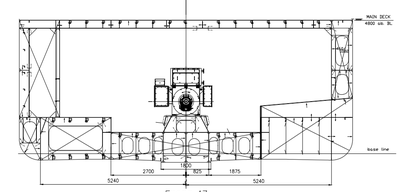

Frame 17

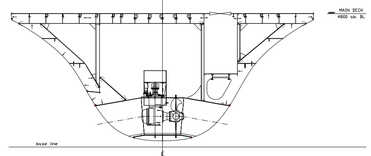

Frame 61

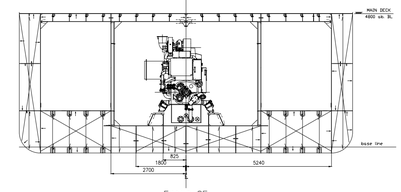

Frame 25

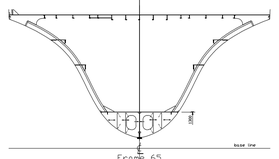

Frame 65
Stiffeners: 275x8 UNO

31 OFF BOTTOM PLUGS ACC. TO NS 2573

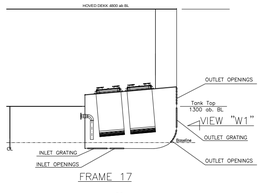

FRAME 17

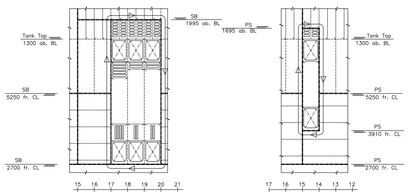

"W1" VIEW ON SHELL SB

"W3" VIEW ON SHELL PS

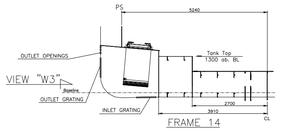

FRAME 14

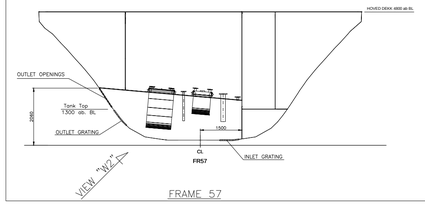

FRAME 57

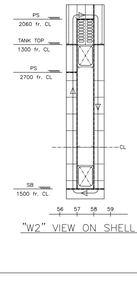

"W2" VIEW ON SHELL PS

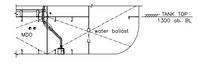

FRAME 40-440

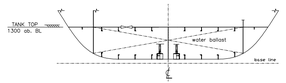

FRAME 55+300

ICCP SYSTEM

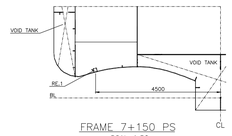

FRAME 7+150 PS
SCAL 1:50

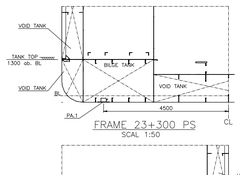

FRAME 23+300 PS
SCAL 1:50

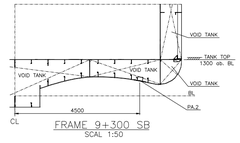

FRAME 9+300 SB
SCAL 1:50

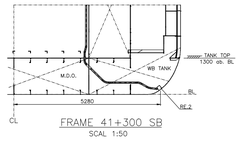

FRAME 41+300 SB
SCAL 1:50

HOVEDDIMMENSJONER

LENGDE OVER ALT:	46.60 m
LENGDE MELLOM PERP:	43.00 m
BREDDE PÅ SPT:	12.00 m
DYBDE I RISS:	4.80 m
SPANTE AVSTAND:	0.60 m

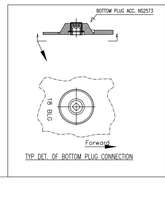

TYP DET. OF BOTTOM PLUG CONNECTION

REV.	TEXT	DATE	SIGN.
B	As built.	22.11.2018	BM
A	UPDATED BOTTOM PLUGS & ECHO SOUNDER POSITIONS ACC. TO OWNER/SHIPYARD COMMENTS	10.01.2018	M.Ku.

DATE: 07.12.2017 DRAWN: WK SCALE: 1:75
DATE: CHECKED:

ACCORDING TO INTERNATIONAL LAWS, THIS DRAWING IS THE PROPERTY OF FITJAR MEKANISKE VERKSTED AS AND HEIMLI SHIP DESIGN AS. THE DRAWING CAN NOT BE MADE PUBLIC, COPIED OR OTHERWISE USED, WITHOUT OUR WRITTEN CONSENT.

Heimli ship design

Napier AS

DWG. NO. 0351-144-001 REV. B

Fitjar Mekaniske Verksted AS
5419 Fitjar, Norway
Tel: +47 53 45 72 00
Fax: +47 53 45 72 20
www.fmvas.no

TITLE: Docking plan

FILE: 0351-144-001 PLOT: SHEET: 1/1 FORMAT: A0 PROJECT: DESIGN: