


Hattilsynet

101 - 120 } Hattilsynet
138 - 140 }

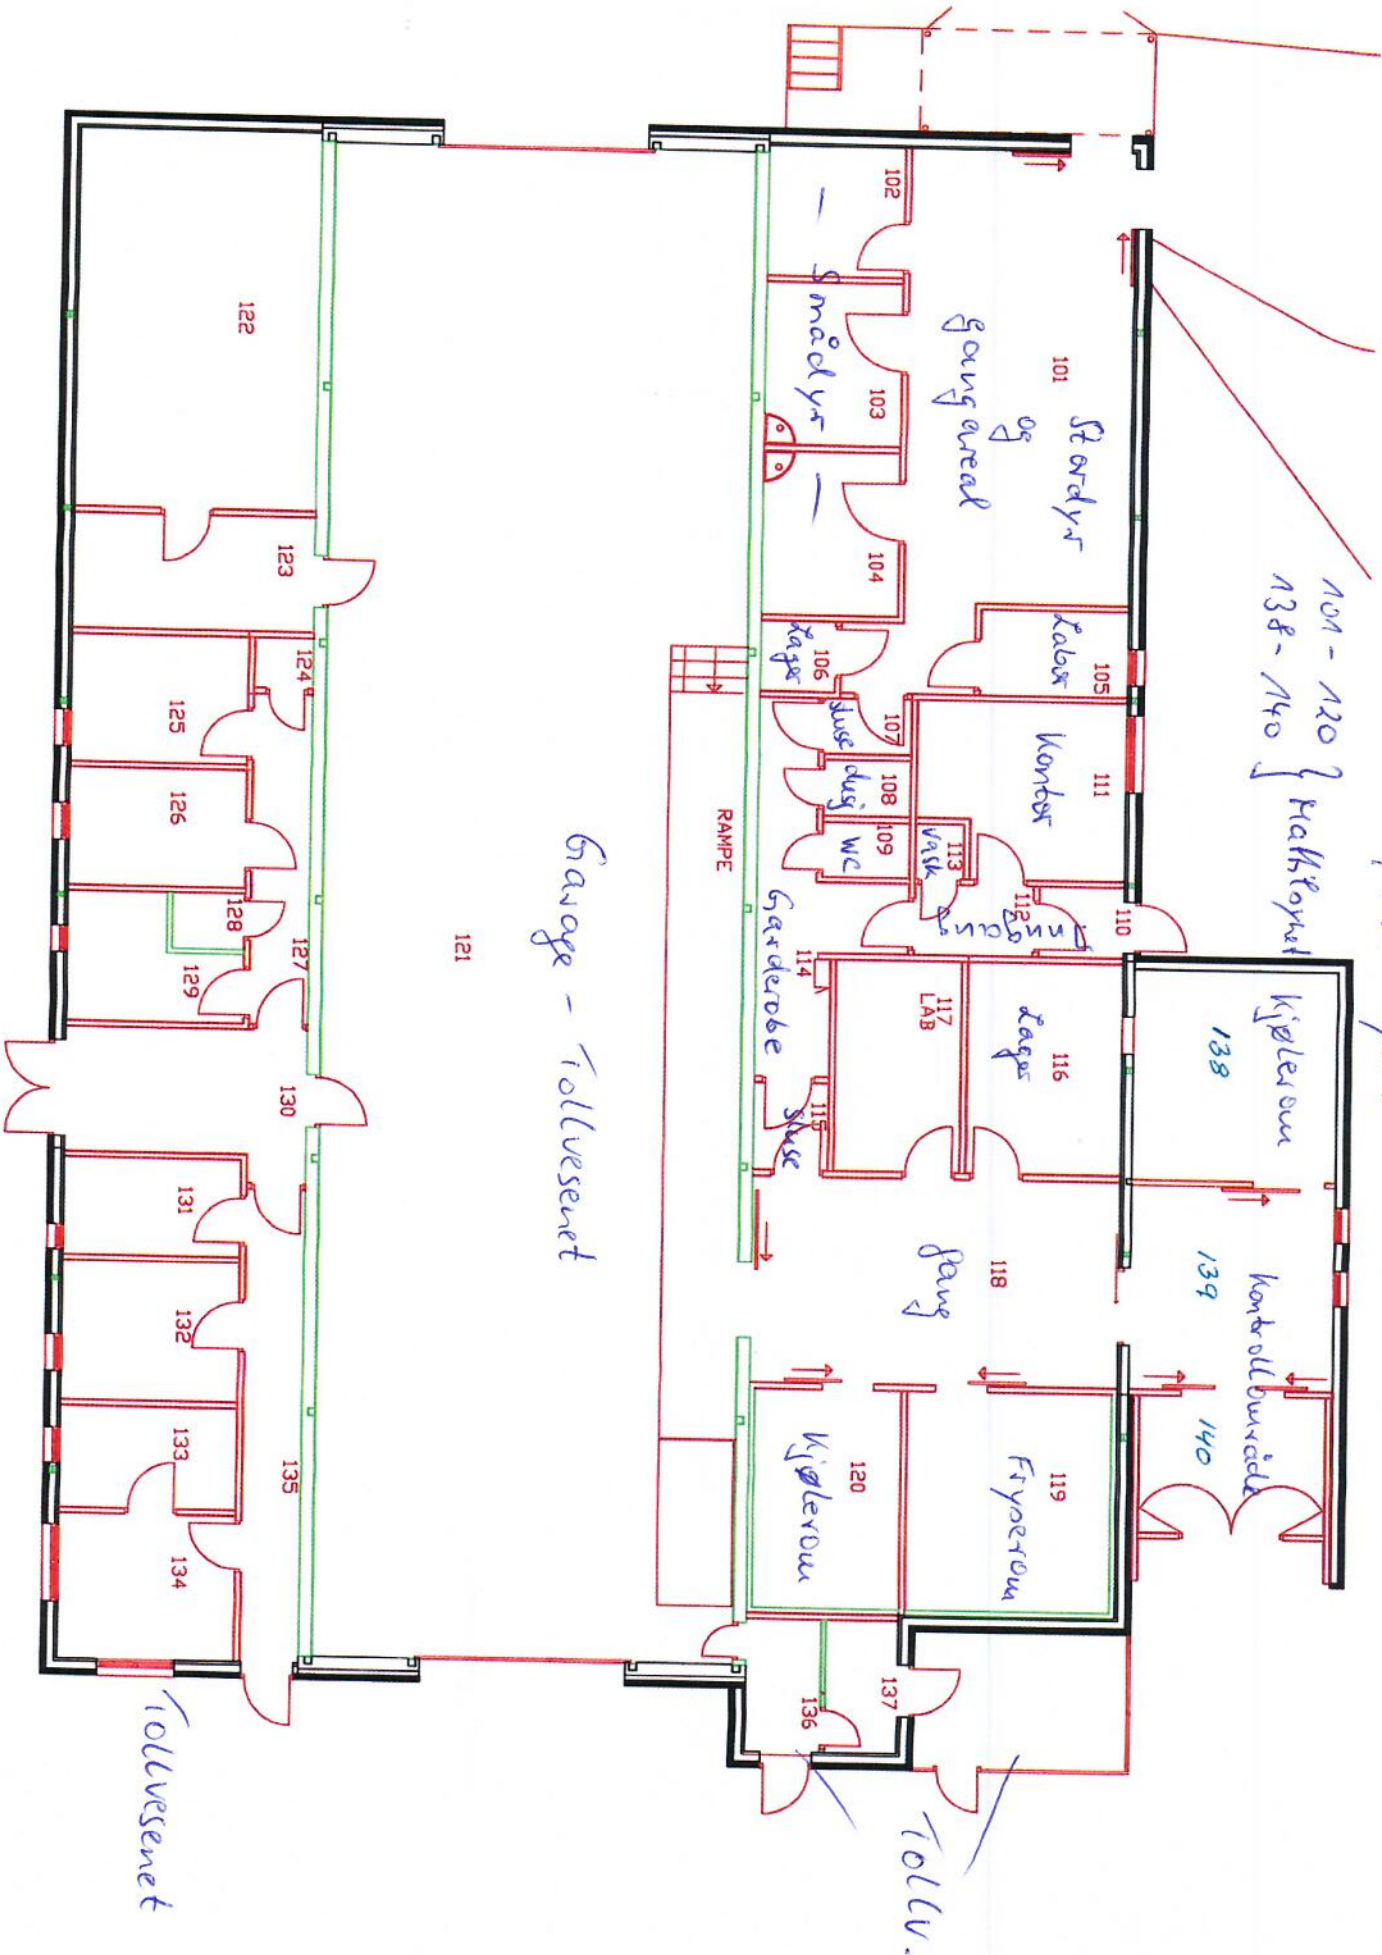


Tollvesenet

Tollv.

101-120 } Mathislynet
138-140 }

