


Vinduer i Arkiv.

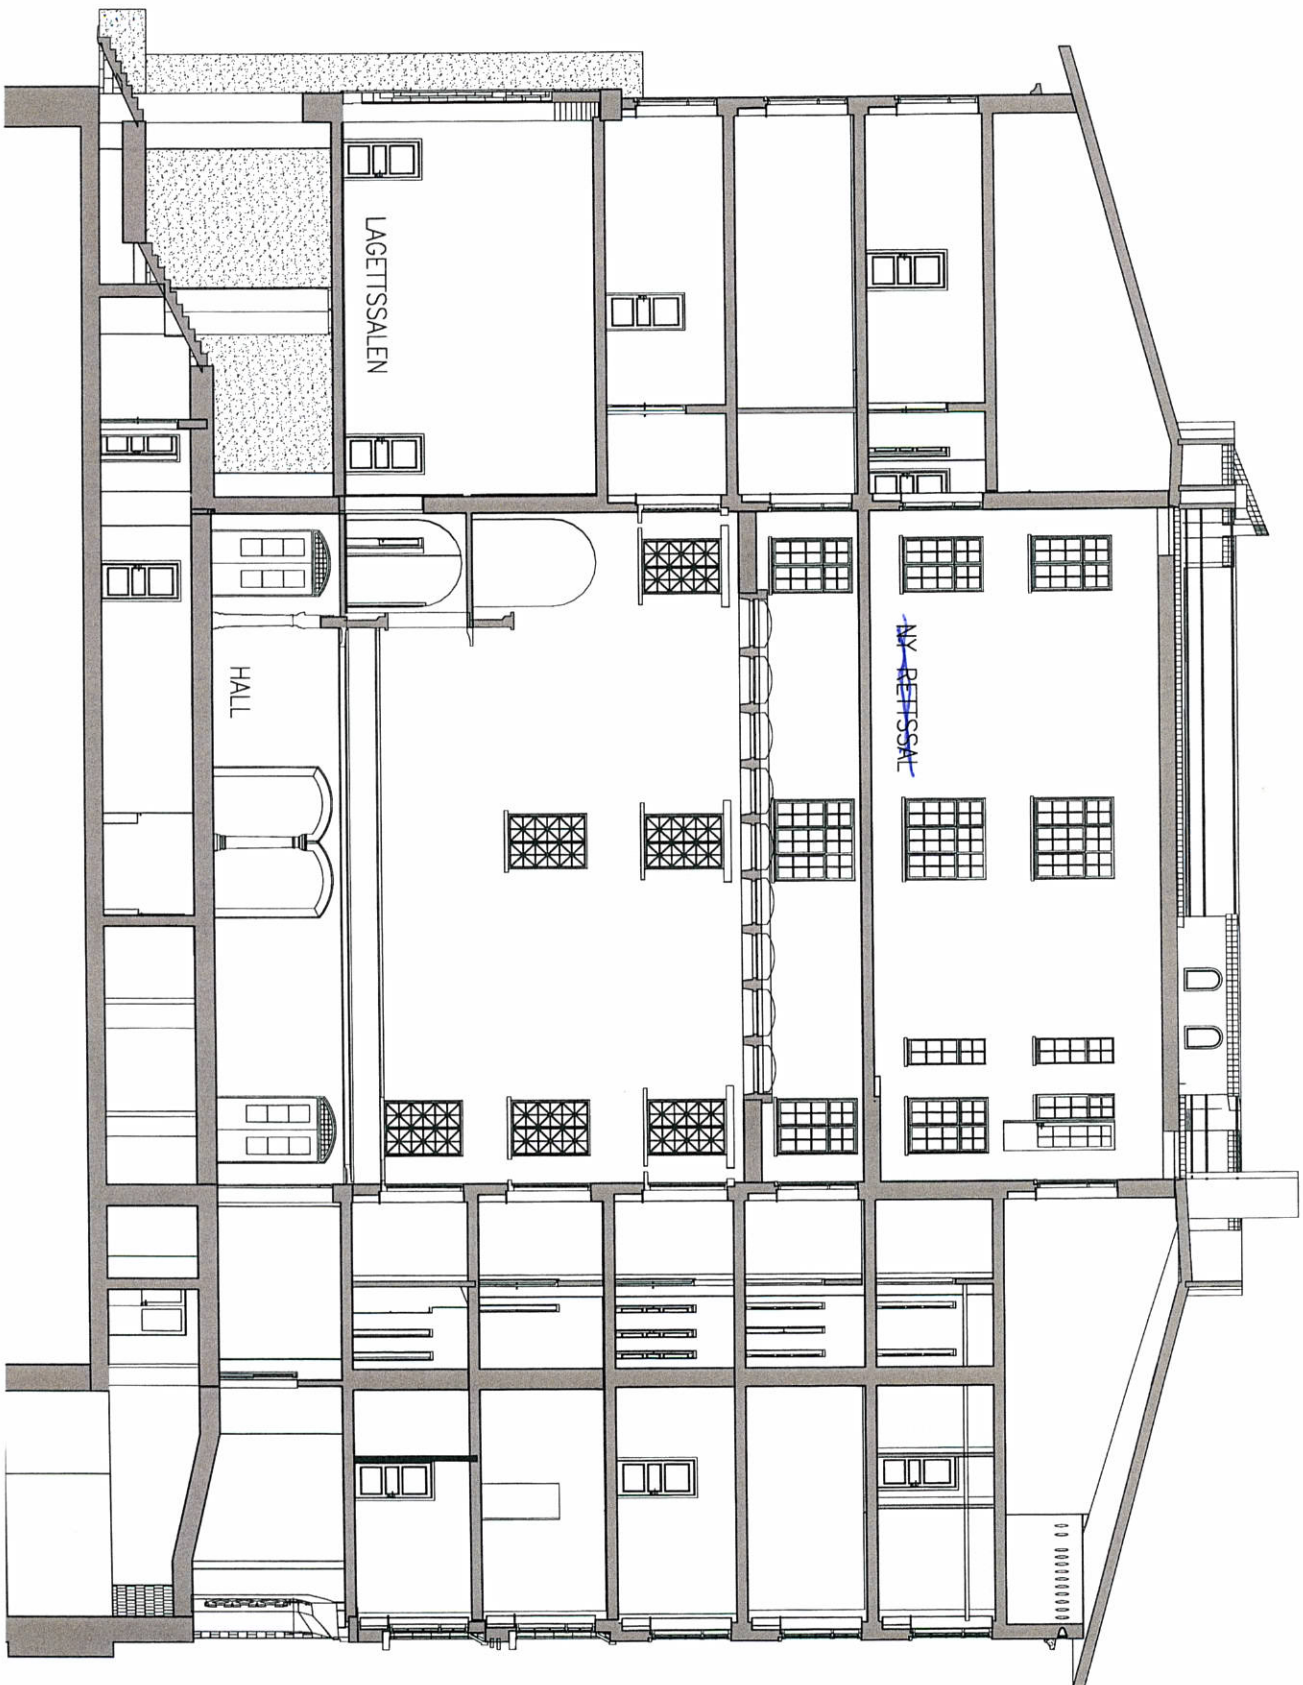

3 FRA TARNPLASS

- 7. etg
- 6. etg
- 5. etg
- 4. etg.
- 3. etg
- 2. etg
- 1. etg
- Kjeller
- underetasje