




forslag endring adkomst boliger Midtmoen

Dato: 21.06.2022

Målestokk: 1:1000

Koordinatsystem: UTM 32N

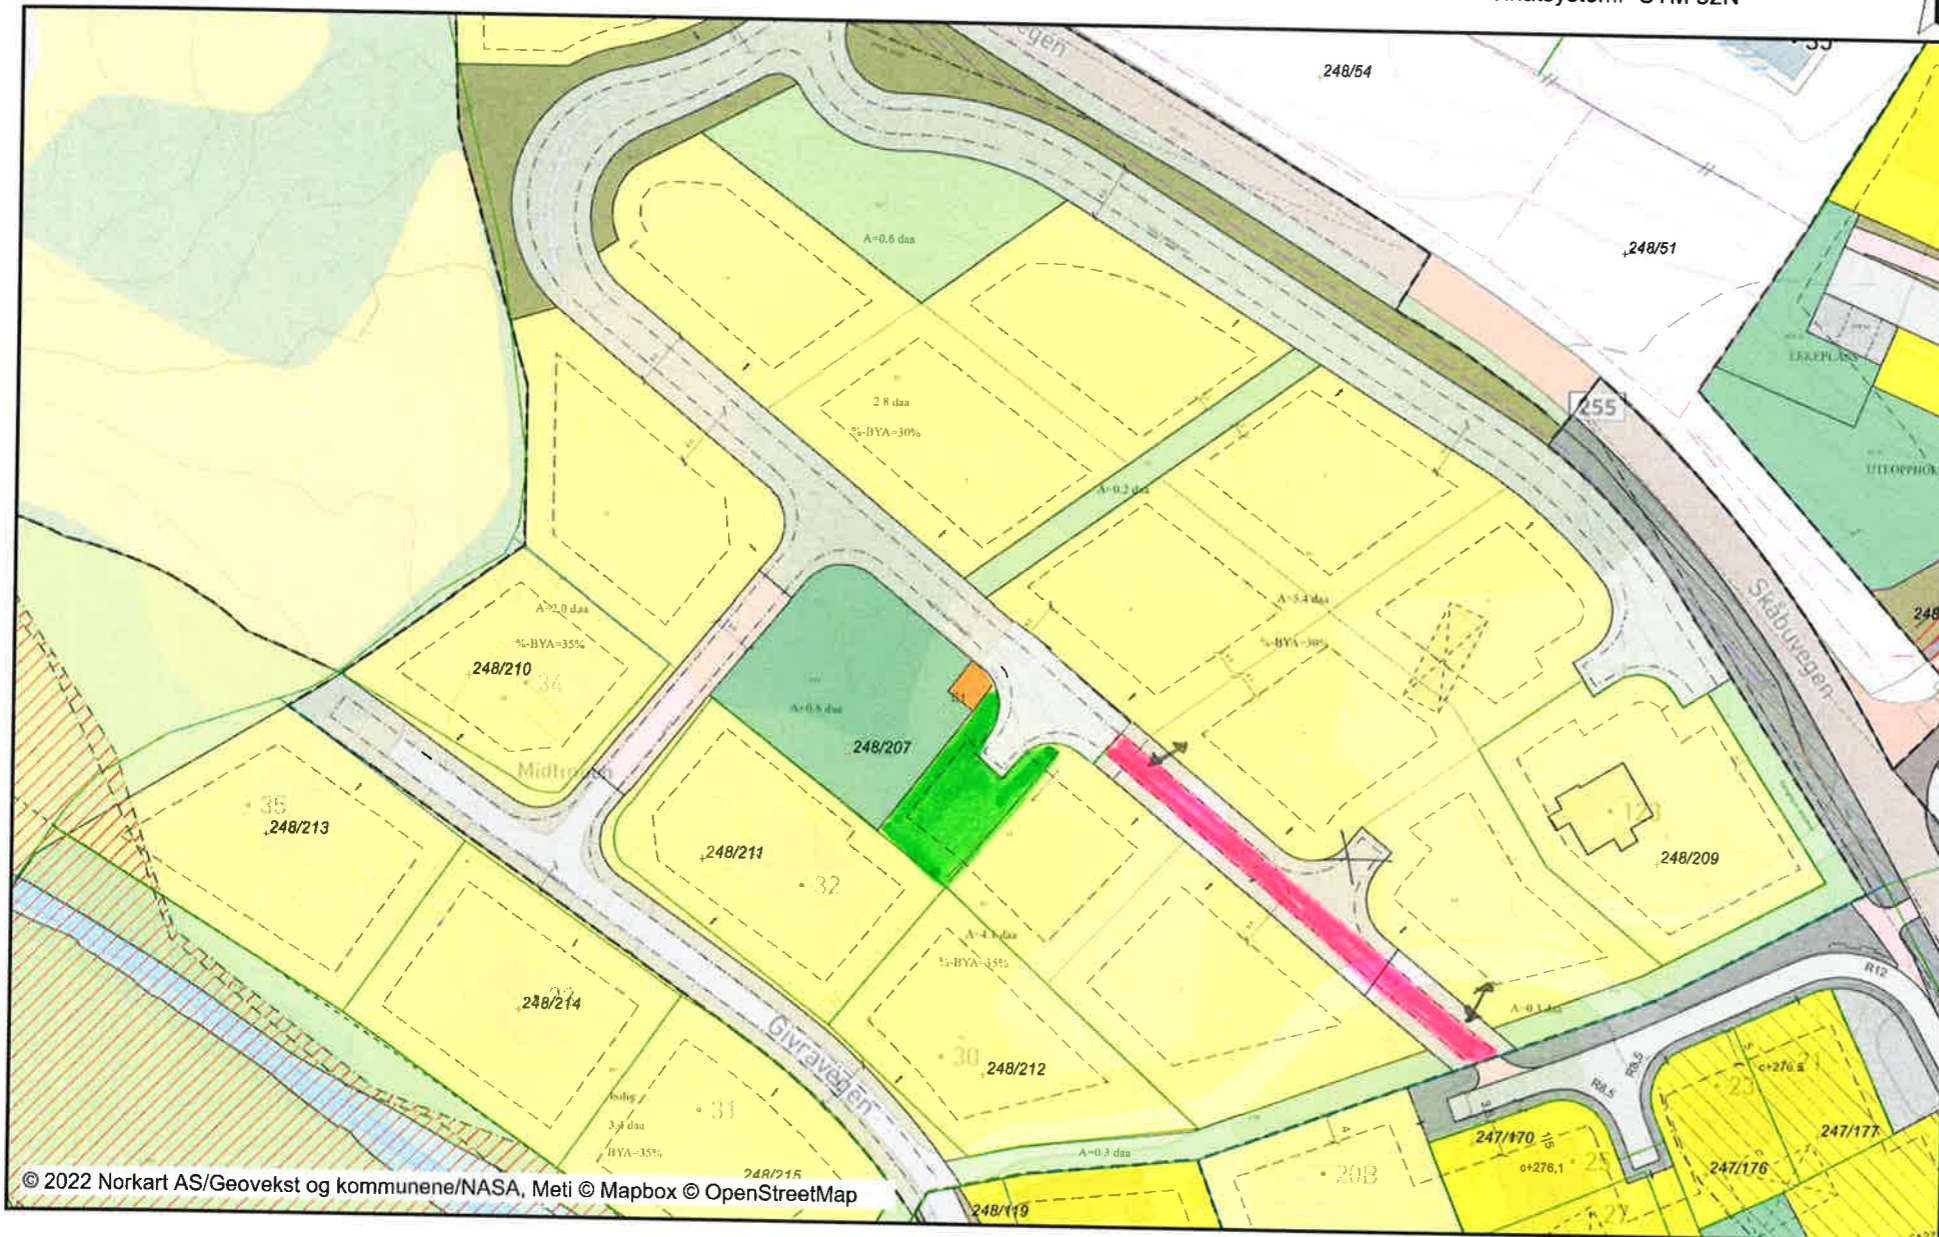

© 2022 Norkart AS/Geovekst og kommunene/NASA, Meti © Mapbox © OpenStreetMap

 G/S-veg