

Lichtkass

16 x 11,5 m
USEINDE FASSE


1:100
1 cm = 1 m

1971
ARKHIT. ZY

16 m

FASADE

11,5 m

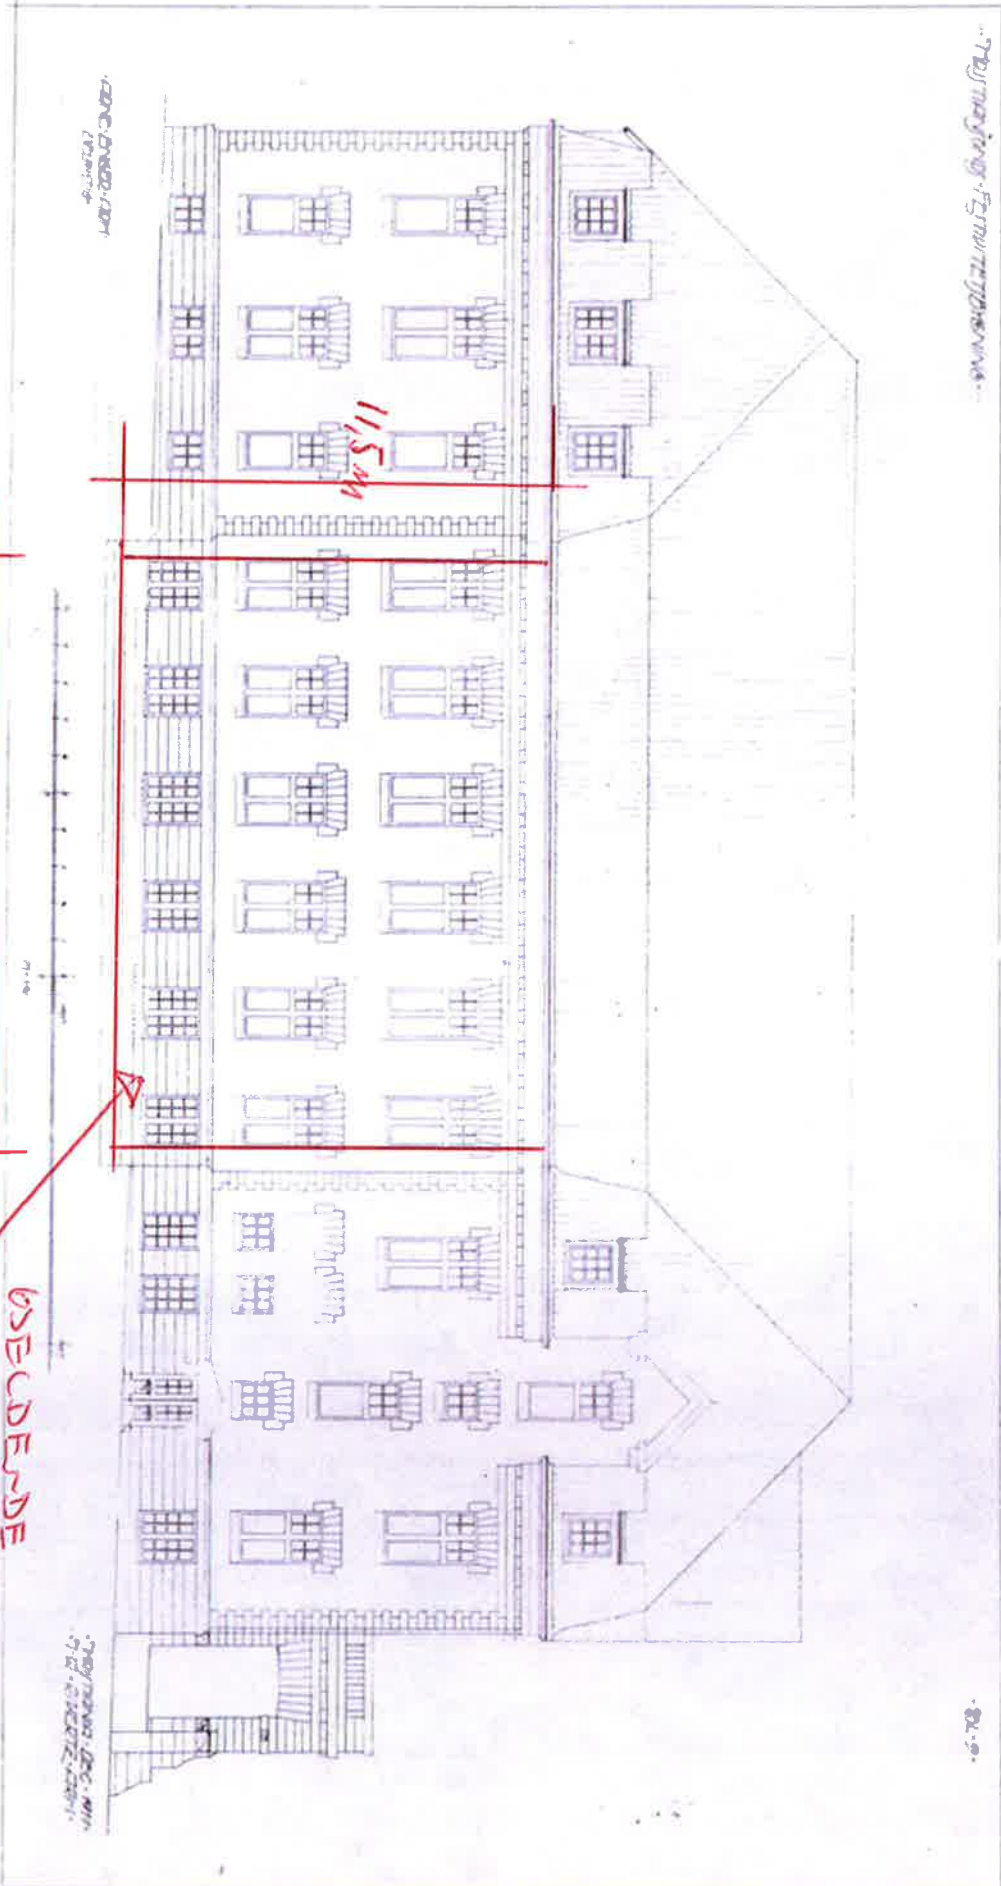

FASADE
1:100

1:100

1:100