


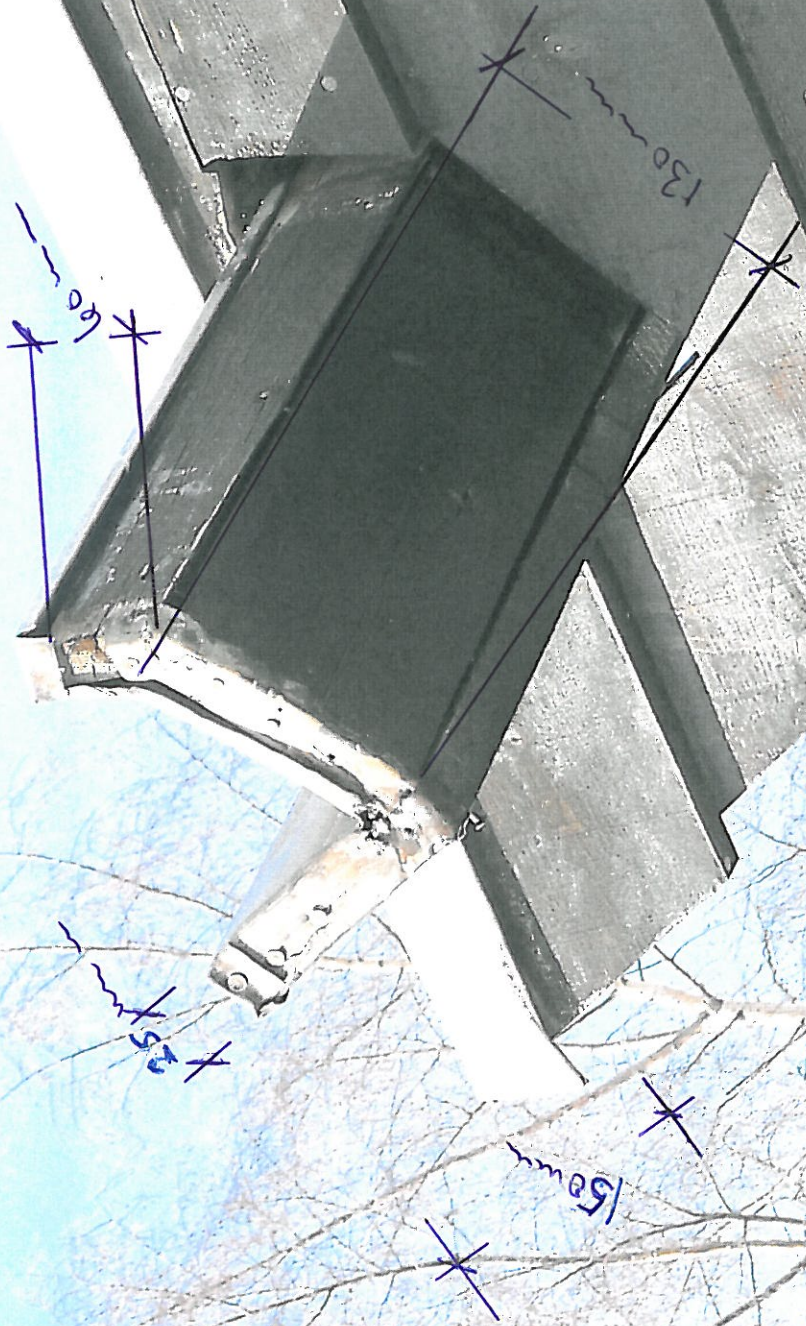

Bilde 1.



BILDE 2







Bredde 240 mm

