




H5-ANIEGG
3 KANT (UTVINKELSEK)

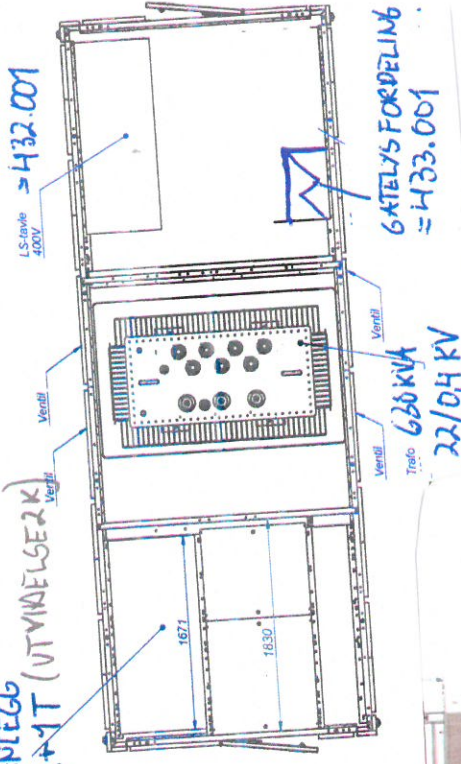

LS-stavle = 432.001
400V

6-ATELYS FORDELING = 433.001

Trag 630 kVA
22/0,4 kV

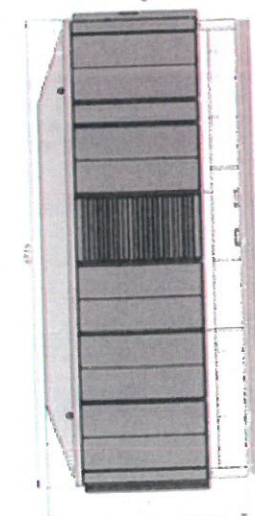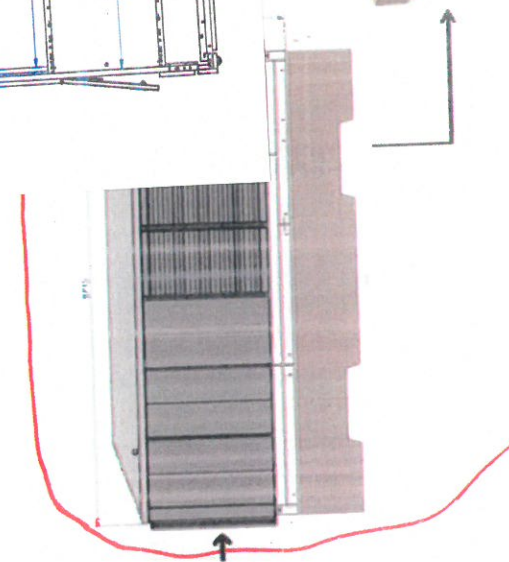

SLIK BUSKES TRAFODUS / FUNDAMENT