


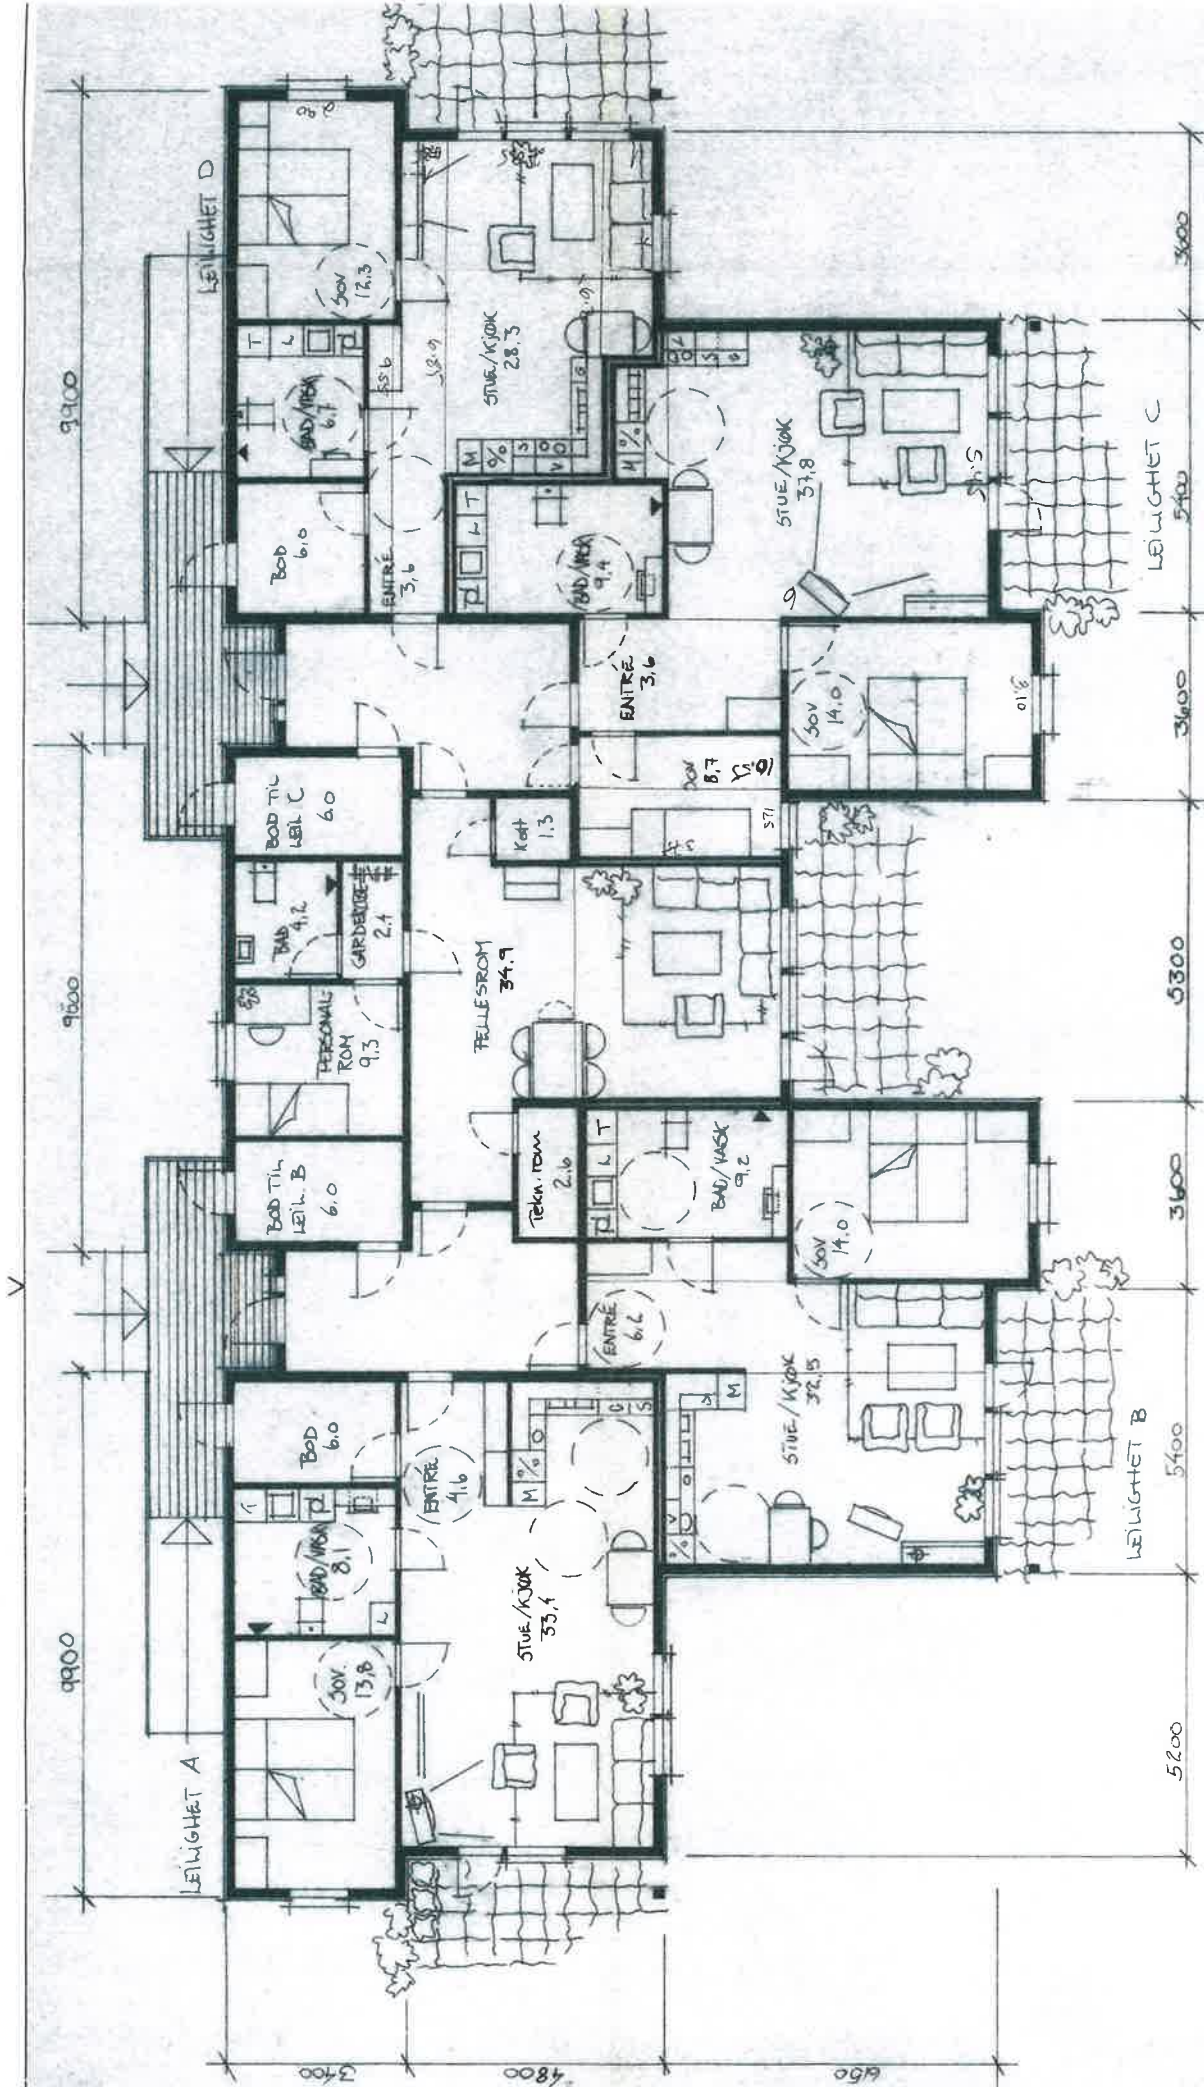

LEILIGHET	72.5	66.24	+6.6
A	65.9 m ²	BA/BRA	+6.6
B	67.9 m ²	---	+6.6
C	73.5 m ²	---	---
D	56.9 m ²	---	---
FELLESTROM	34.9 m ²	---	---
PERSONALROM	15.9 m ²	---	---

- █ - t-kjøkken rives,
- █ - bad i leilighetene -
- █ gulv og kledding rives
- █ - ny utsparring/ vegg rives
- █ - utsparring tettes
- █ - yttervegg og innervegg rives.



