


PLAN 3

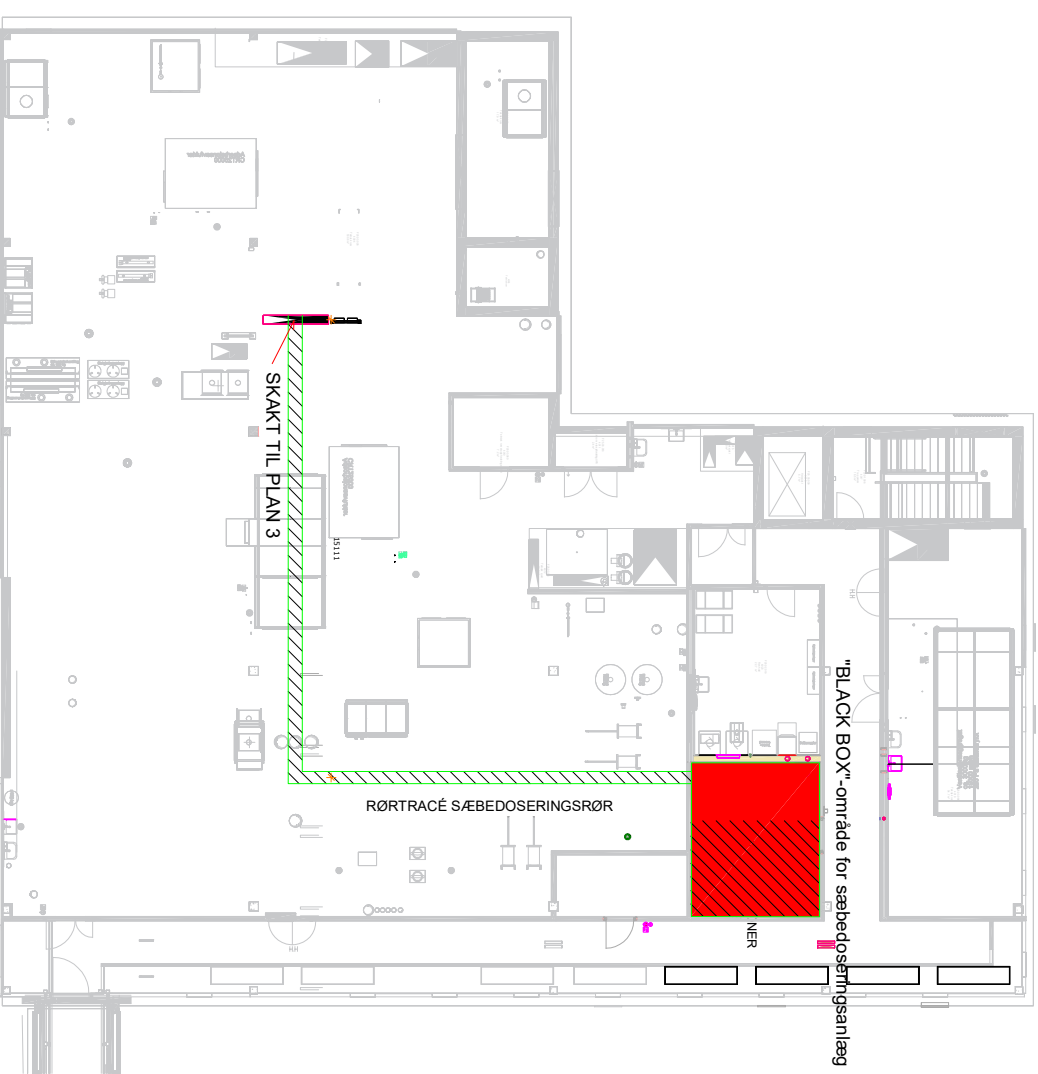

PLAN 4