


Fylkesdirektørens kontor 3B

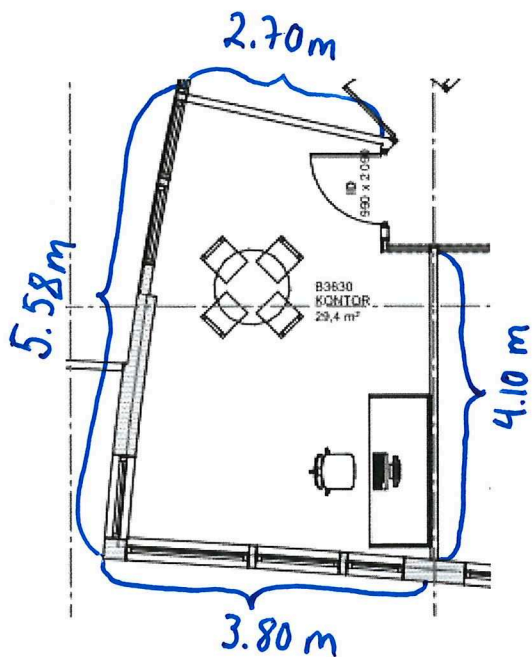

Sosialsone 3A

