

RT901




320.001 - Varmeanlegg



320.000 Fjernvarme

320.001 Hovedstokk

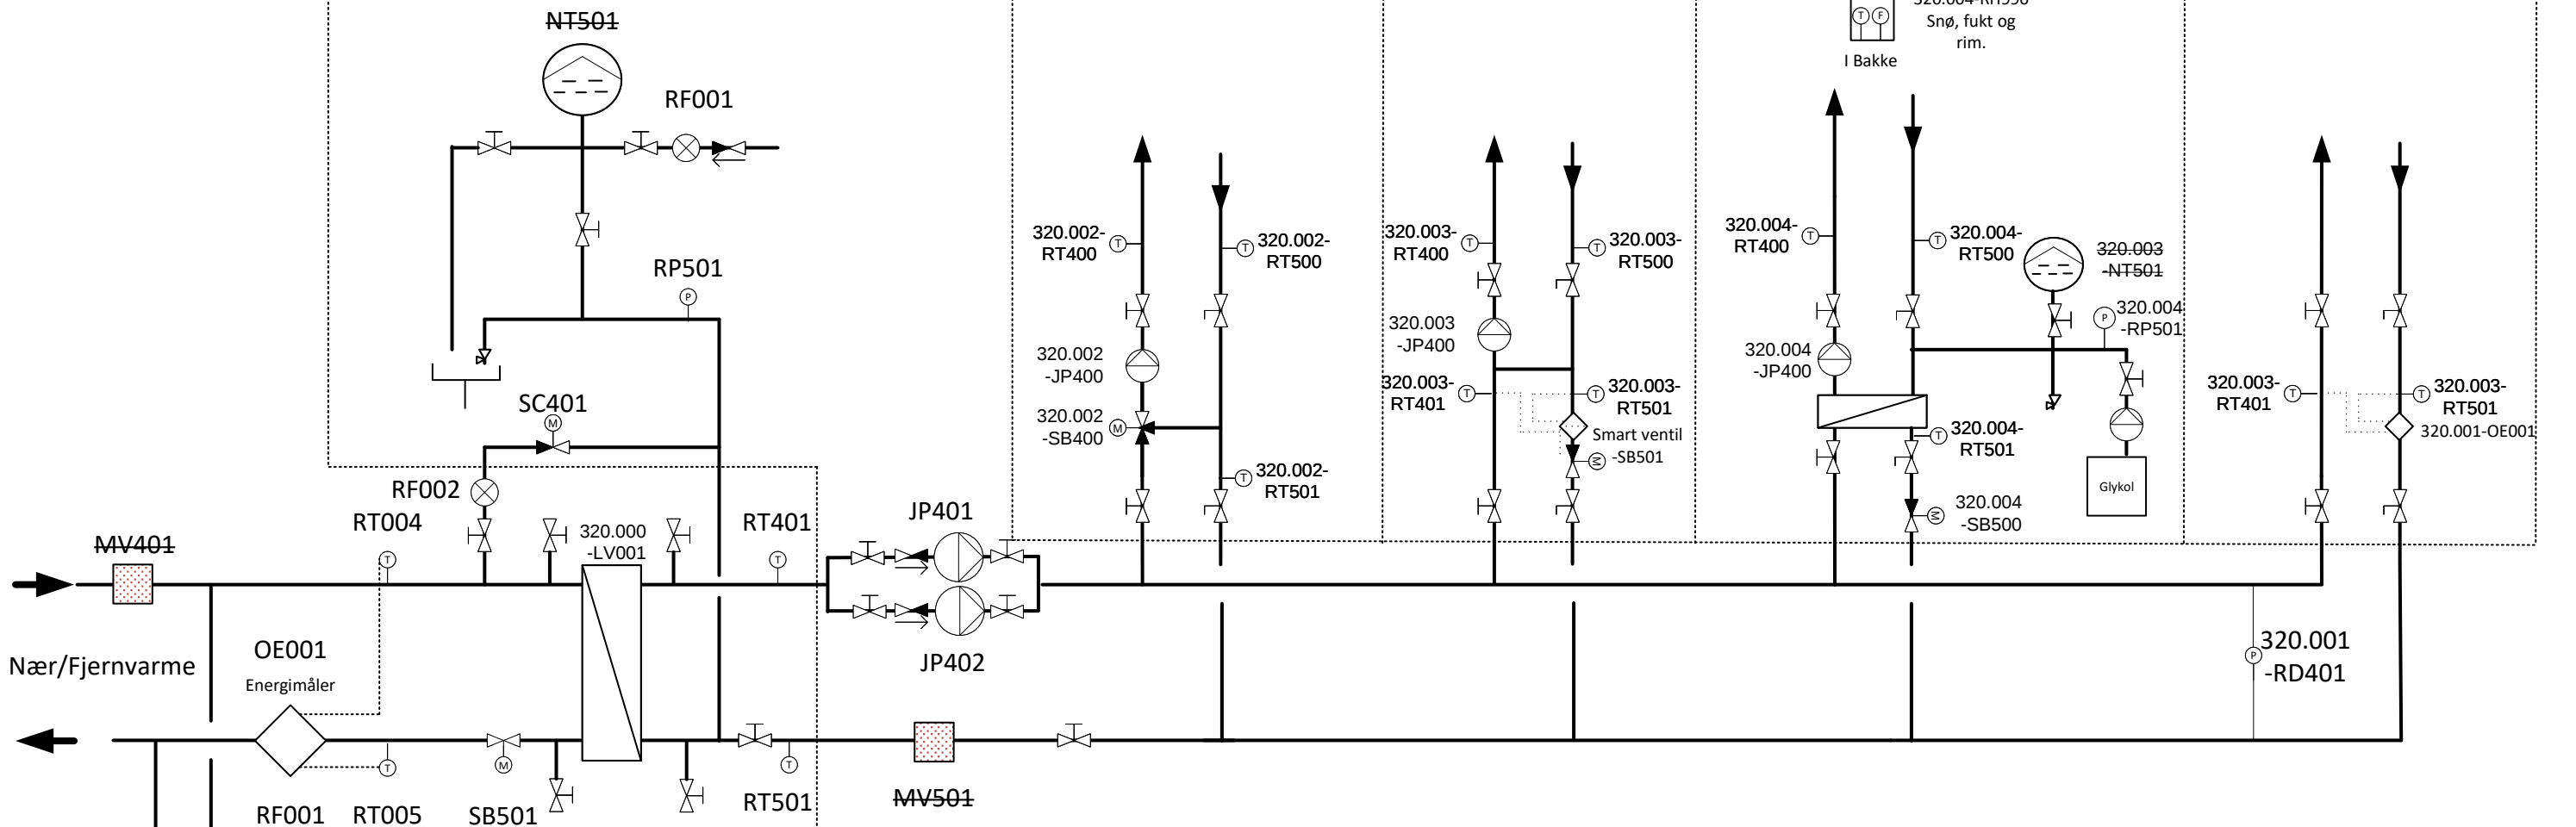

310.000 Fjernvarme

310.001- Tappevann/Beredersystem

