


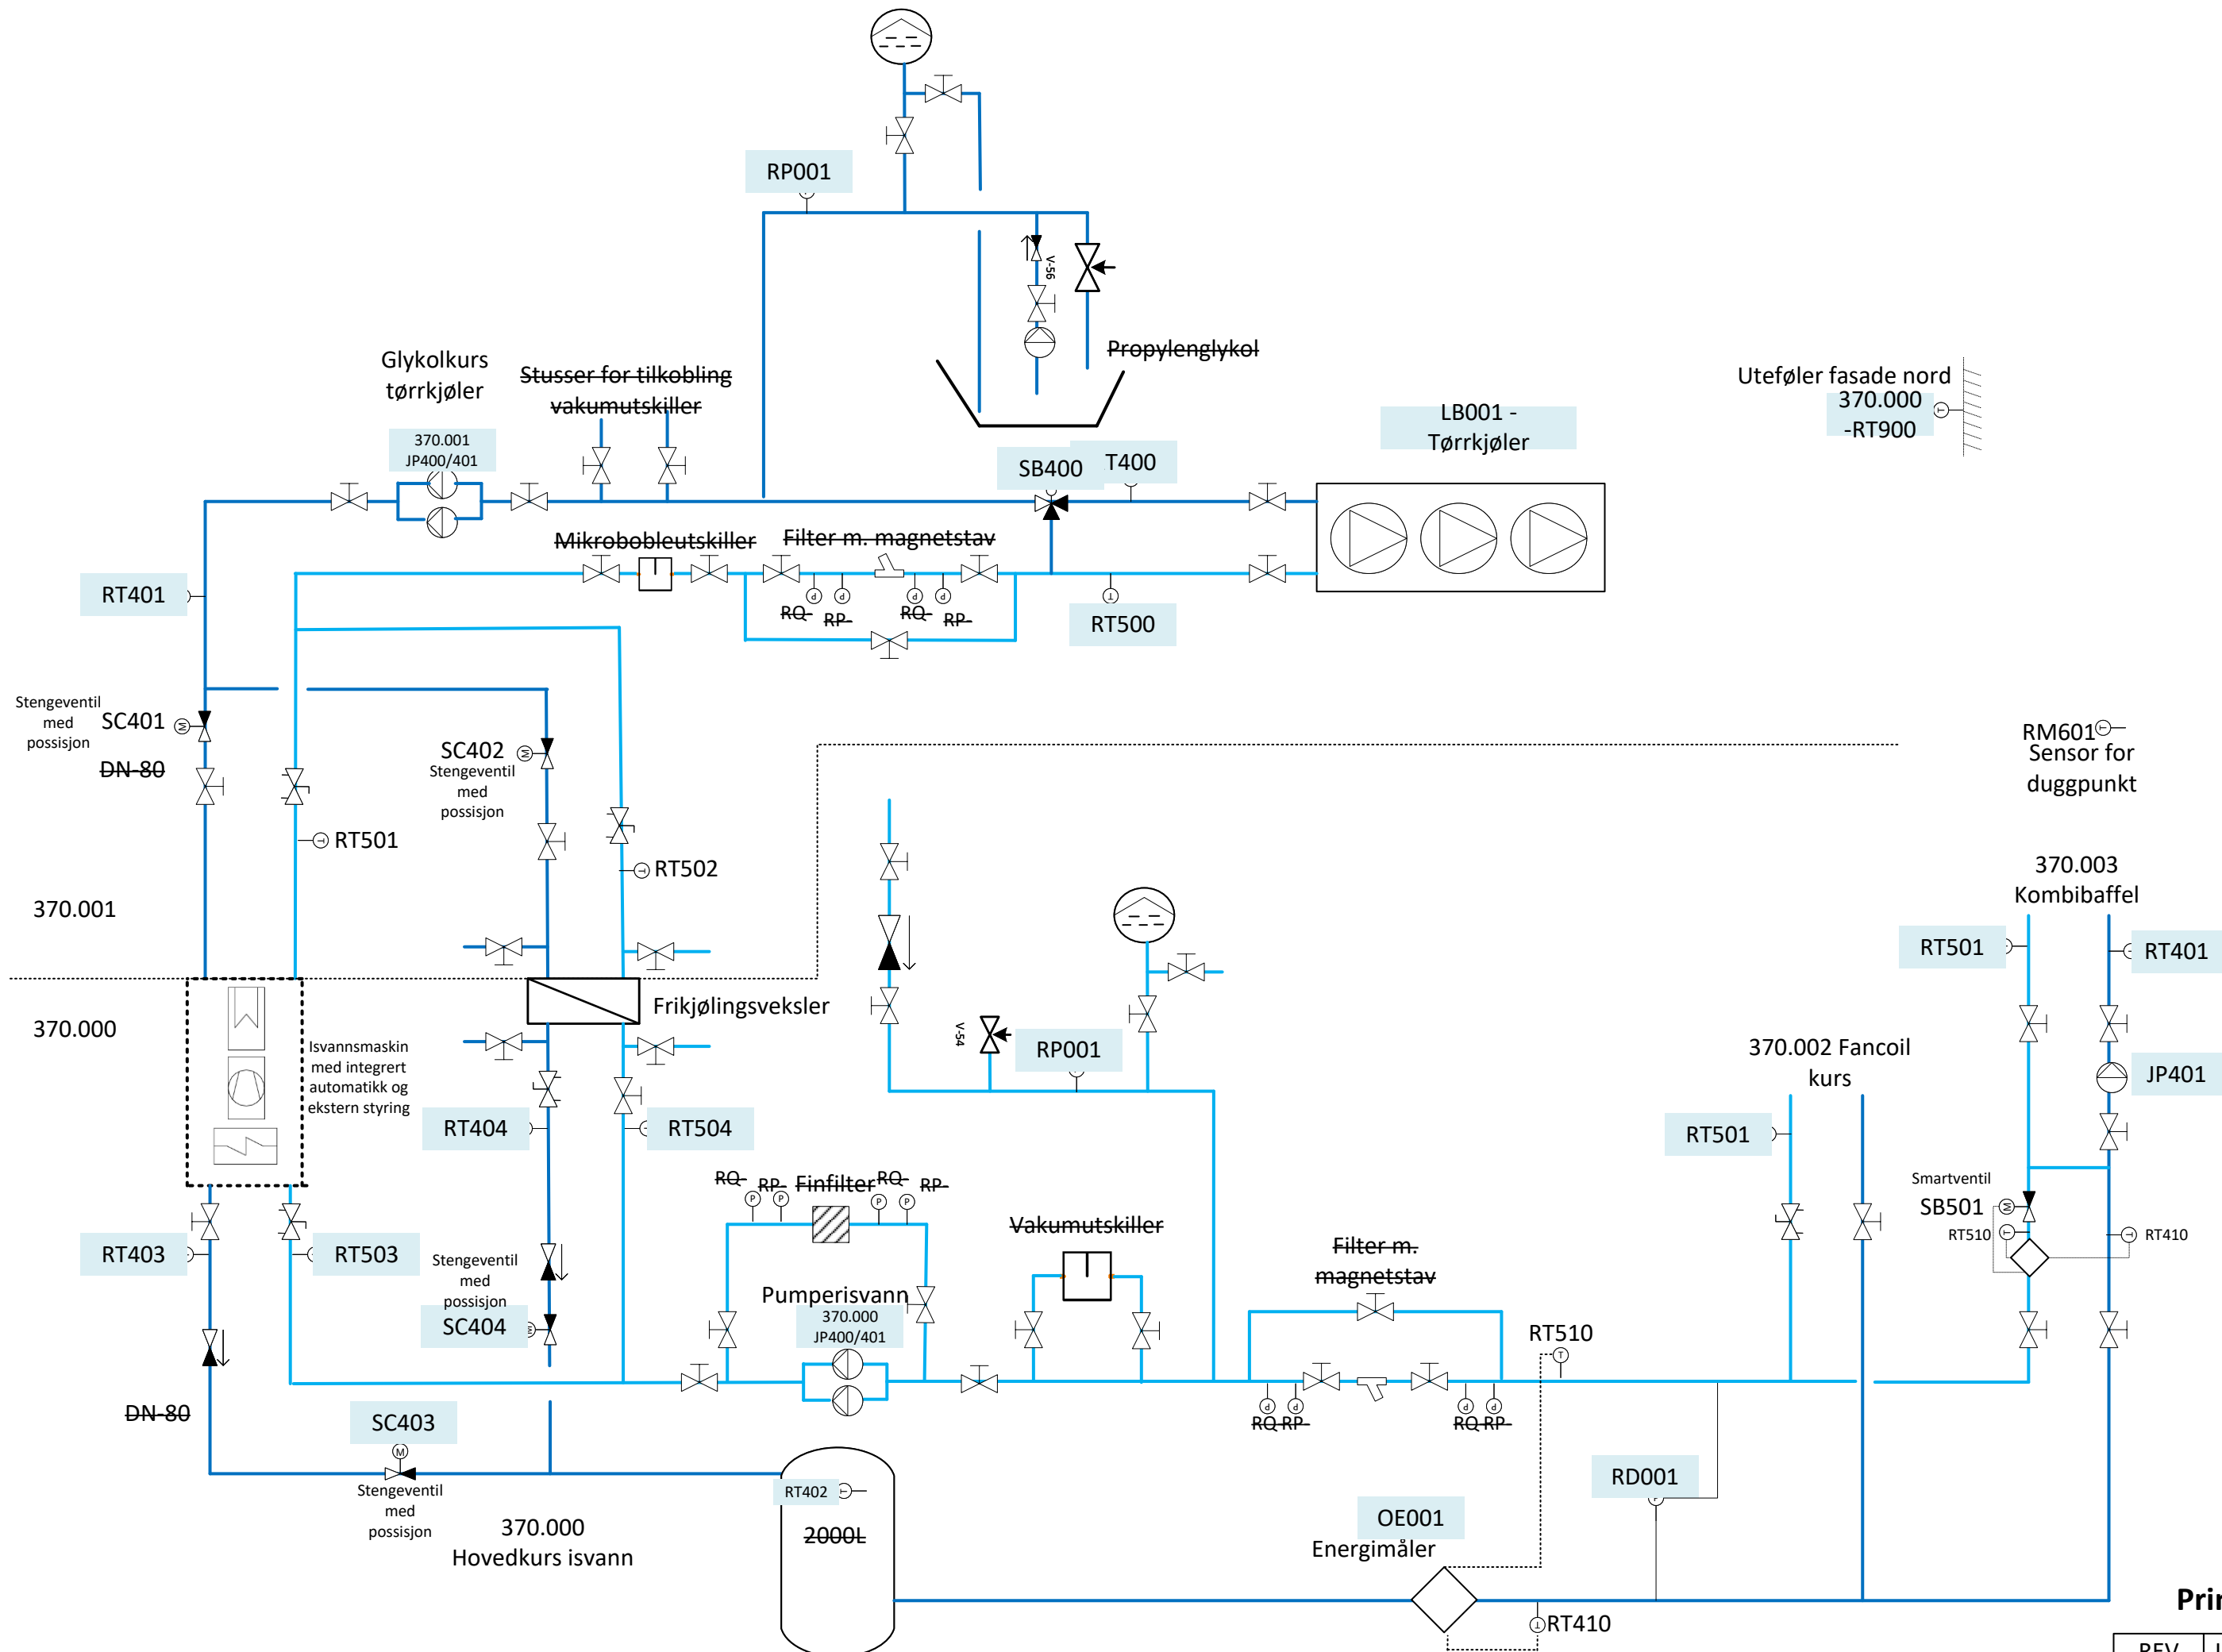

REV	LKR	29.04.2024
-----	-----	------------