



H G F E D C B A

1
2
3
4
5
6
7
8
9
10
11
12

1
2
3
4
5
6
7
8
9
10
11
12

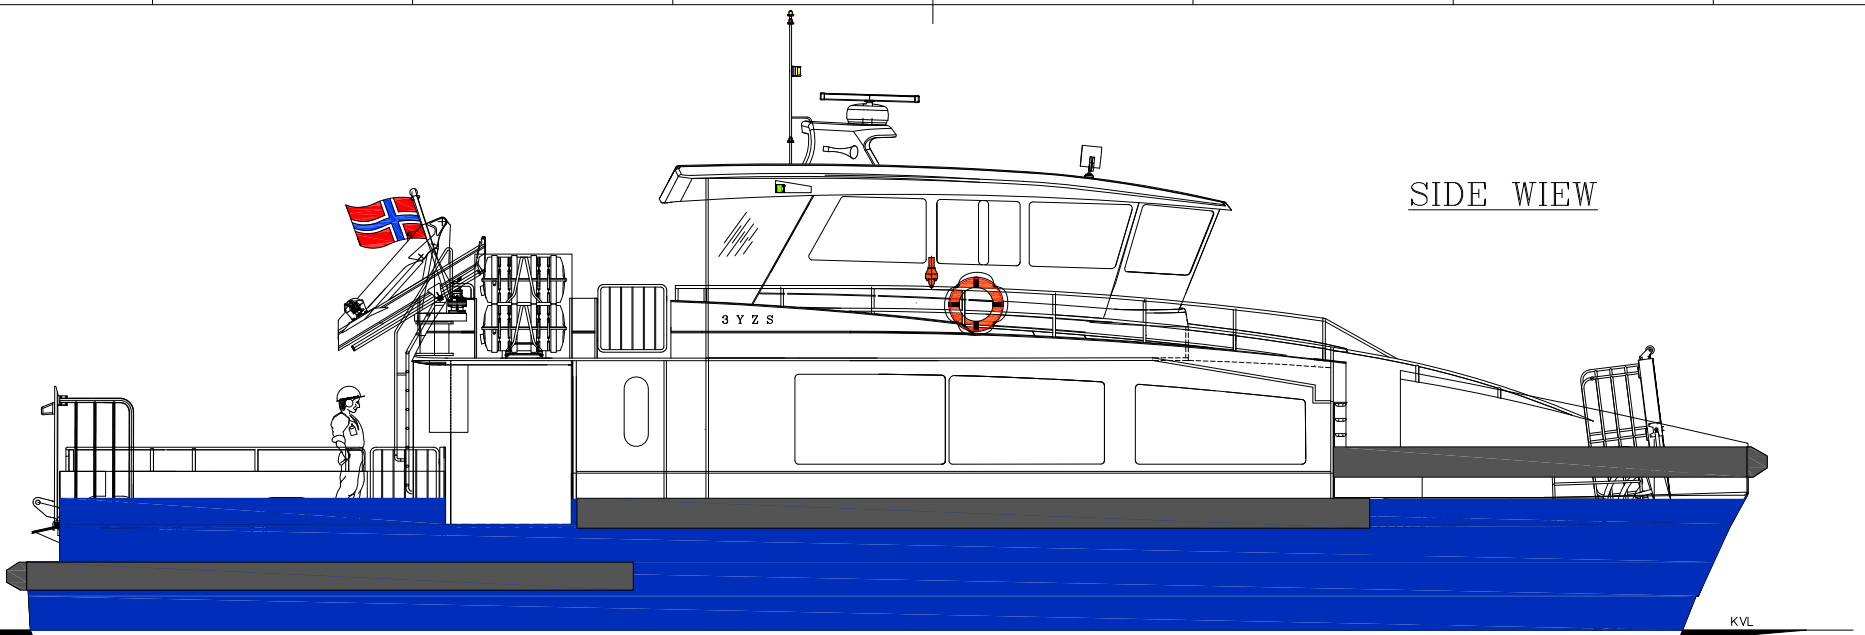


SIDE VIEW

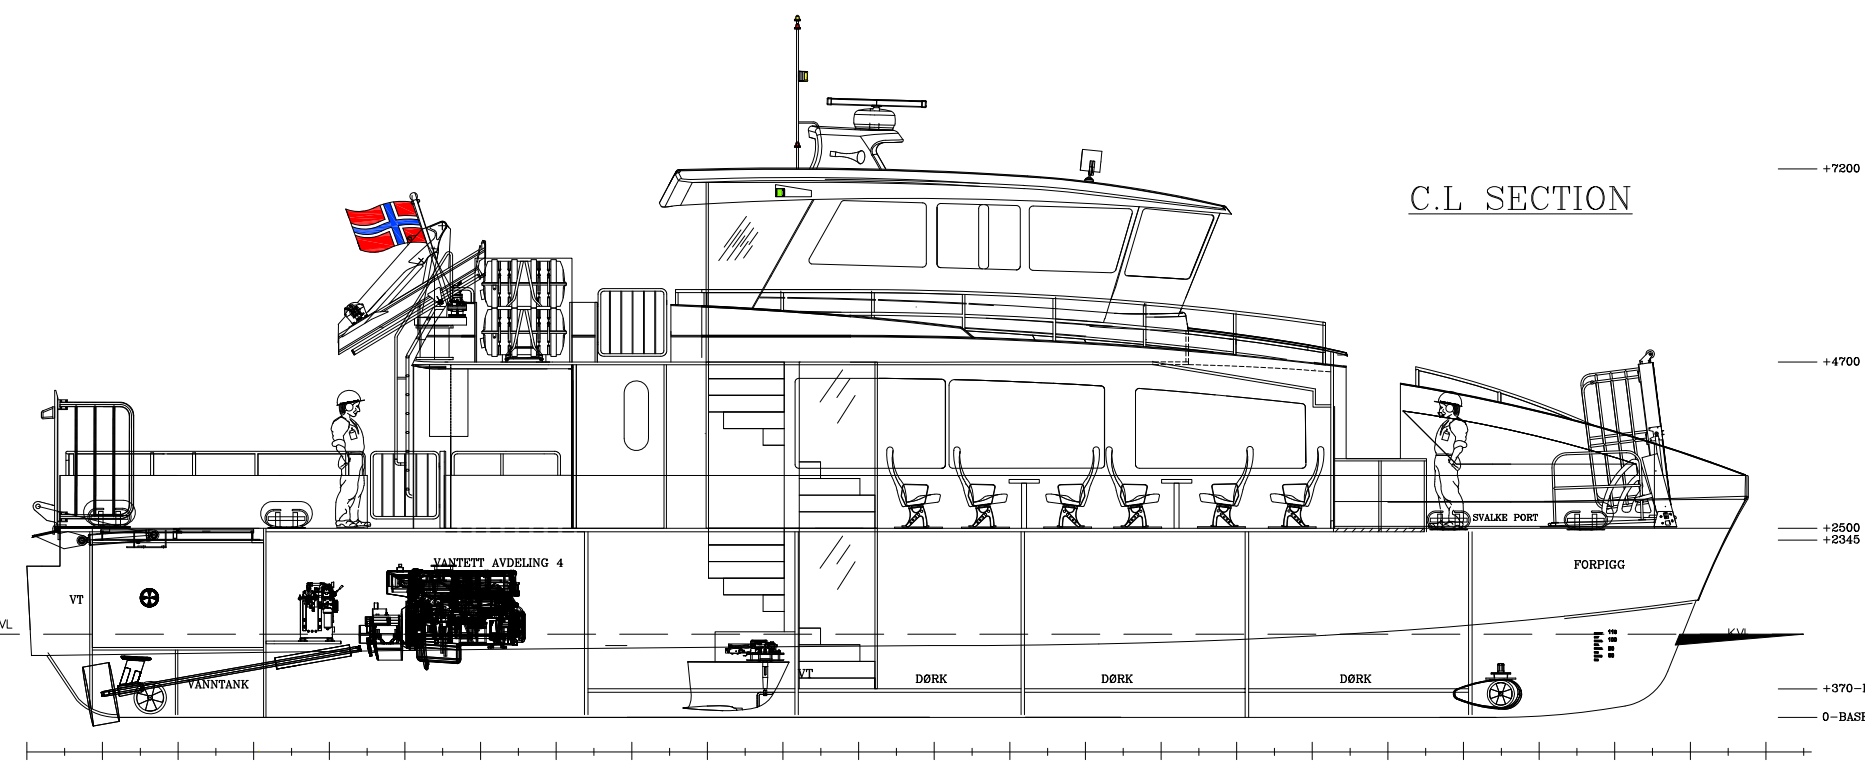


C.L SECTION

+7200 - MAST DECK
+4700 - BRIDGE DECK
+2500 - SALOON DECK
+2345 - MAIN DECK
+370 - DØRK
0 - BASE

BRODEKK

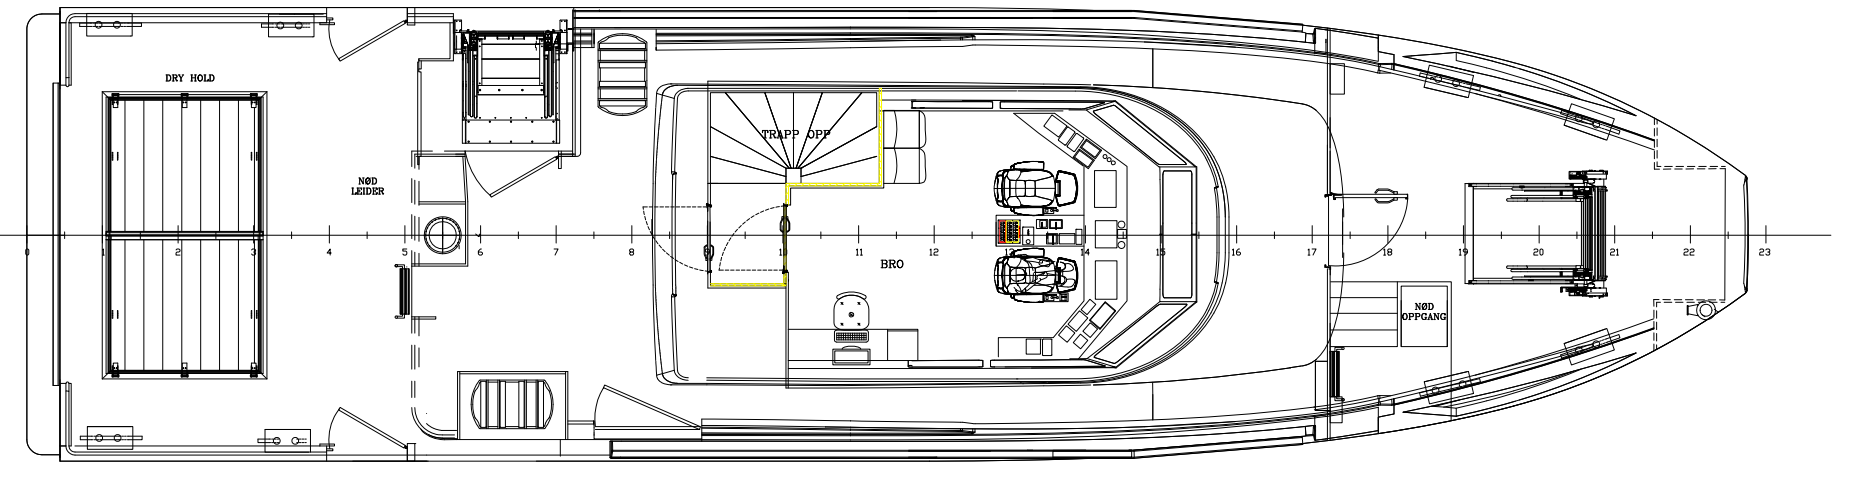

BRODEKK

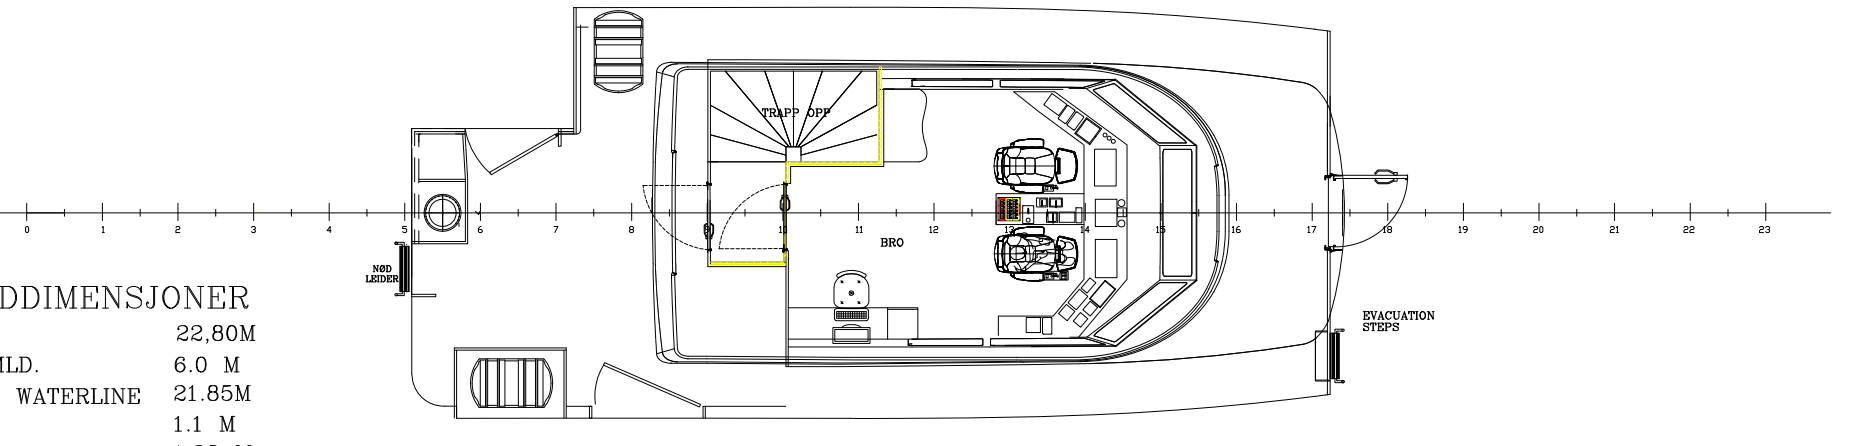

HOVEDDIMENSJONER
LOA 22,80M
BEAM MLD. 6.0 M
LENGTH WATERLINE 21.85M
KVL 1.1 M
FREEBORD 1,38 M
DEPTH MLD. 2.5 M
MAX DRAFT 1.10 M
FARTSOMRÅDE 4
SERVICE FART 18 KNOP
PASSANGER SEAT 48 STK

CLASS NOTATION +1A1 LC PASSENGER R3(NOR) E0

GROSS TON 91
FUEL CAPACITY 3000 L
FRESH WATER 400 L

Rev.	Area.	Dato:	Beskrivelse	Draw.	Godkj.	Kontr.
1		15.03.2016	General arrangement AS BUILD	G.Fle		
0		13.03.2015	General arrangement sendt til godkjenning - NMA	G.Fle		13.03.2015

This drawing and the design is our property and shall not be disclosed to third part of any type without permission.

Dato 10.01.2016	Konstr./Tegnet G.F	Tracet	Målestakk A3-1:100
Kontroll	Stand.kontroll G.S	Godkjent	

GS MARINE PRODUKSJON AS
HAUGSBYGDA
6082 GURSKEN

Erstatning for: Erstatt av:
GS39-100-001-T1

GENERAL ARRANGEMENT
EXTERNAL

Hvervisning:
CALL SIGN: 3YZS

Referanse:
EXPLORER 2300

H G F E D C B A