
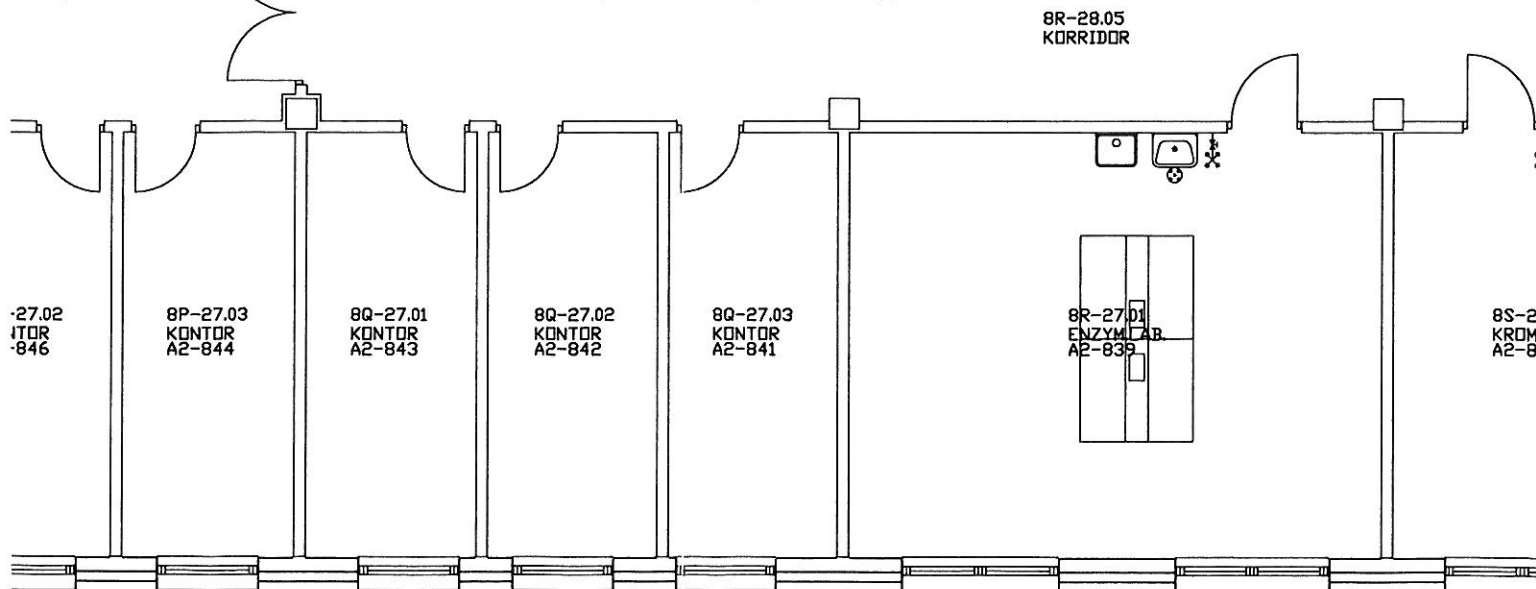
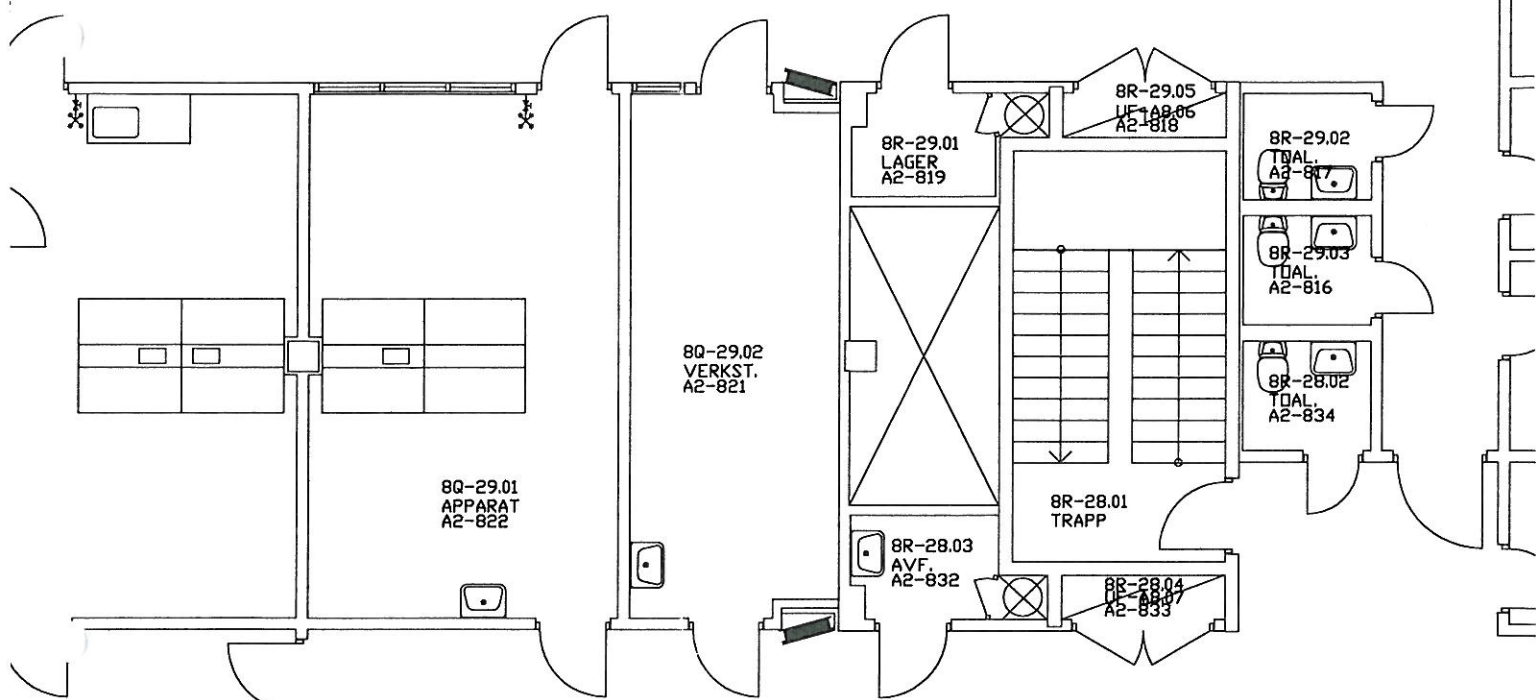


Anal TRONSØ ca 10,6m

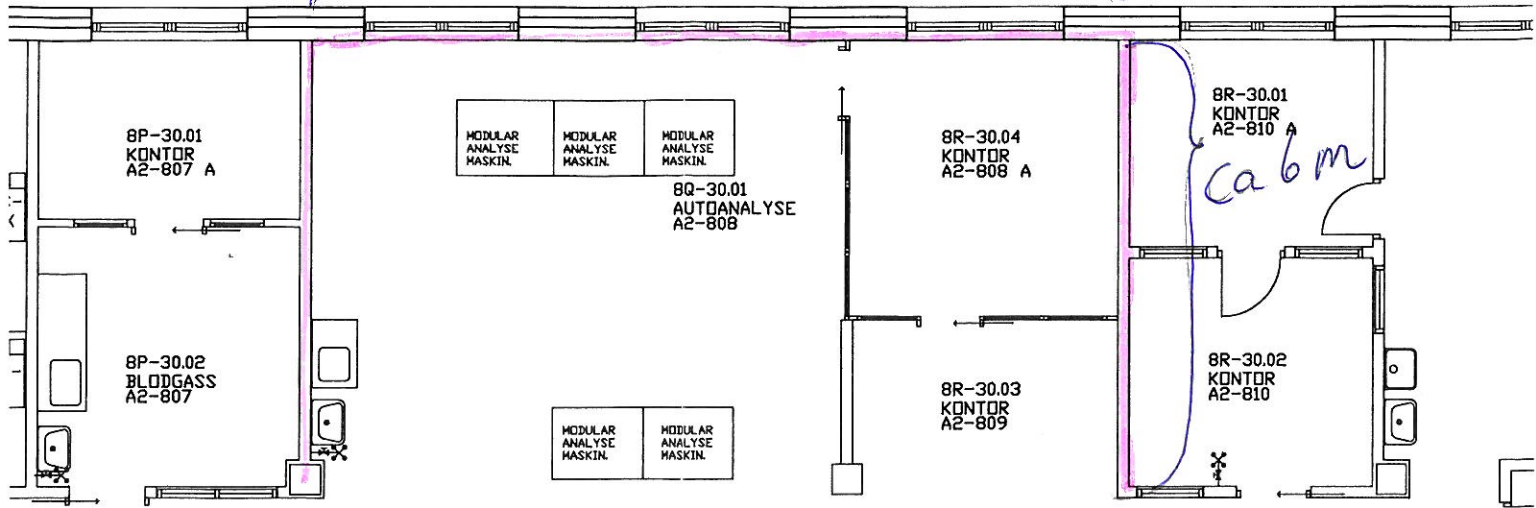

1cm = 1m