
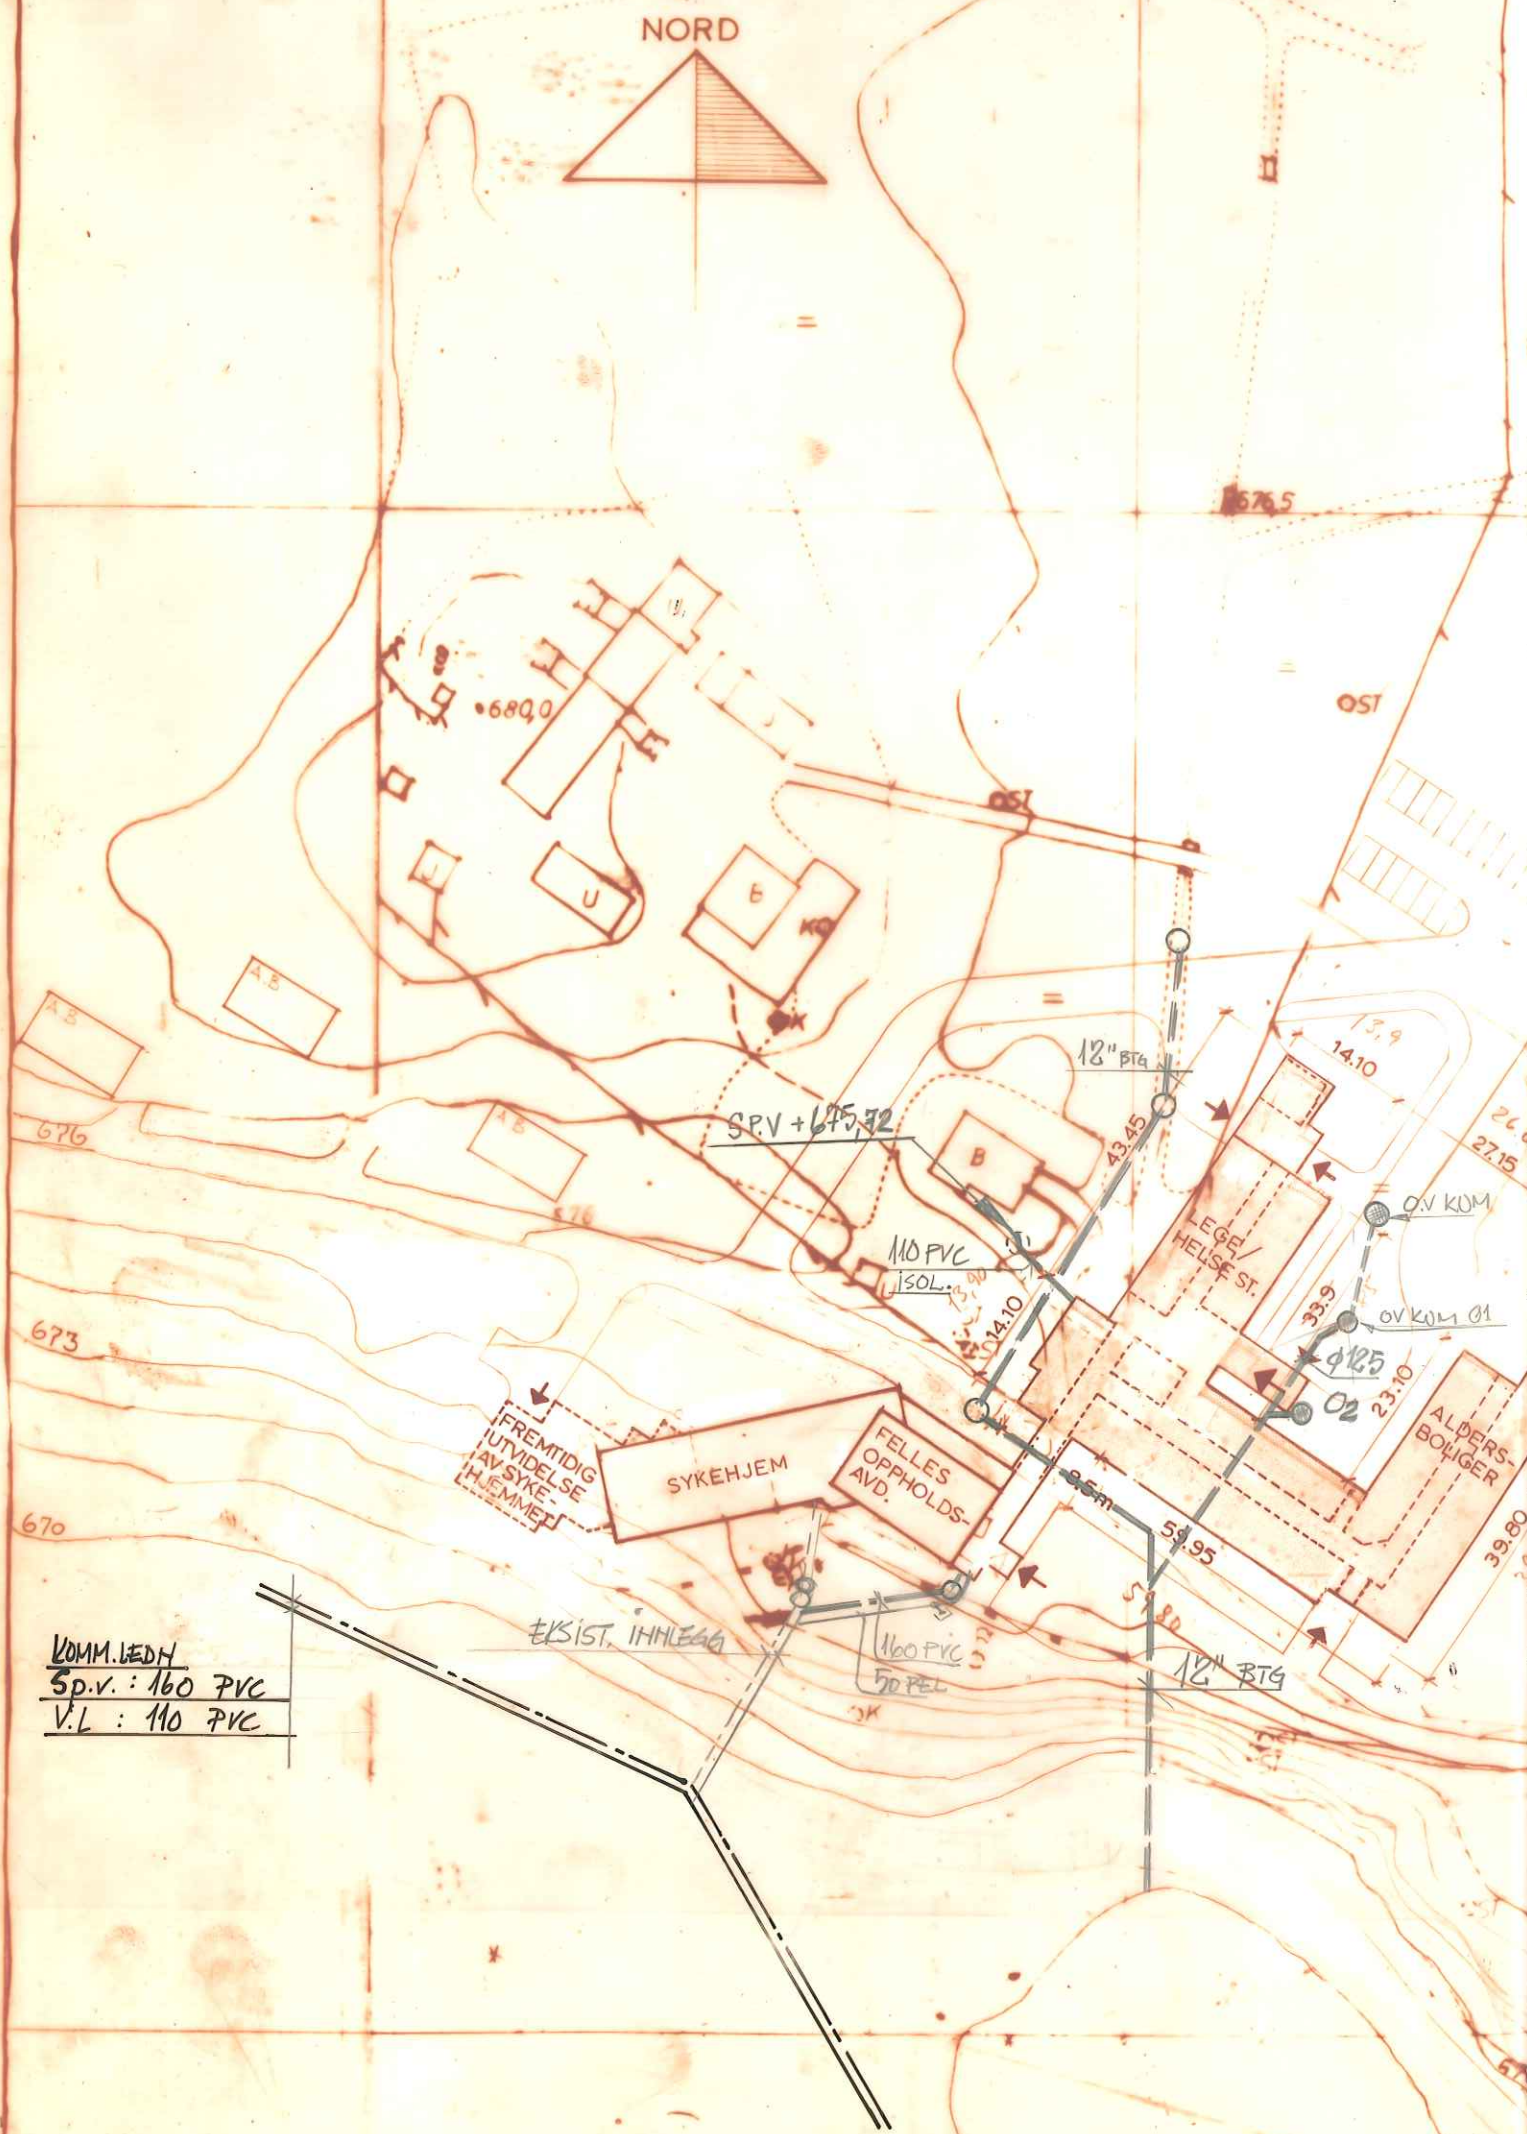


NORD

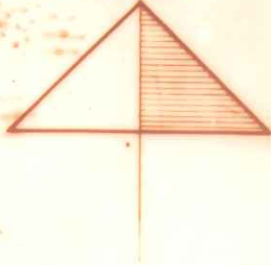

KOMM. LEDN
Sp.v. : 160 PVC
V.L. : 110 PVC

EKSIST. INNHLEGG

160 PVC
50 PEL

SP.V + 675,72

160 PVC
ISOL.

12" BTG

12" BTG

OV KOM
OV KOM 01

ALDERS-
BOLIGER

LEGE-
HELSE ST.

SYKEHJEM

FELLES
OPPHOLDS-
AVD.

FREMtidig
UTVIDELSE
AV SYKE-
HEMMET

676,5

680,0

676

673

670

OST

OST

OV KOM

OV KOM 01

ALDERS-
BOLIGER

13,9

14,10

26,6

27,15

33,9

41,25

23,10

39,80


12" BTG

43,45

85m

59,95

59,80

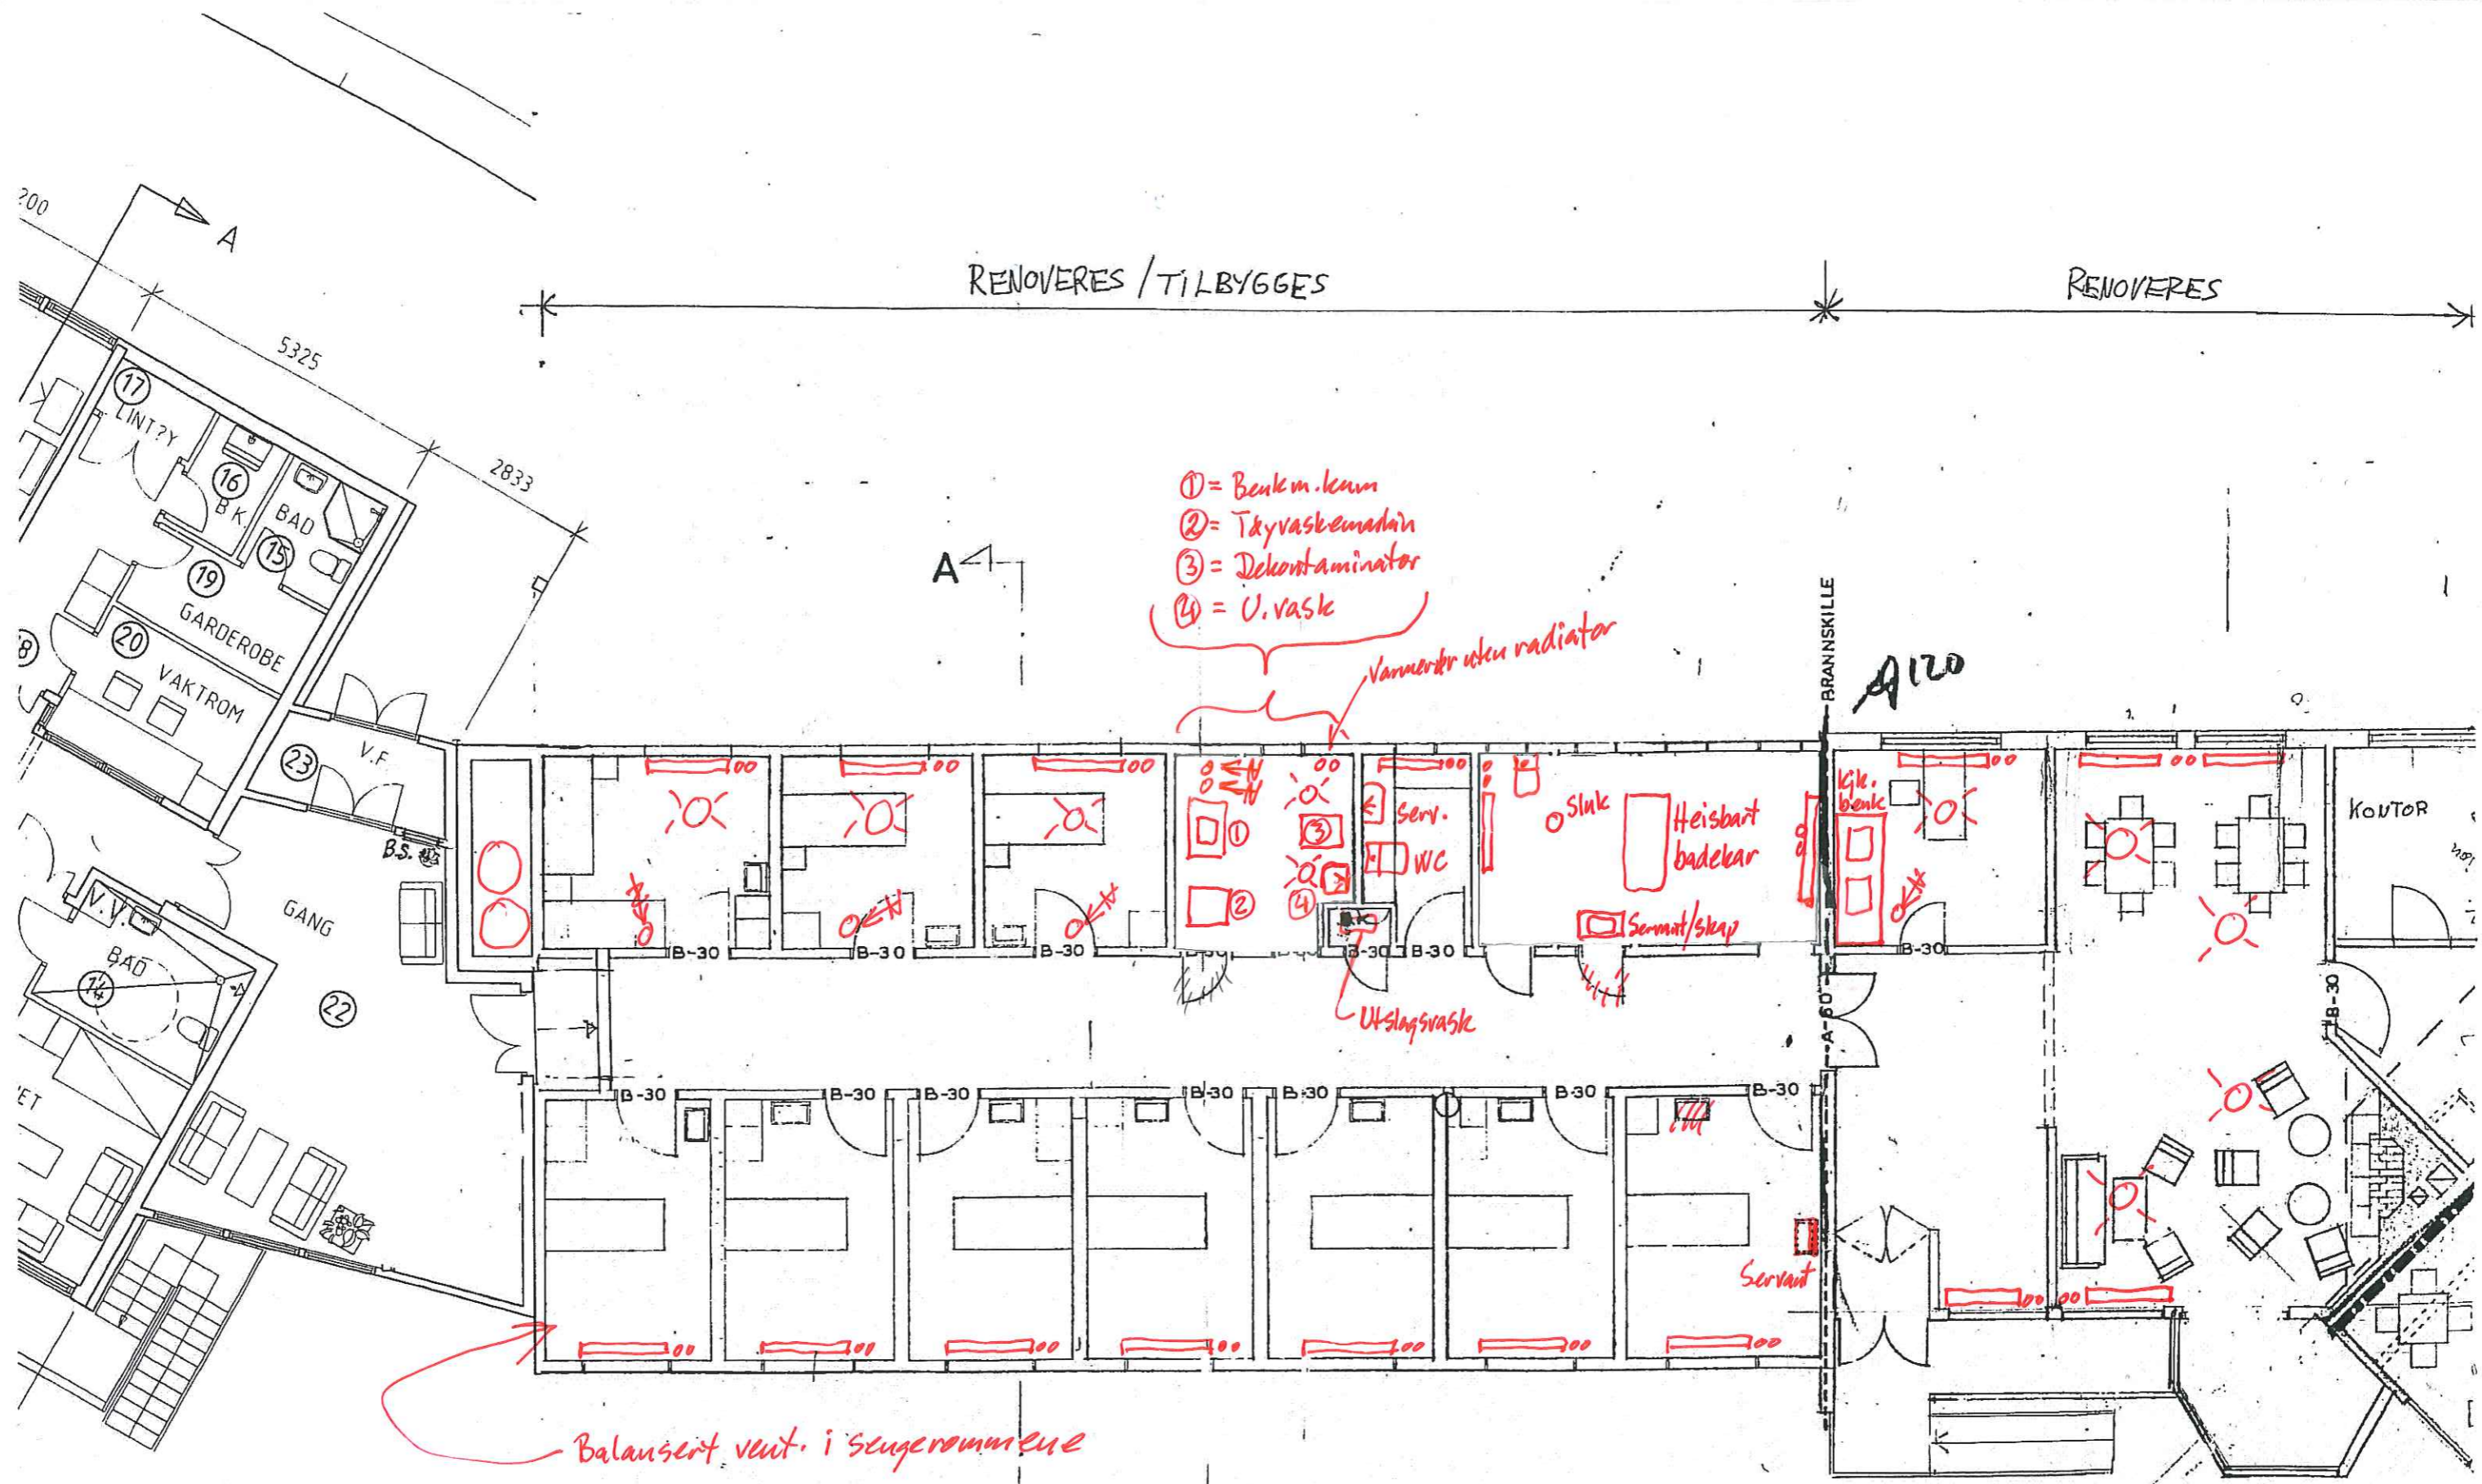

DREVSJØ SYKEHJEM	1:100
PASIENTROM M/FELLESROM	18.08.11
PLAN 1. ETG	
Skissemessig oversikt over dagens VVS	

