


FISKANE




FISKANE


PARKEERING

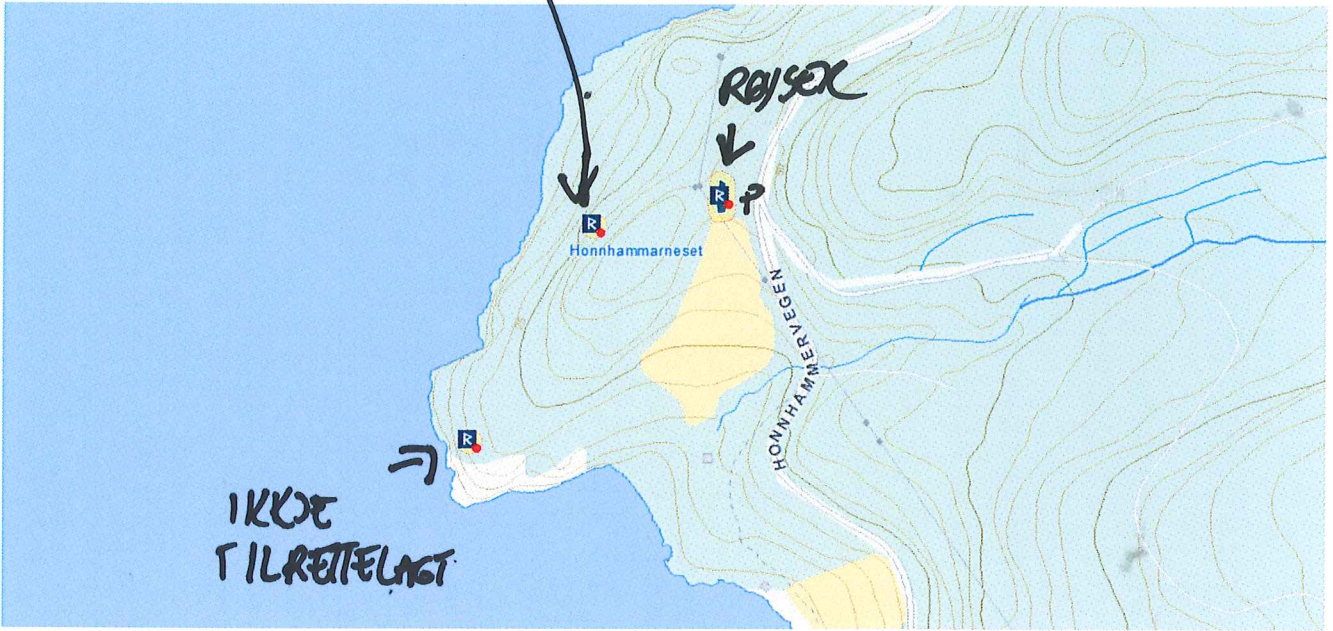

HONNHAMMARNESET

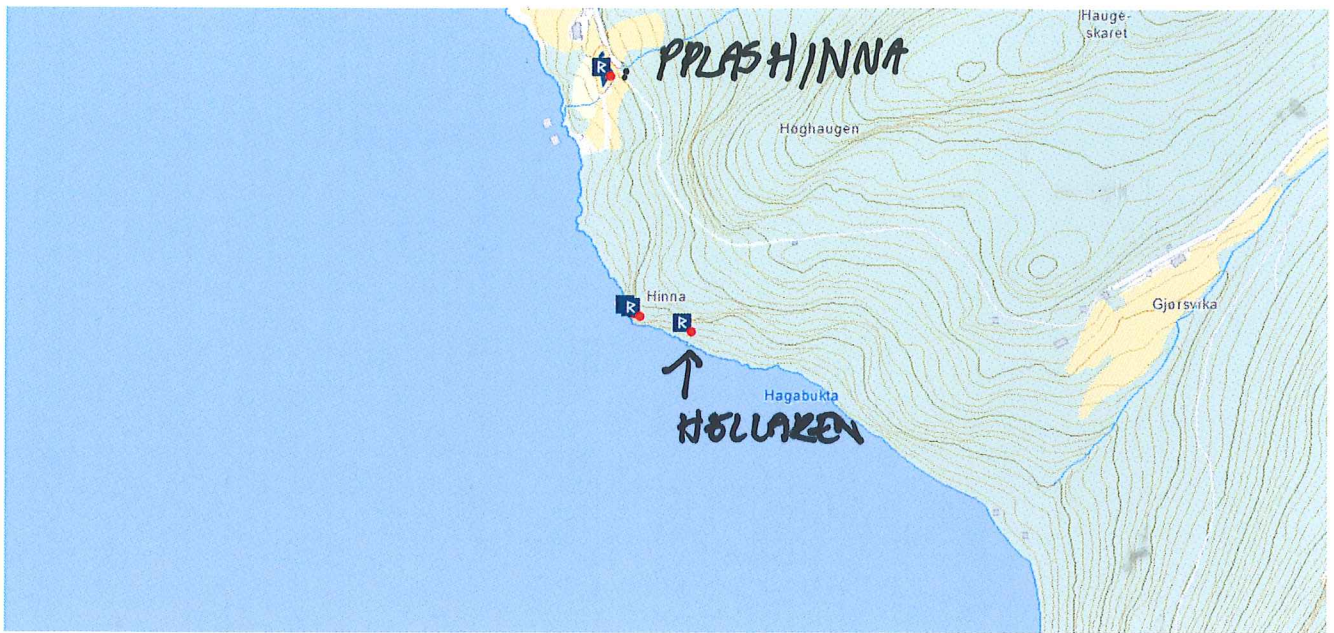


HINNA

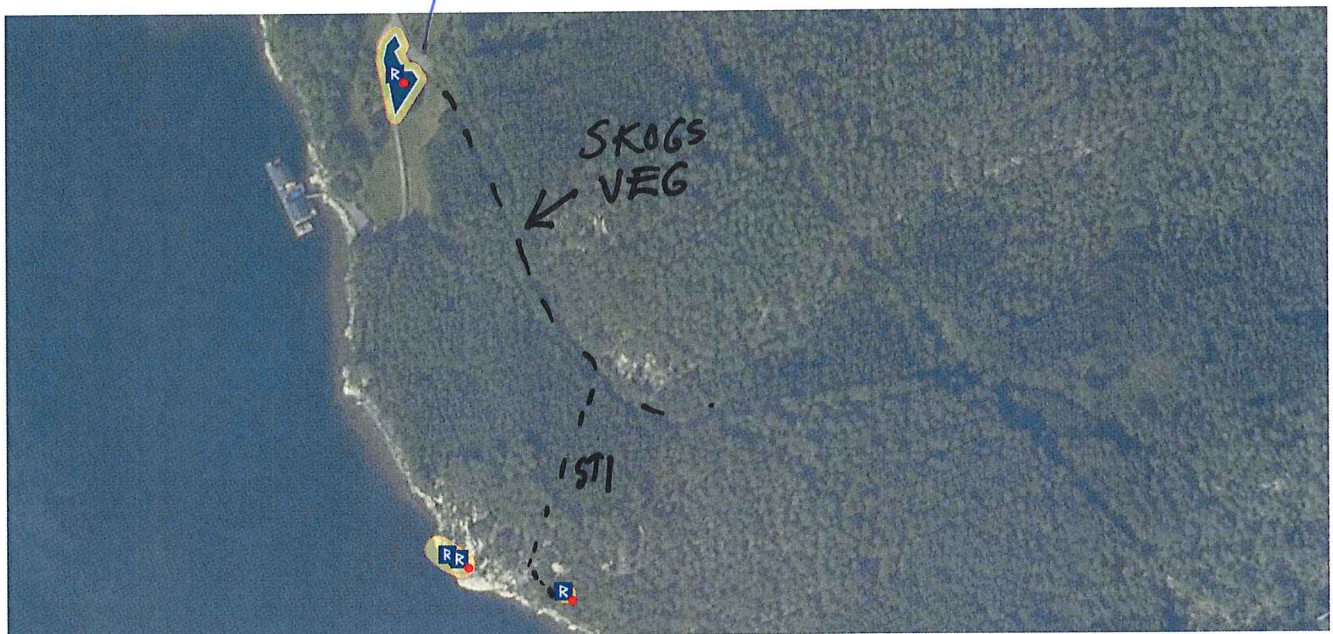

HINNA

HÖLLAREN

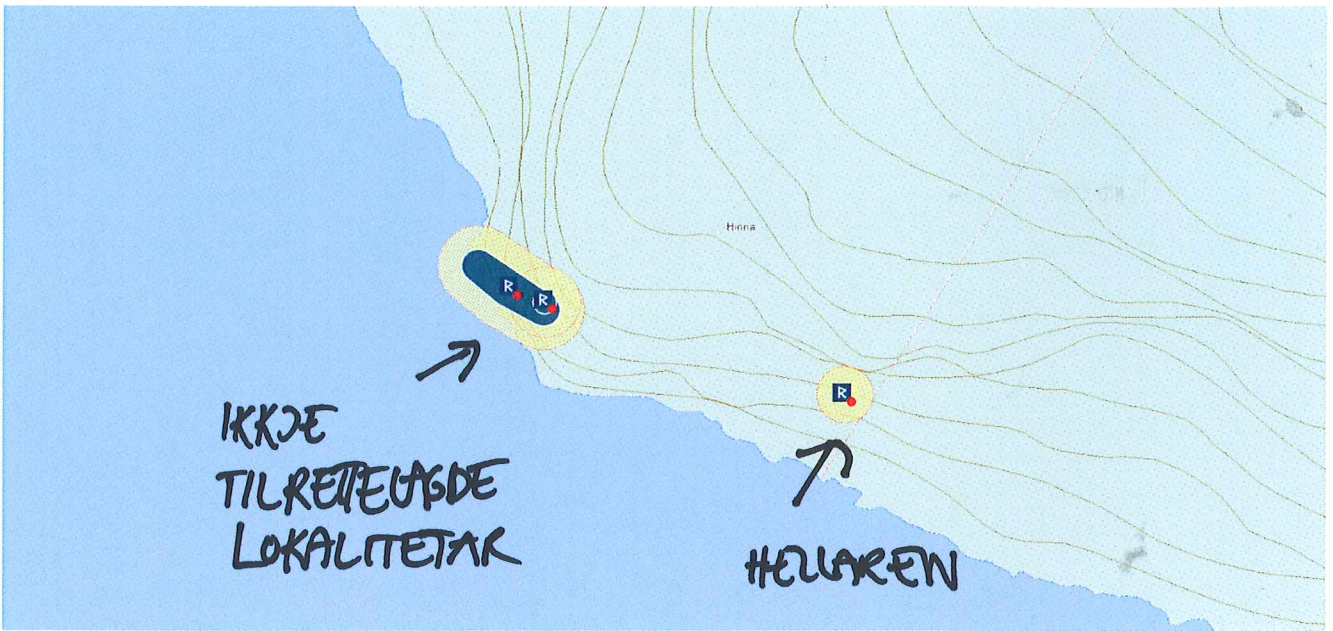

HINNA