


Fløy C, 2 etg

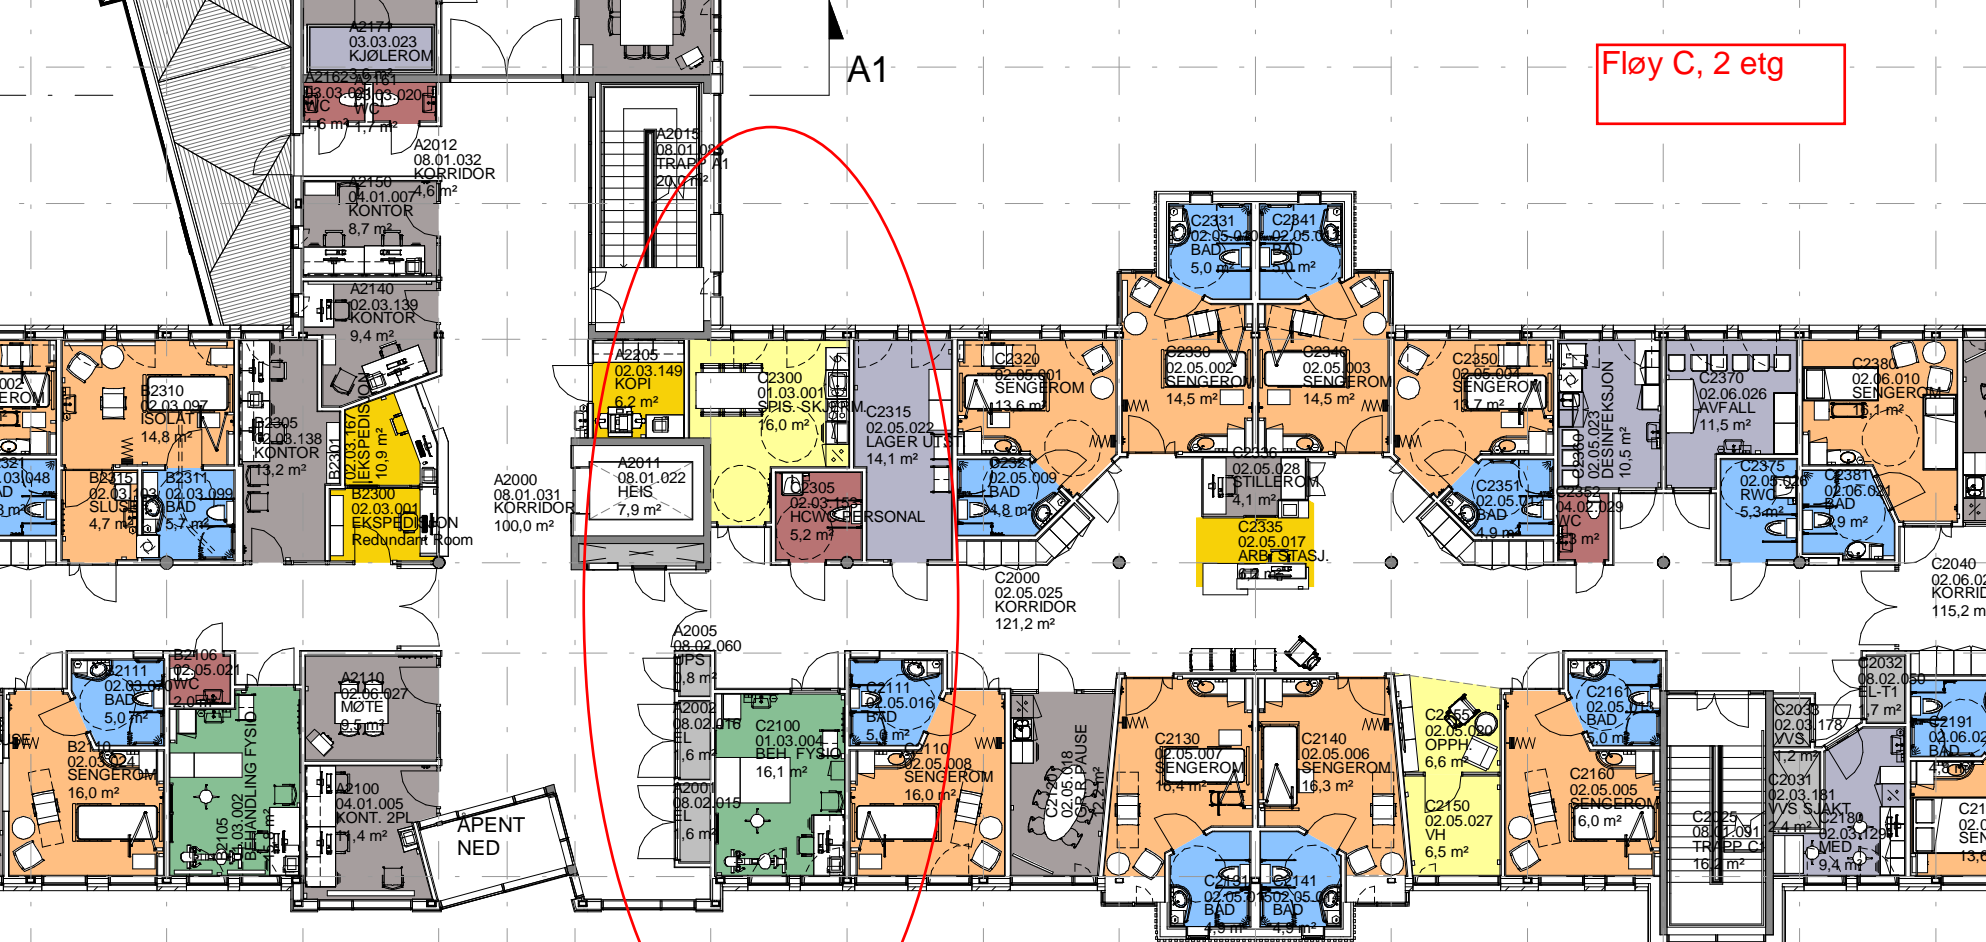

REHABILITERING 8 SENGER