


KONTORER ADMINISTRASJON - LOFT -  
3. etg.

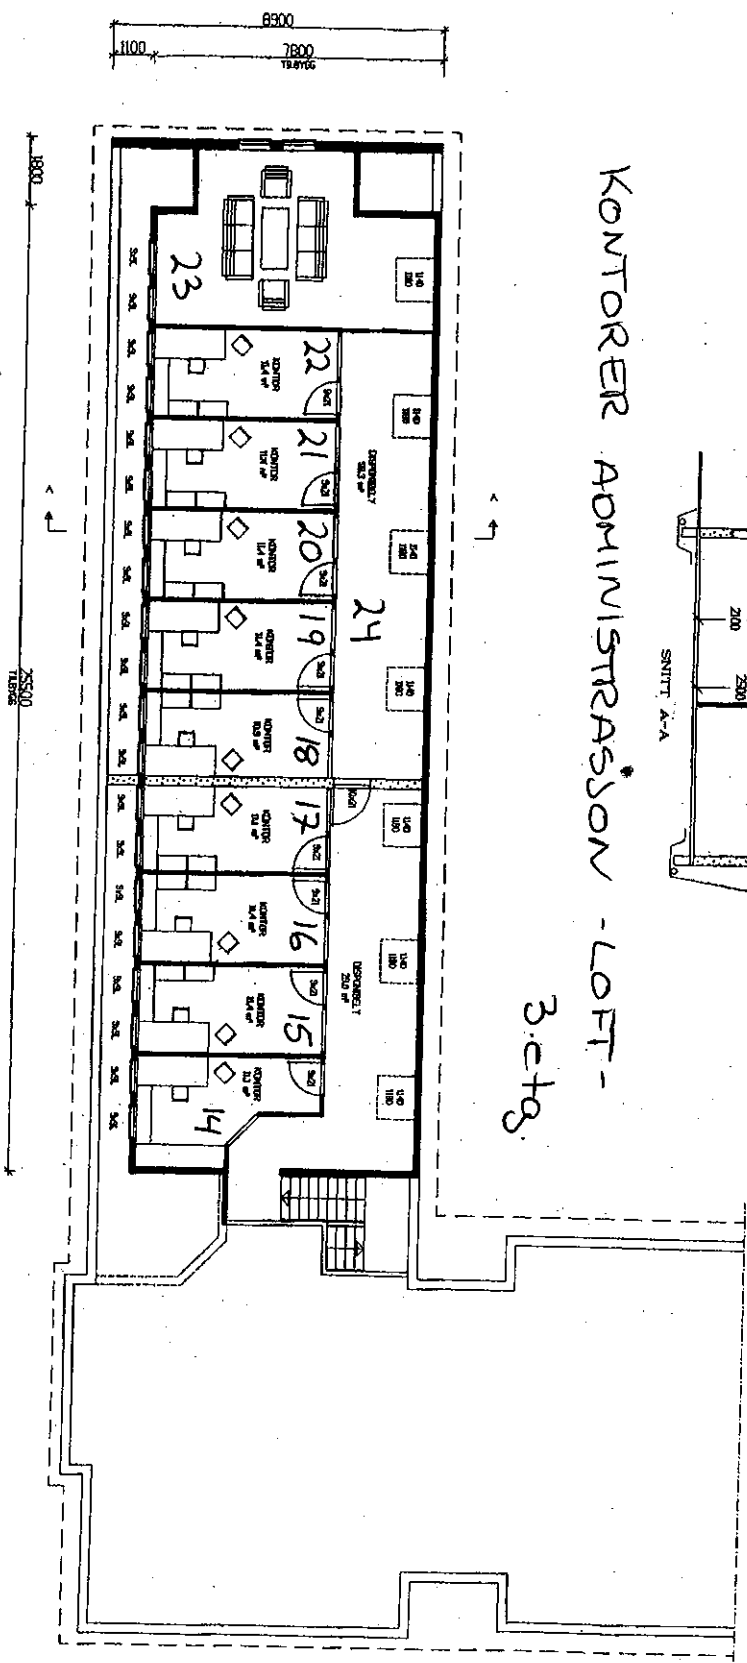


Woffelt 29/1


946 79 879.

REV.	REVISJON	NO.	DATE	BY
1	REVISJON	1		
TRÅNDØM: PLANTERØISK, SÆRHEIM FORSKINGSSENTER BRUKS: POSTVEIEN 213, 4082 KLEPP ST. REKVISIT: LOFTSPLAN / SVITT				
ANMÆR	KOMMENT	DRØTT NO.	DATE	BY
		G.81		
HEBYG	771 BYGG			5128




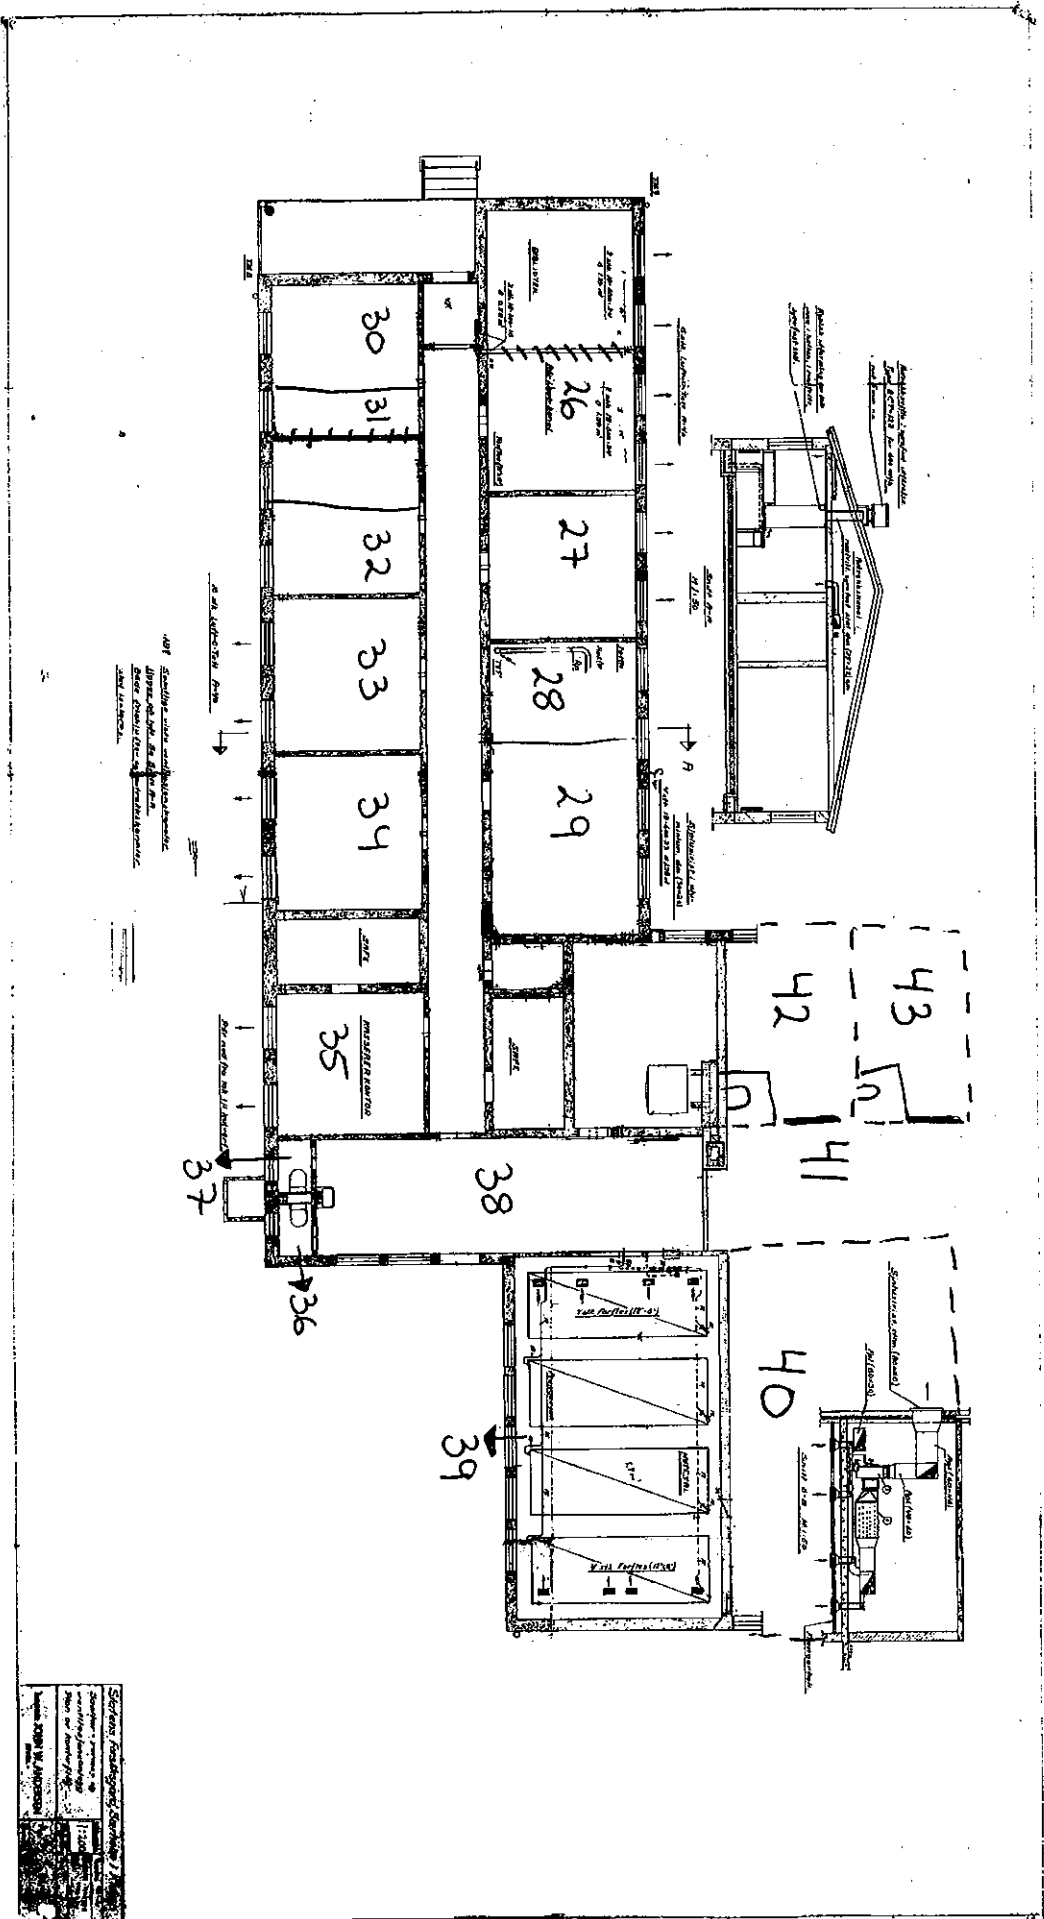




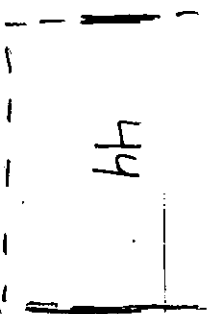

44

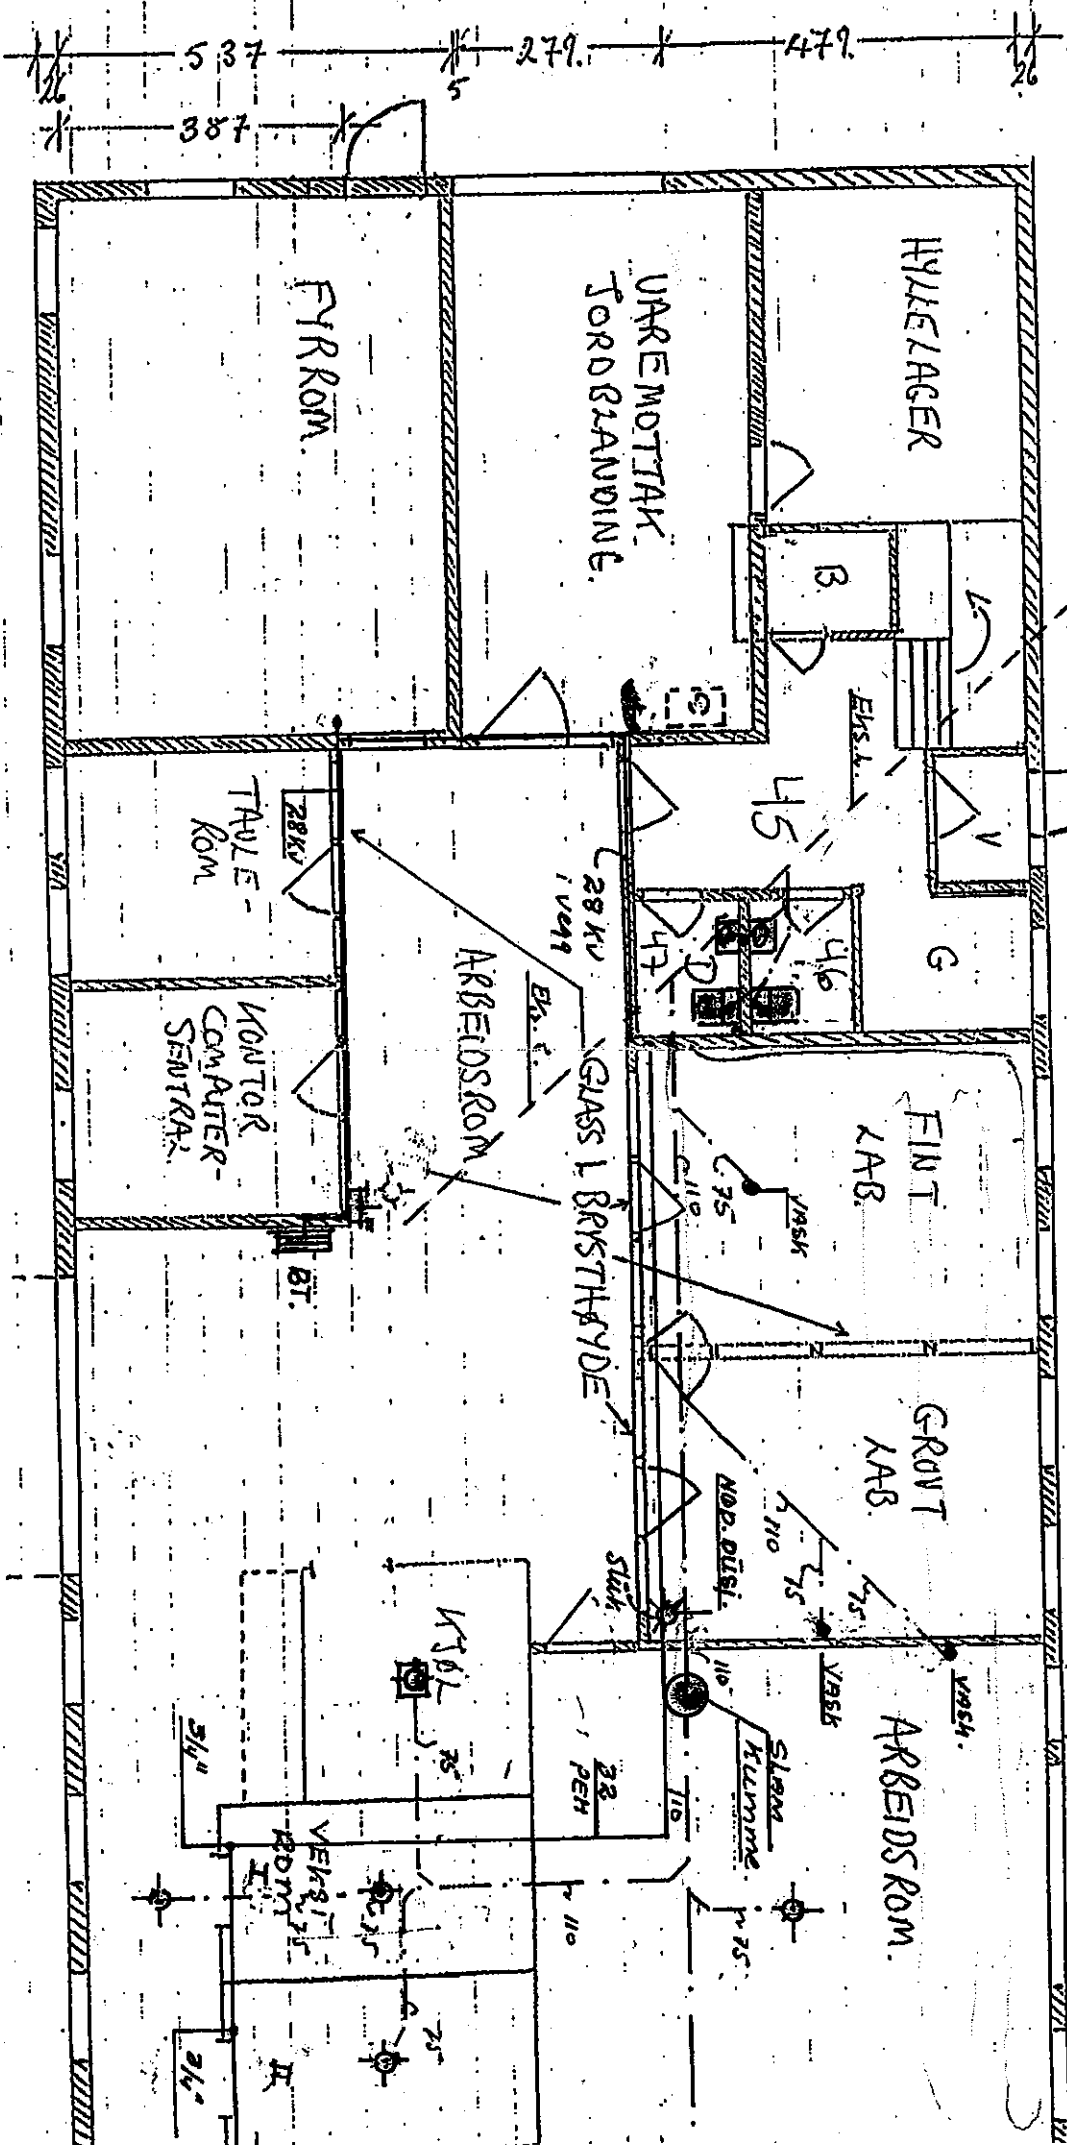

781  
 130  
 60  
 120  
 60  
 121  
 50  
 121  
 50  
 120  
 50  
 120  
 50  
 101  
 301  
 612  
 120

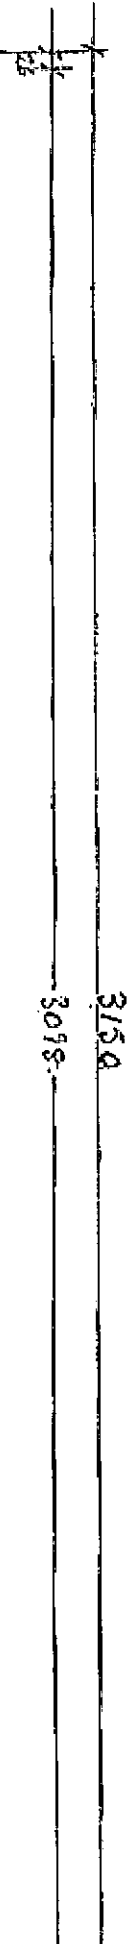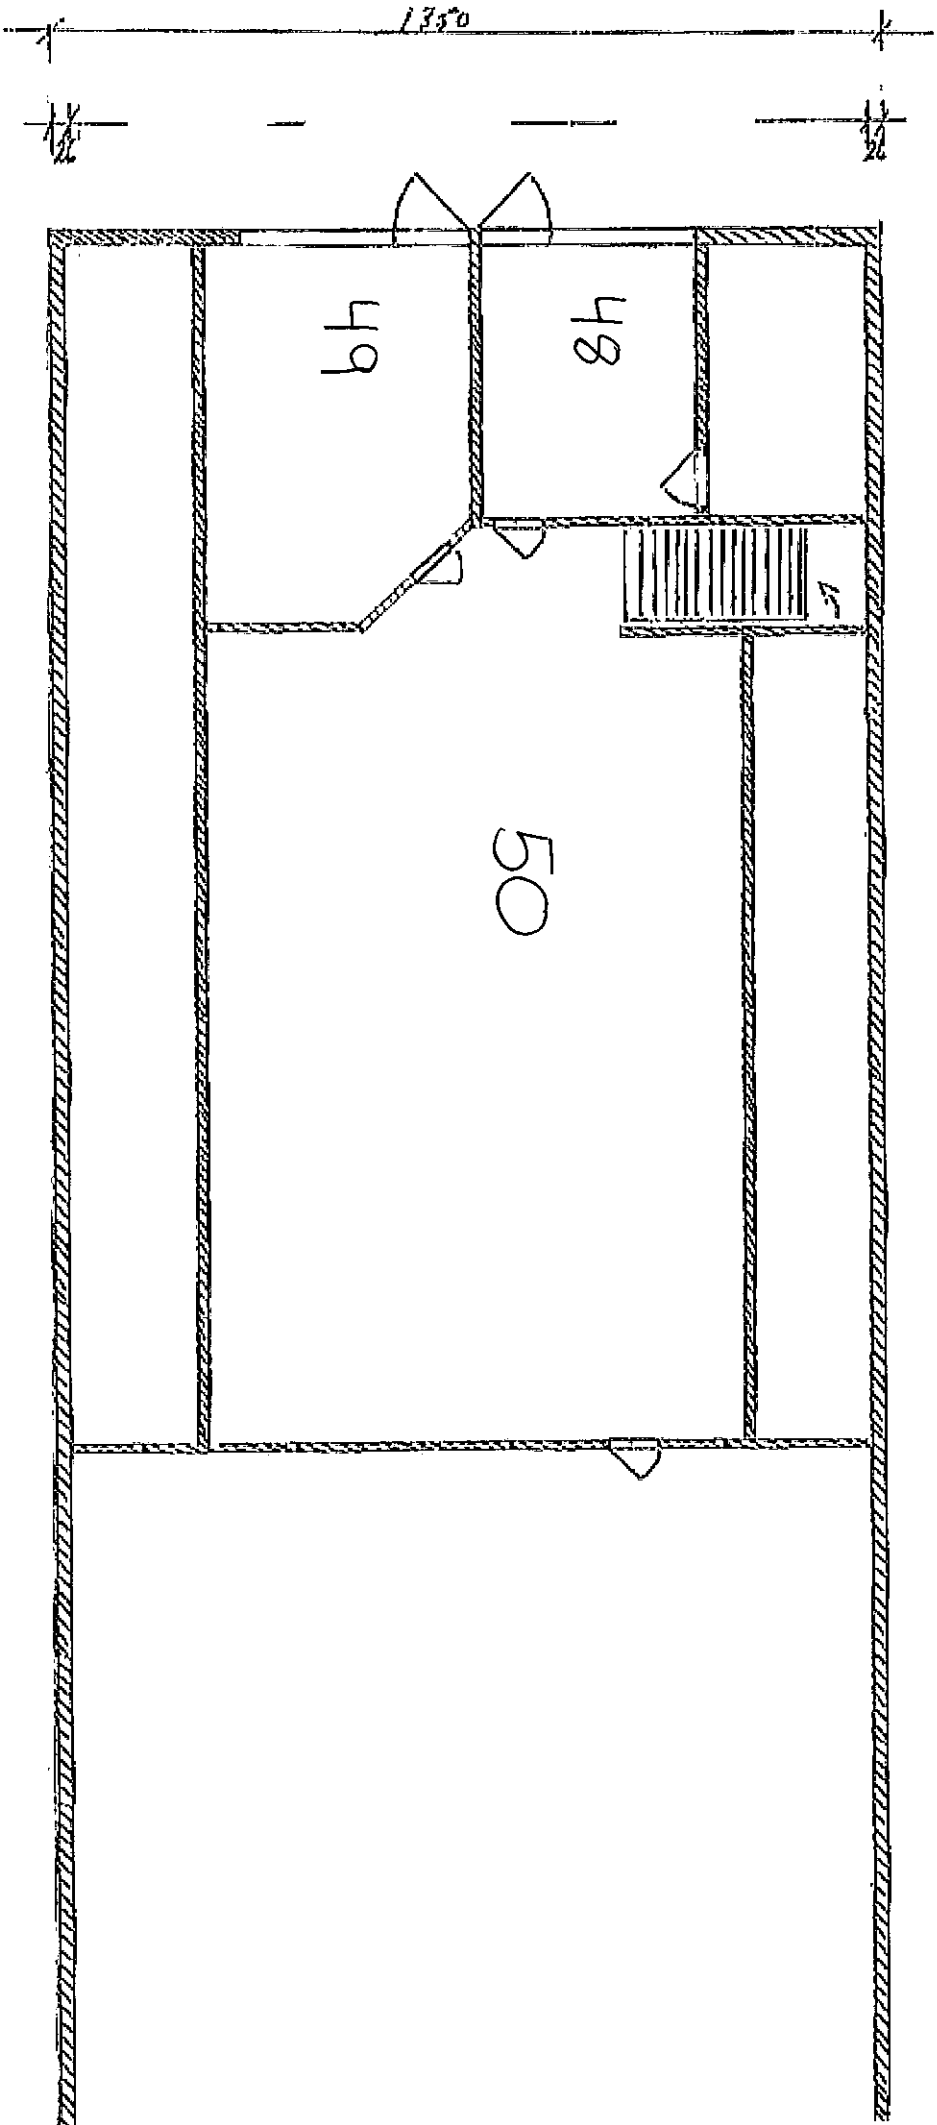

1 = 100

