


**AMFI Futura**  
 U. etasje - 7.211m<sup>2</sup>  
 Arealtegning (BTA)  
 26.08.16 - J.S.



*tilfukkning*

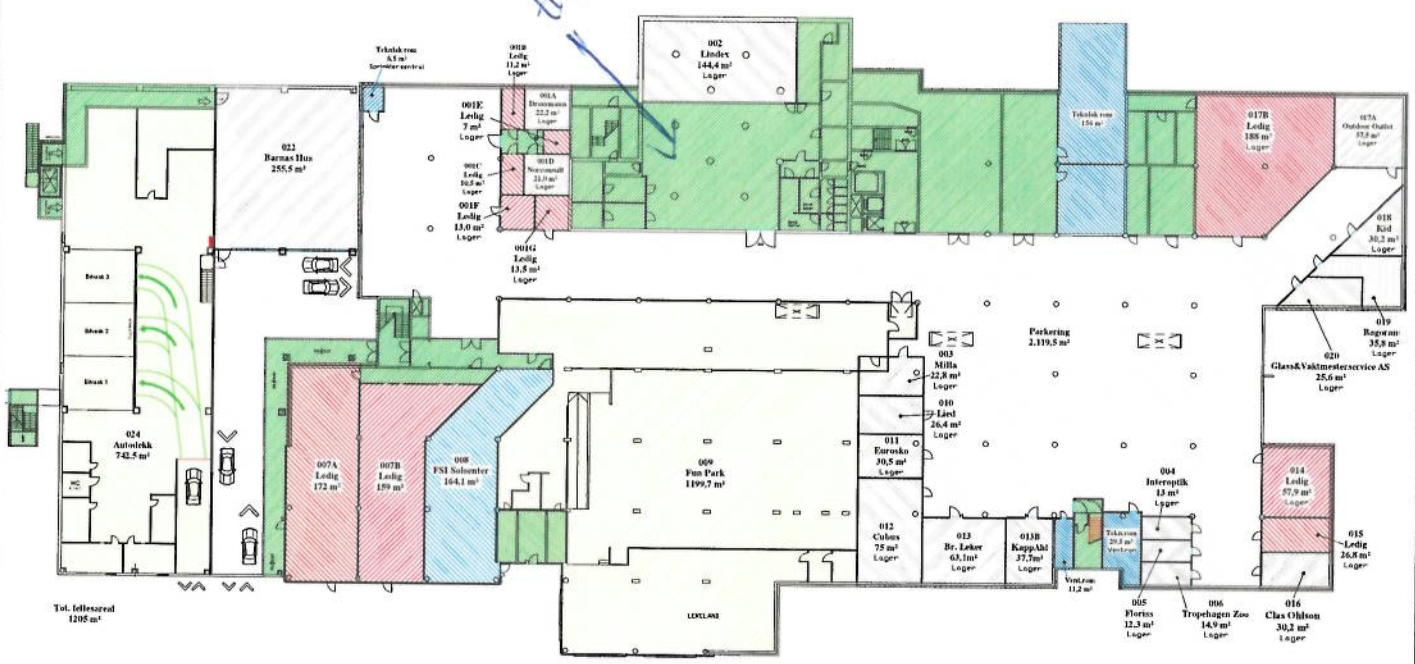


LEKLANE

Parkering  
2.119,5 m<sup>2</sup>