

X

57m


VERKS TEDBYGG
PROD OG SHE

X


28m

X

+88,6	4
+84,32	3
+80,5	2
+77,0	1
+54,2	01
+51,1	02

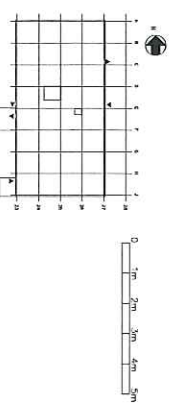

VED VAREL 16 STK
TRADLOS 3 SNE

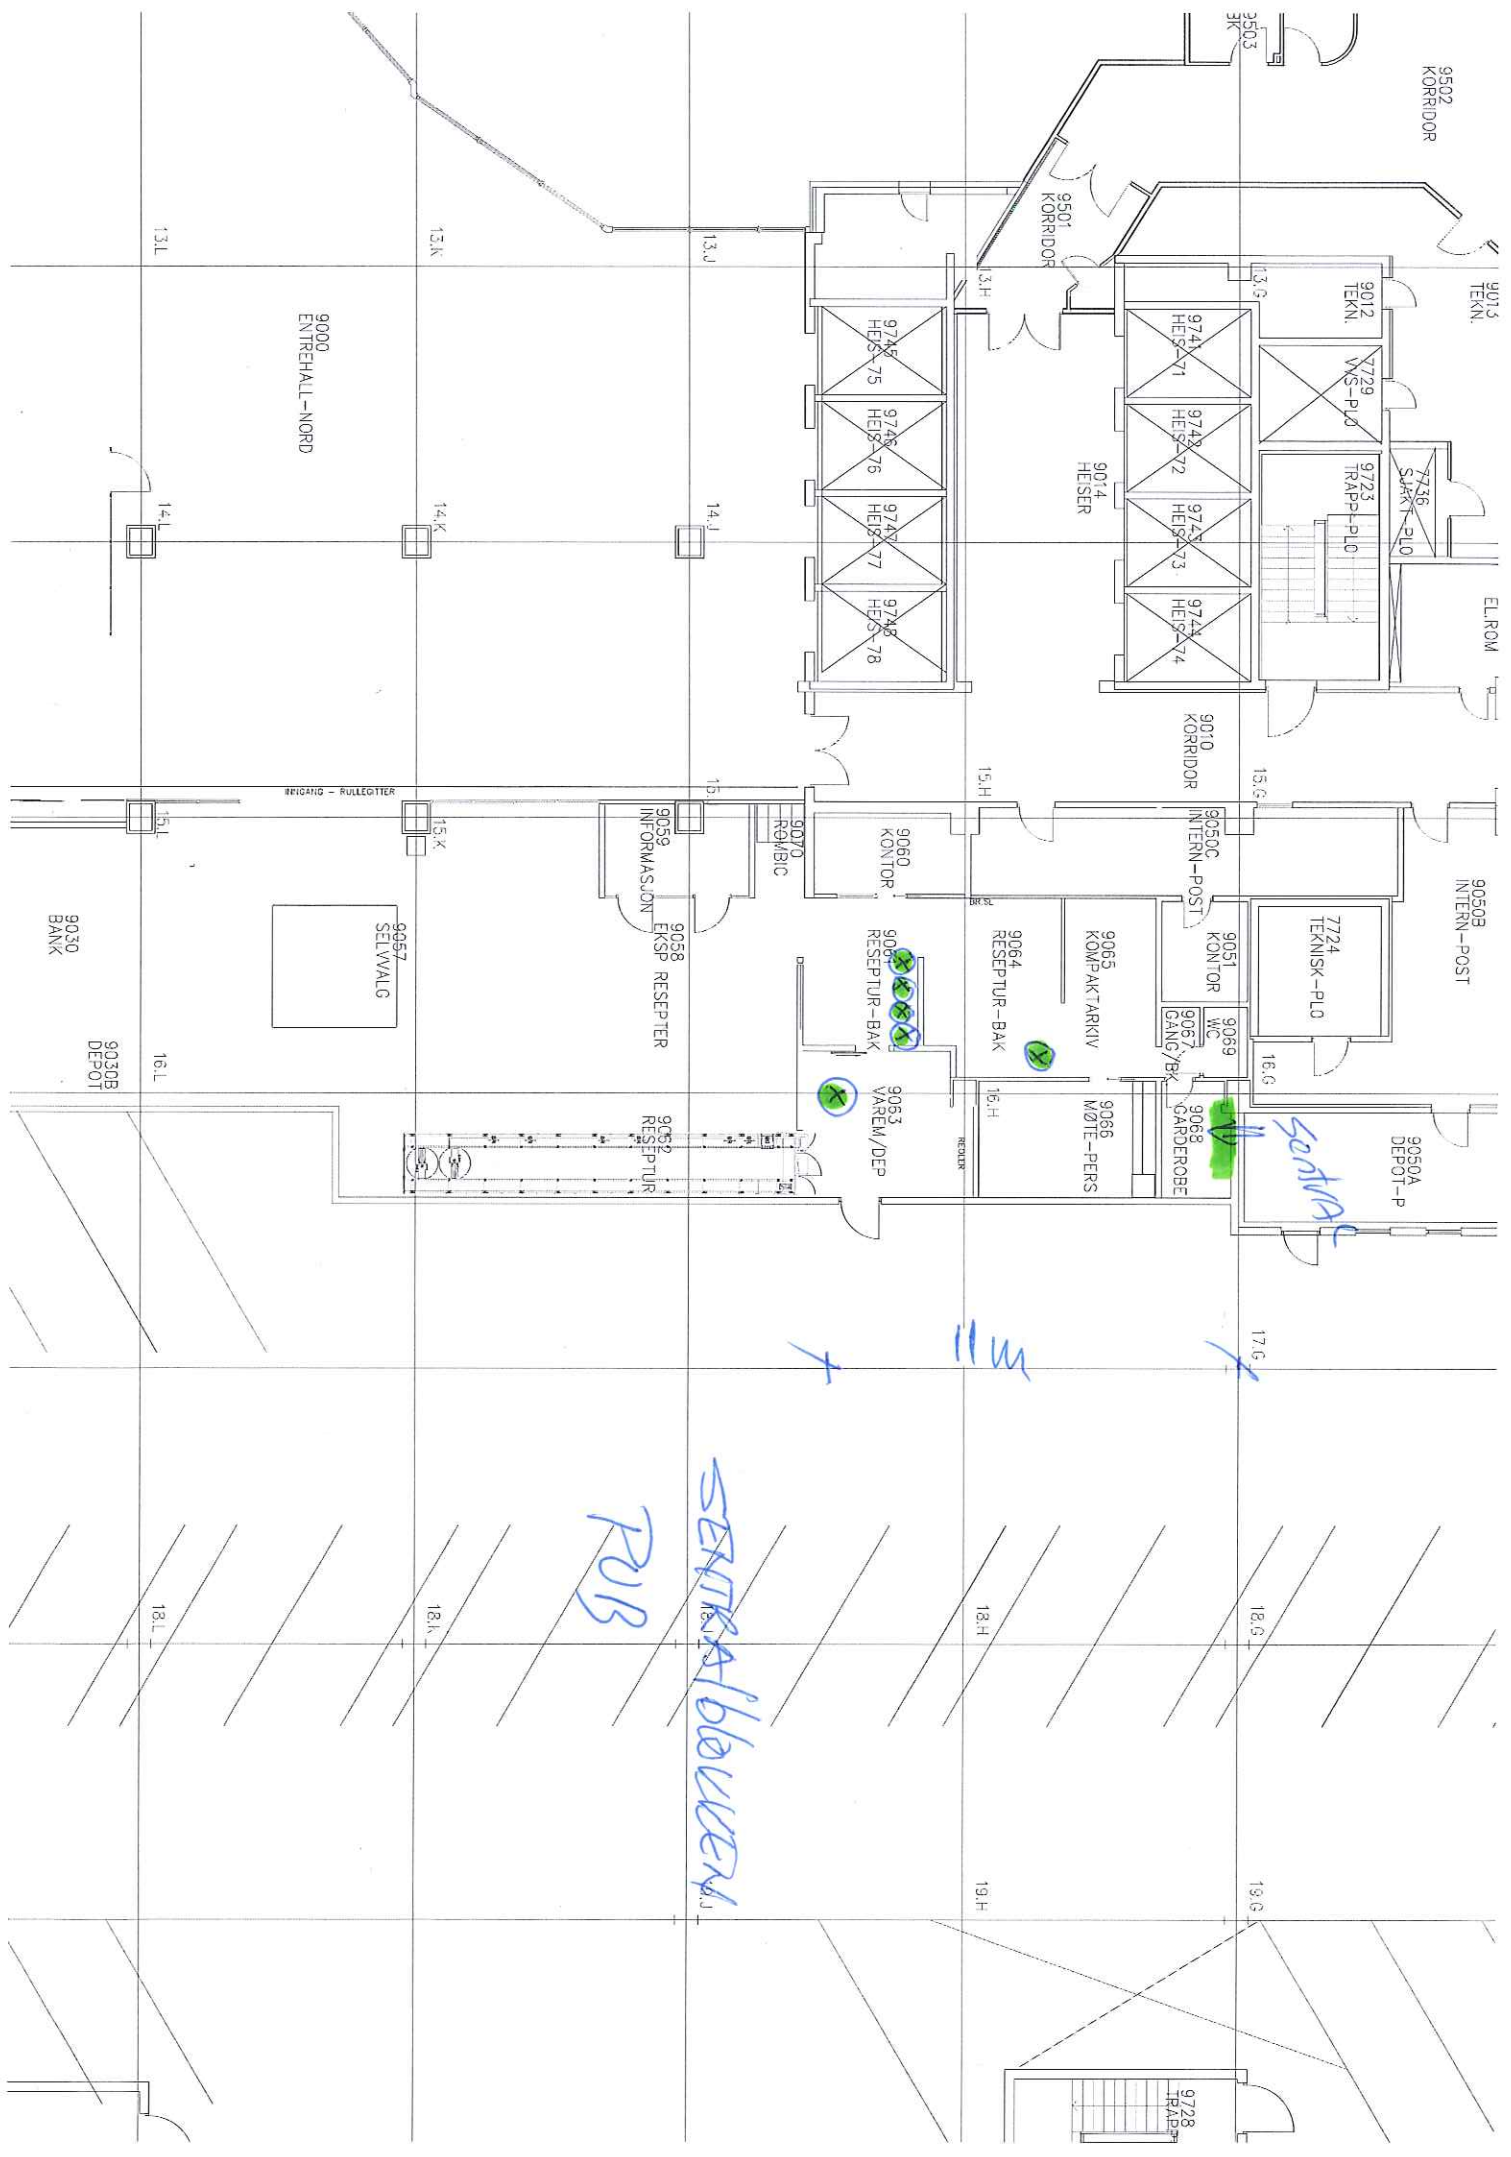

9502 KORRIDOR

9013 TEKN

EL.ROM

9050B INTERN-POST

9050A DEPOT-P

9012 TEKN

7729 VVS-PL0

9723 TRAPP-PL0

7724 TEKNISK-PL0

9068 GARDEROBE

17.G

18.G

19.G

9501 KORRIDOR

9745 HEIS-71

9742 HEIS-72

9743 HEIS-73

9744 HEIS-74

9014 HEISER

9050C INTERN-POST

9051 KONTOR

9059 WC

9067 GANG/BK

9065 KOMP-AKTARKIV

9066 WØTE-PERS

9060 KONTOR

9064 RESEPTUR-BAK

9063 VAREM/DEP

18.H

19.H

13.U

14.I

15

16.L

18.K

19.H

13.N

14.K

15.X

18.K

13.L

14.L

15.L

16.L

18.L

9000 ENTREHALL-NORD

9057 SELWALG

9030 BANK

9030B DEPOT

SENTRALBLIVER

PUB

SENTRAL

3503

7736

SAKK-210

15.H

16.H

17.G

18.H

19.H

9728

TRAPP



9070 RGH/BIC

9058 INFORMASJON

9058 RESEPTUR

9052 RESEPTUR

9728

TRAPP