





KOTE 714 67


TROMS OFF. LANDSGYMNAS	M = 1
AGGREGATROM FLOY A2	15.6
JAN HAUGE SIVILINGENØR N.M.	60 -

dempende himling  
f. hovedentreenen

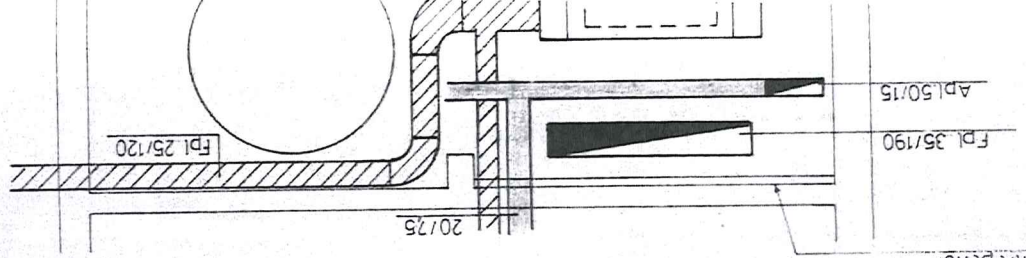


### Aggregatrom underetasje

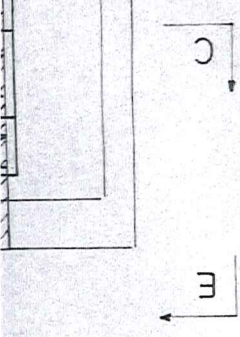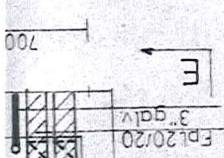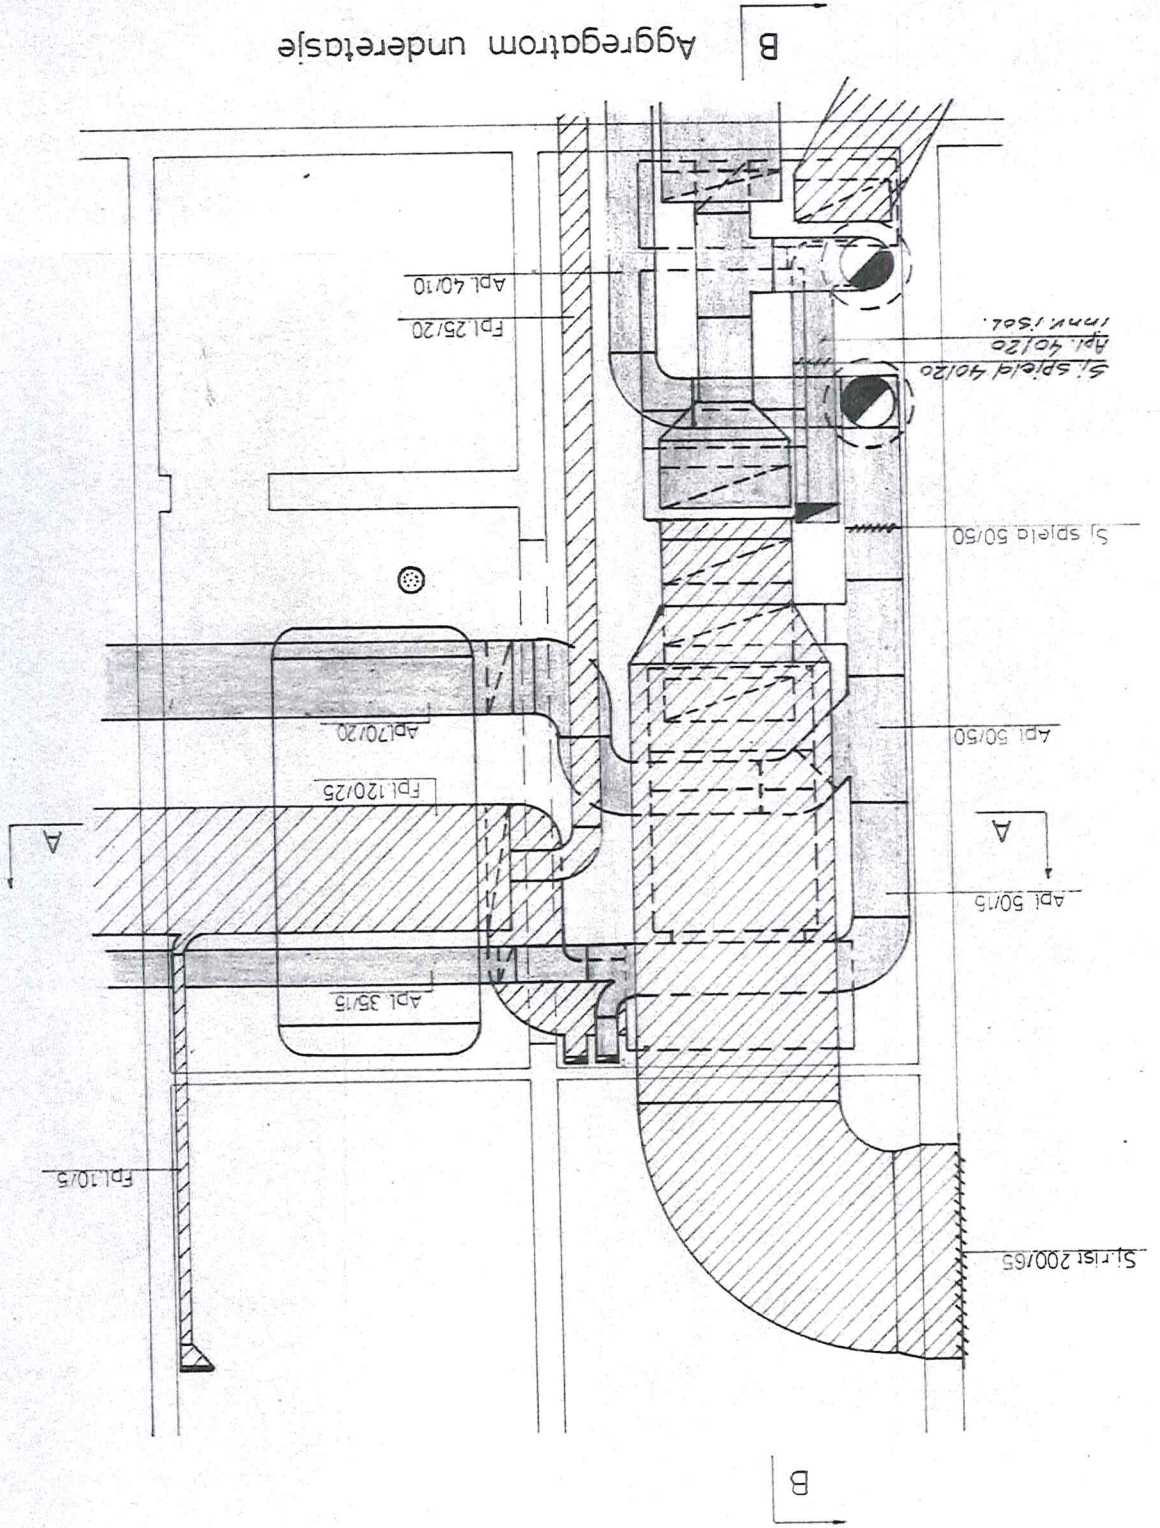

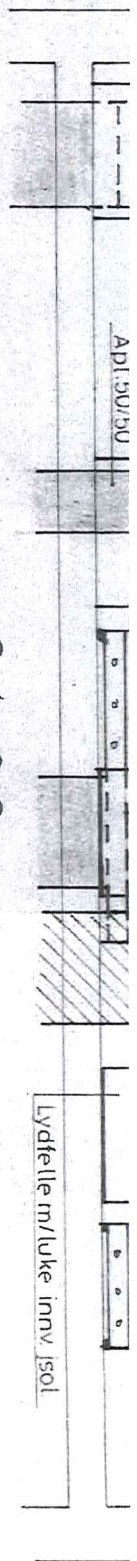

**Snitt G-G**

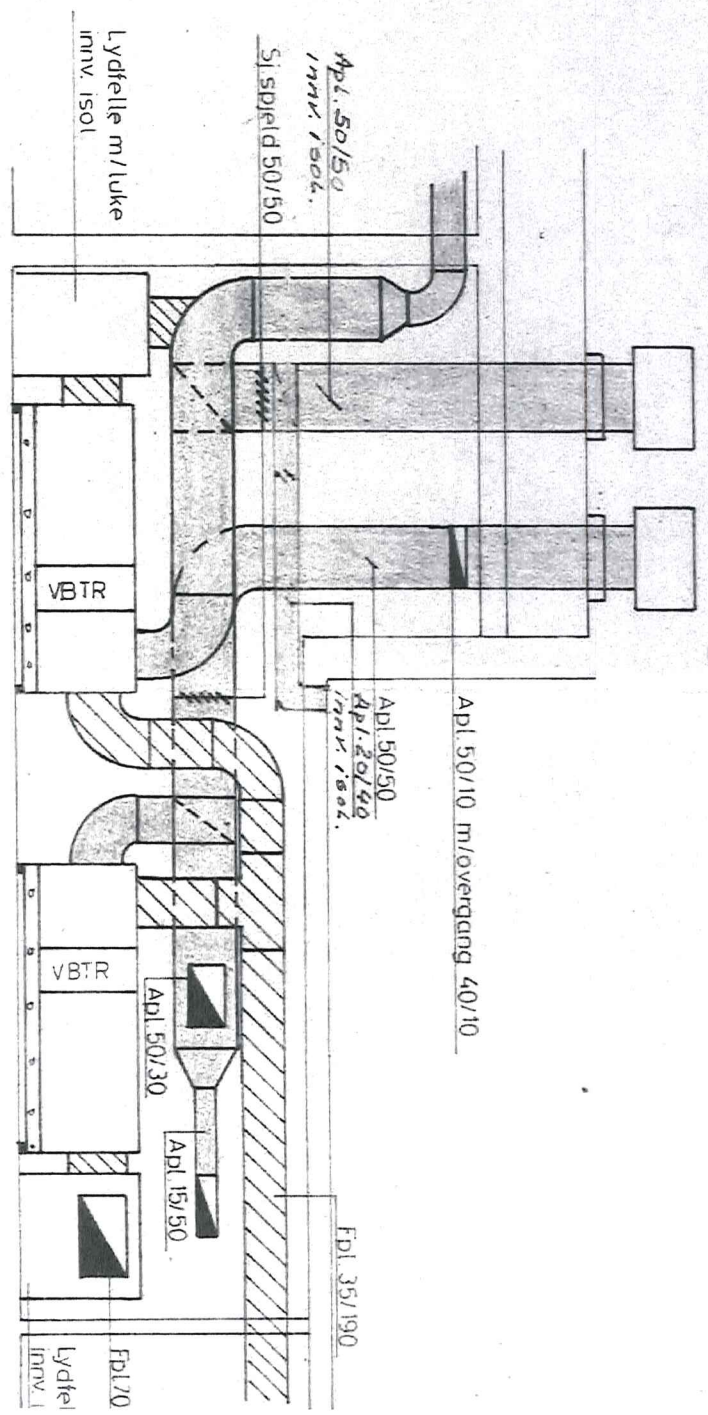

**Snitt B-B**

Kort: 714 67

TROMS OFF. LANDSGYM  
AGGREGATROM FLOY A.

JAM HAUGE  
SPESIALISERTE FASER



