



1000 200 1000  
139 179  
179

2011/11-11-05  
1244  
2011/11-11-05

# Slokningsmateriell

- P - pulverapparat
- Br - brannslange

Den originale tegninga er oppbevart på prestekontoret.

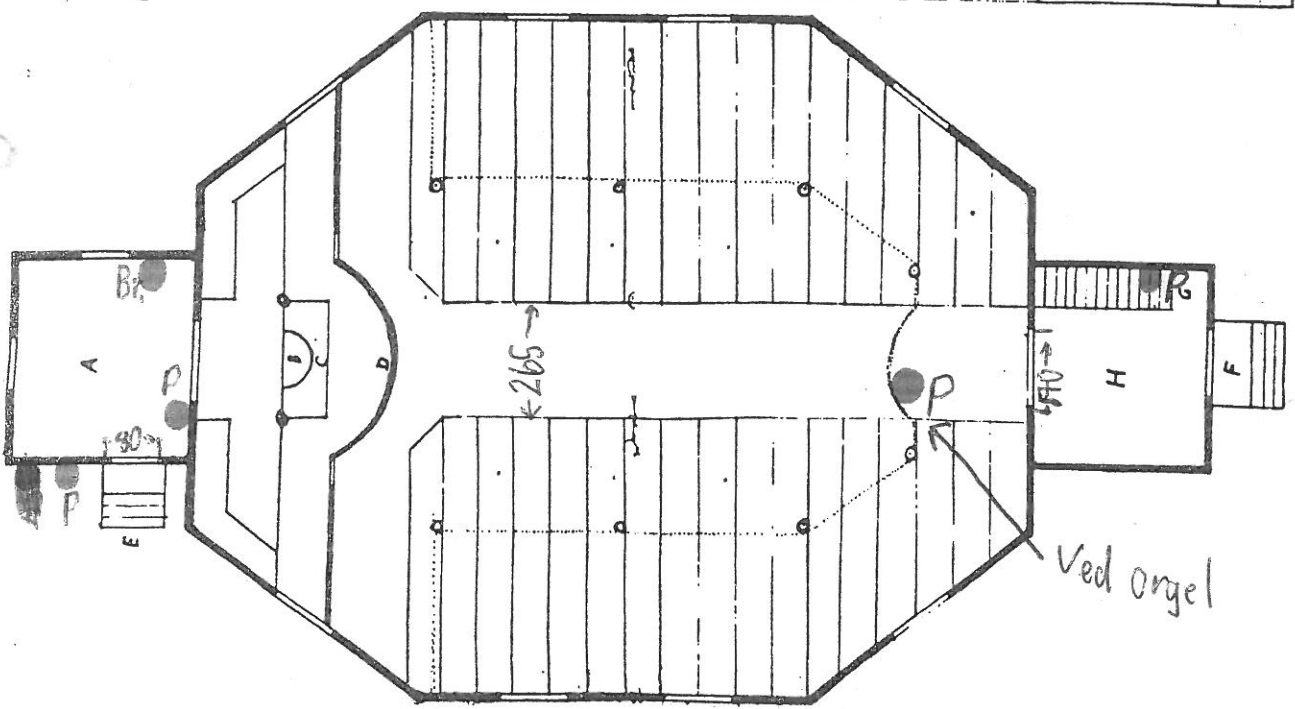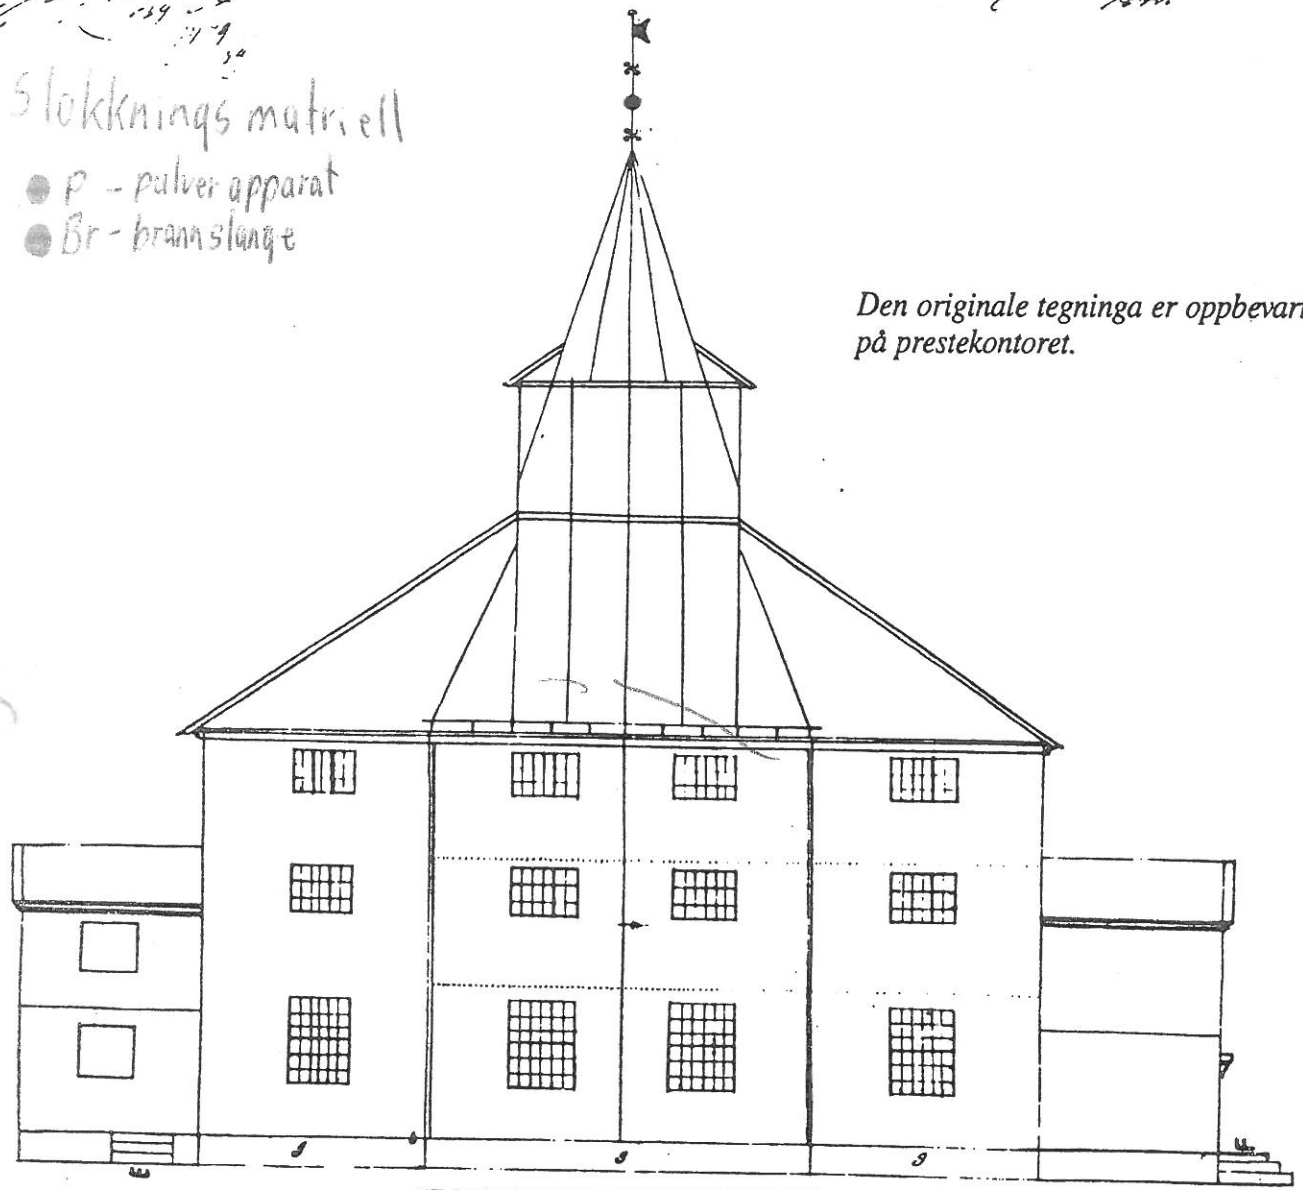

Antall sitteplasser 220 + galleri

Nov. 1999  
J.T.





195m

8,58m


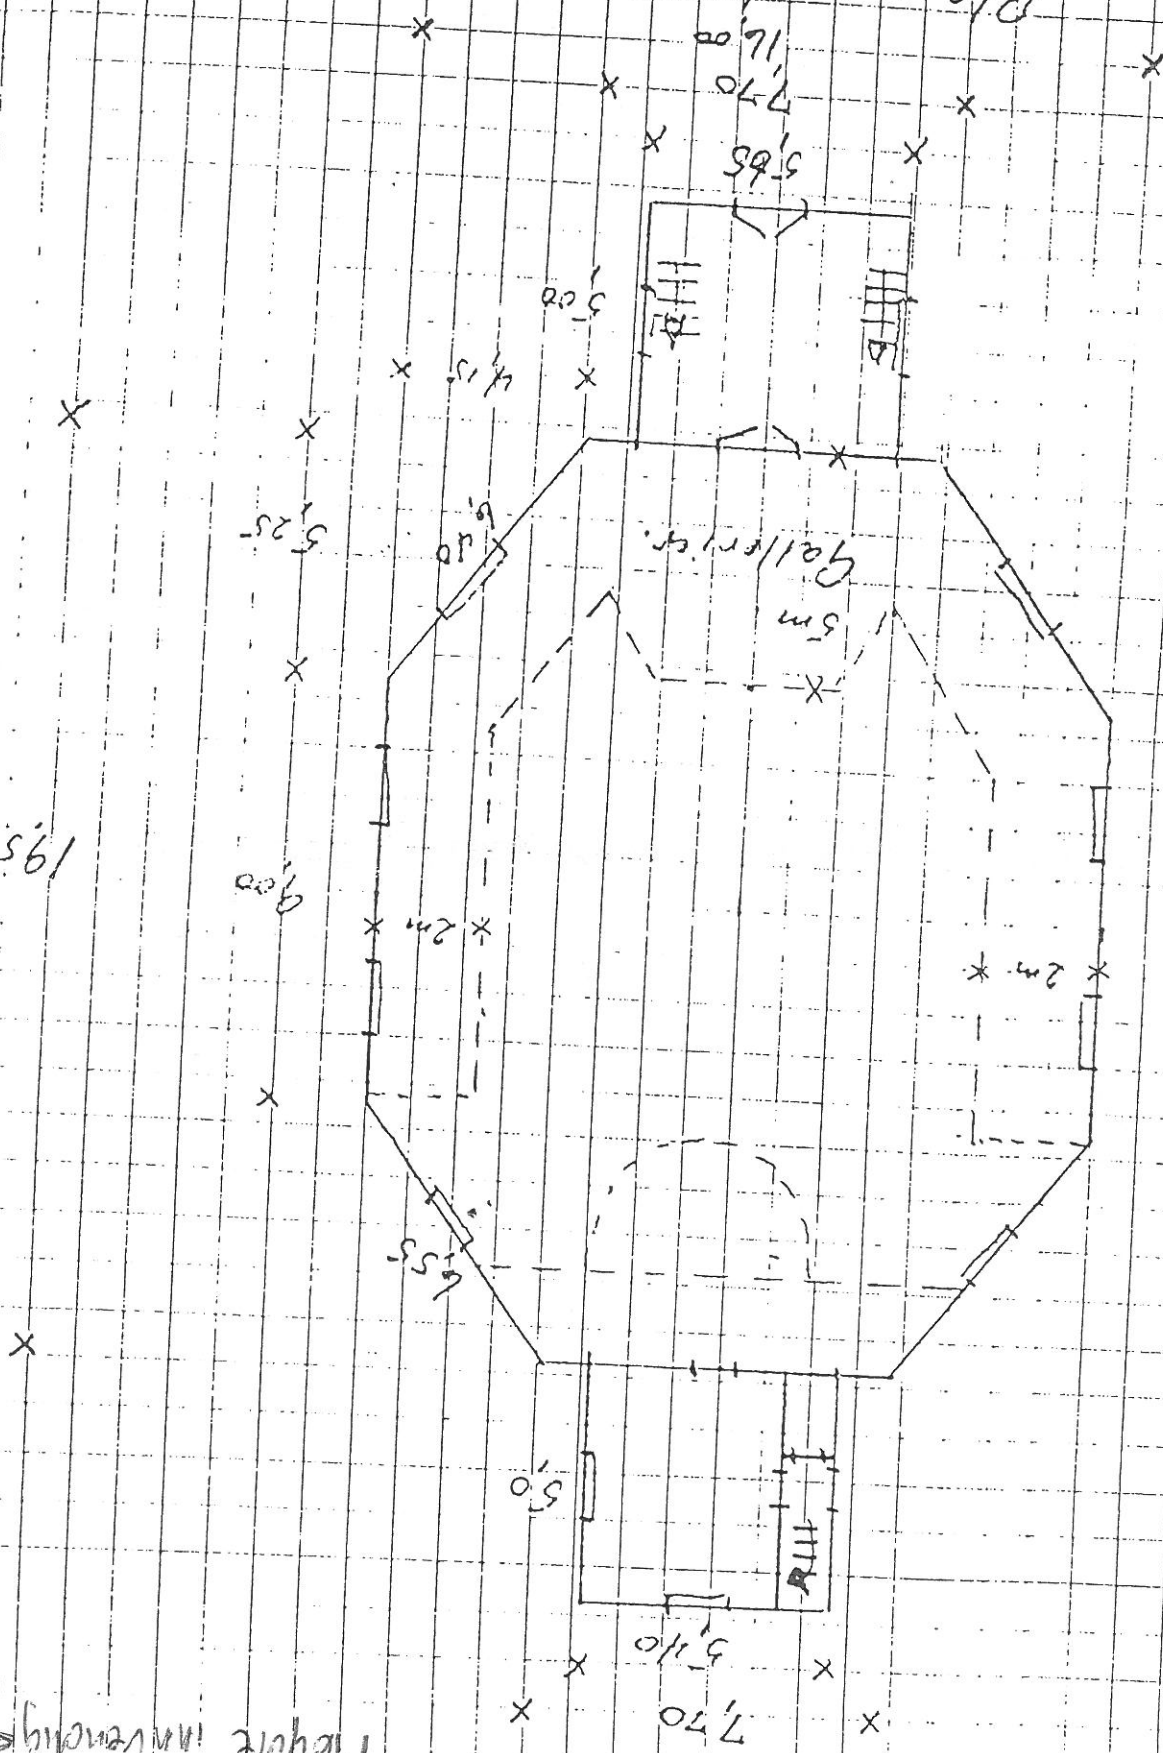

Tolga kerke - Joleflats - oversiktsskizze

