



SNITT A-A

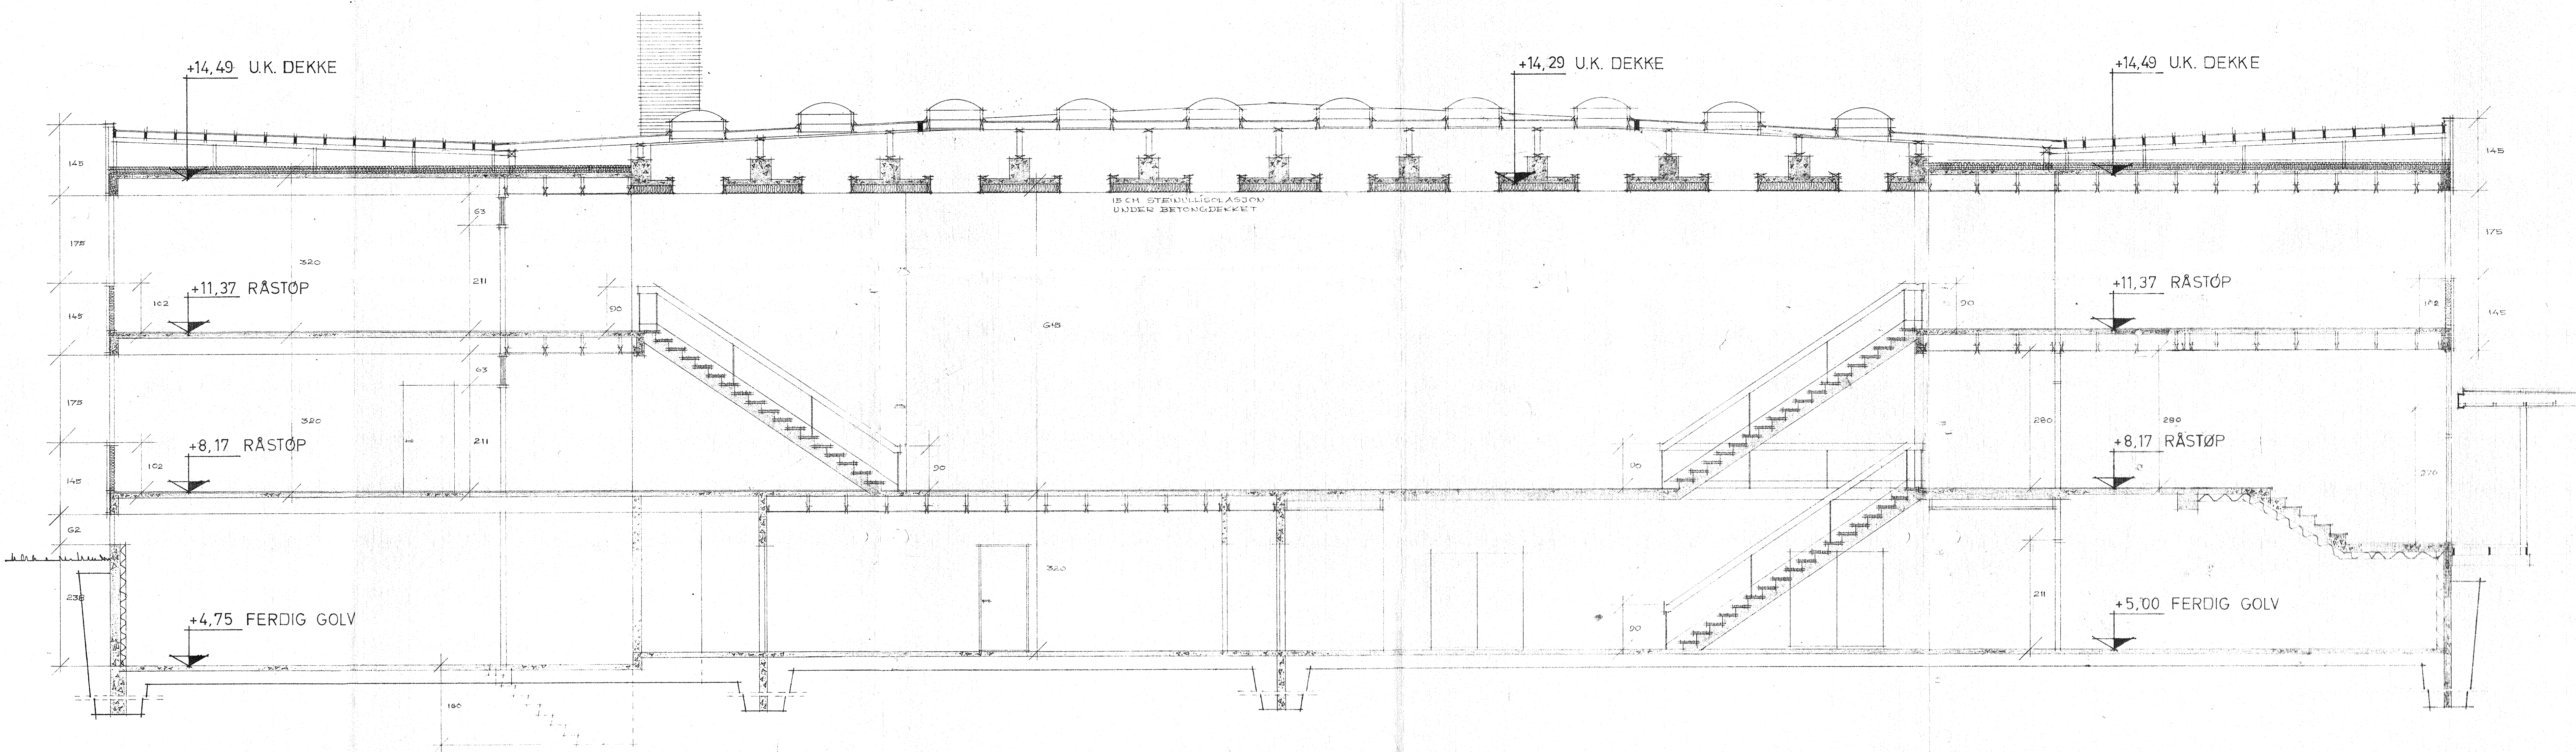

SNITT B-B

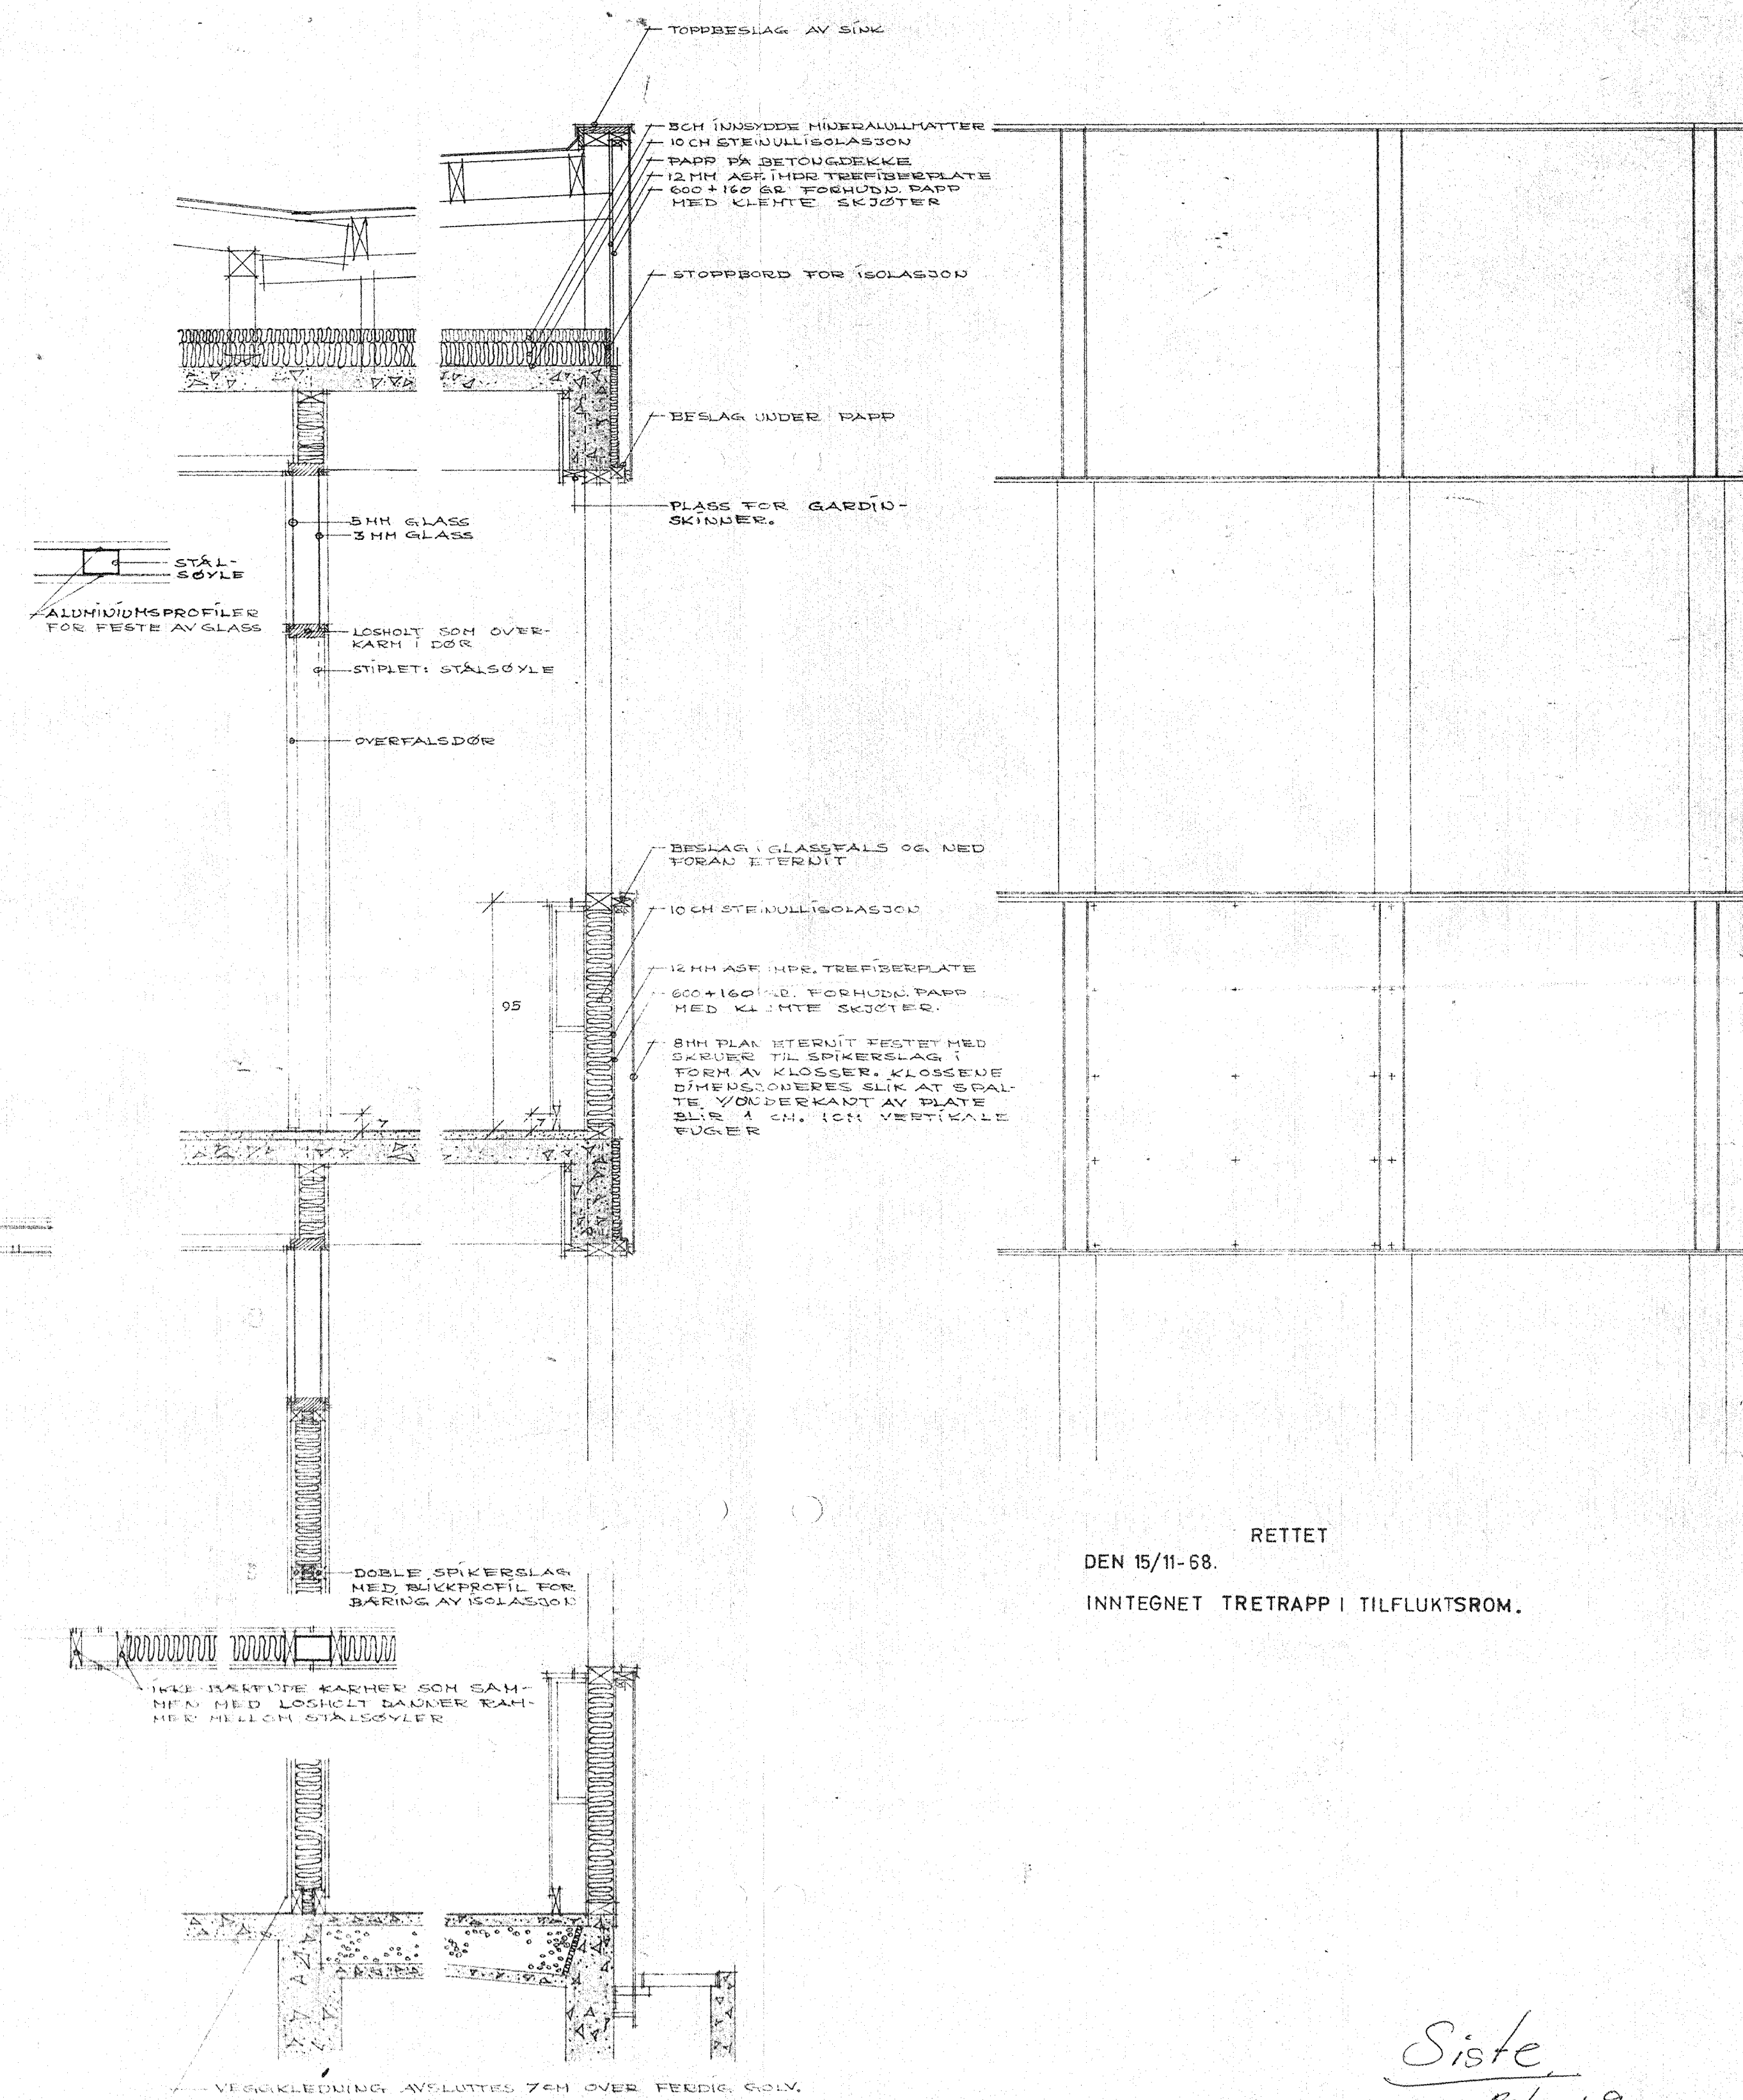

29 APR 1958	20 JUN 1958	3 JUN 1958	10 JUN 1958	18 JUN 1958	13 AUG 1958	2 SEP 1958	7 OKT 1958	10 OKT 1958	22 OKT 1958	23 OKT 1958	24 OKT 1958	17 FEB 1959	5 MAR 1959	11 MAR 1959	13 APR 1959	29 APR 1959
-------------	-------------	------------	-------------	-------------	-------------	------------	------------	-------------	-------------	-------------	-------------	-------------	------------	-------------	-------------	-------------

Siste
896-69
R.H.

62.52.304

VÅGÅN KOMMUNE SVOLVÅR.
KOMPAKTSKOLEN RÅ IDERTIPLESSED.
SUTT A-A OG B-B