



REV.	DESCRIPTION	DATE	BY	DATE
14223	15101BE33A	14.08.2024	Adnan	
			Checker	


Labflex
 15101BE33A
 14223_151_01_200_LABF_20_004

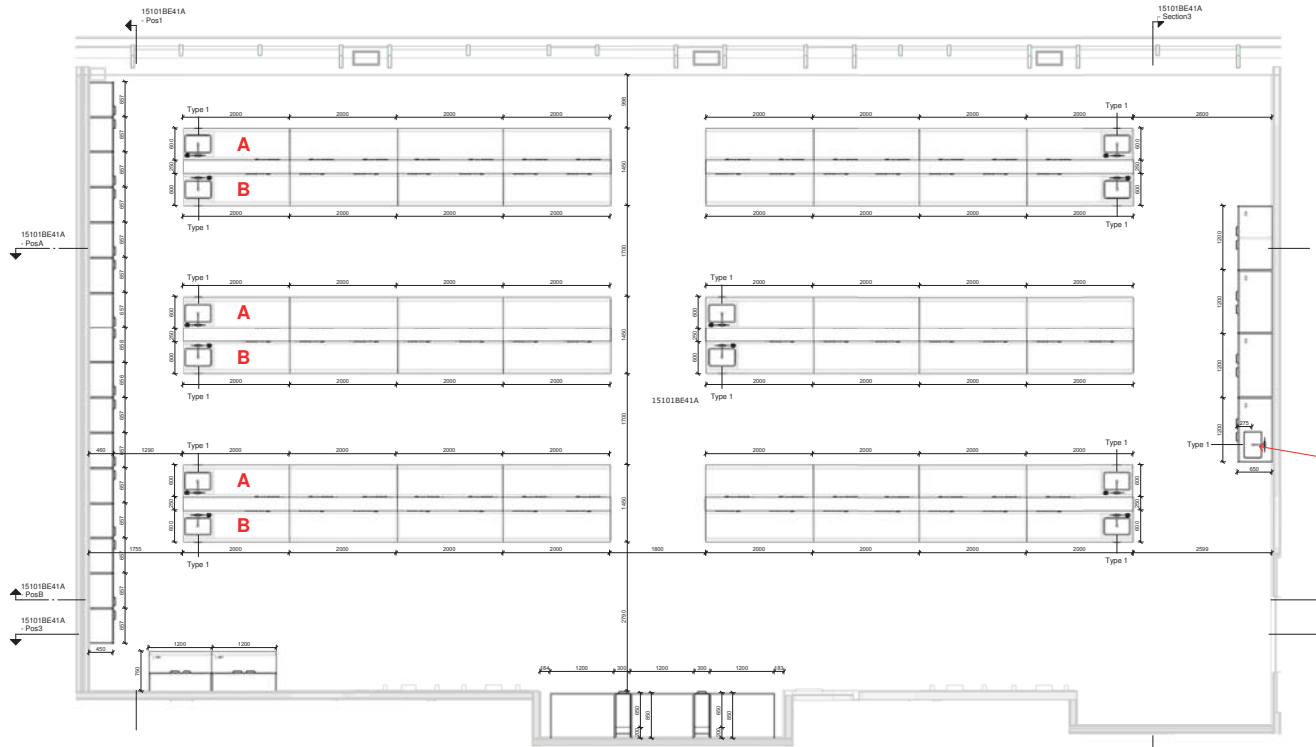


Plan - 15101BE41A
1:50

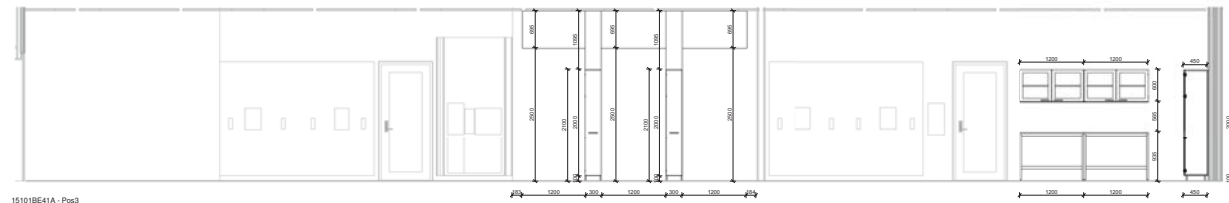


15101BE41A - Pos3
1:50

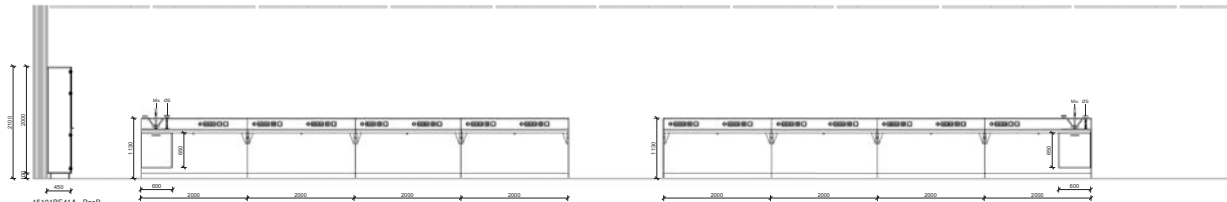


15101BE41A - PosB
1:50

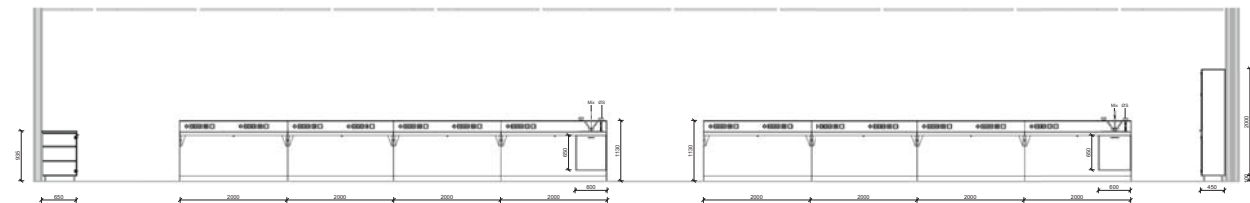


15101BE41A - PosA
1:50

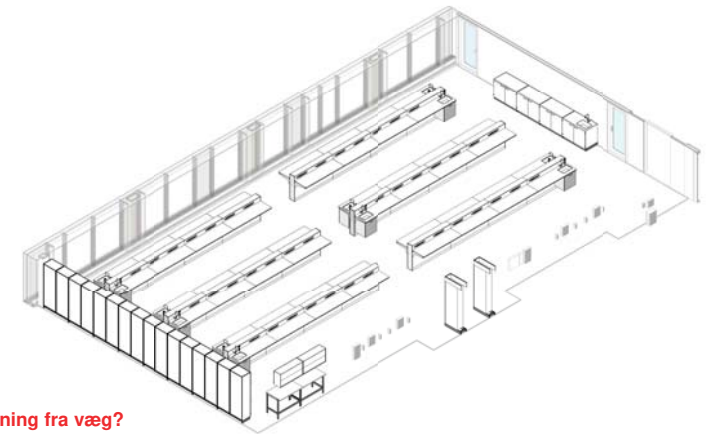

Forsyning fra væg?

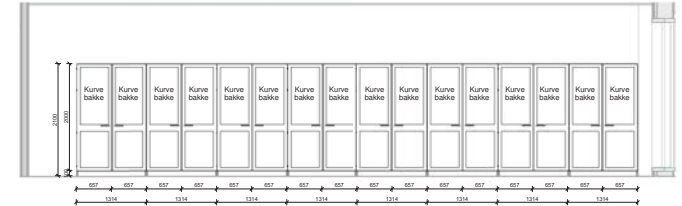

15101BE41A - Pos1
1:50

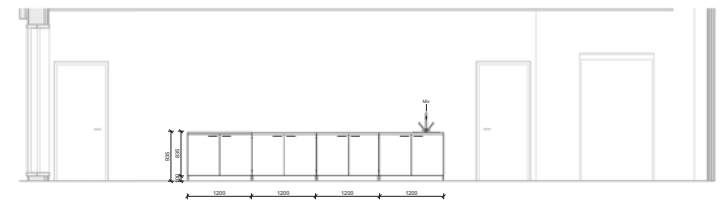

15101BE41A - Section0
1:50

2 bordplader istedet for 4?